



# HISTORY OF CONSTRUCTION

## HISTORY OF CONSTRUCTION

**Ash Pond 91 CCR Surface Impoundment  
Coal Creek Station  
Great River Energy**

**Submitted To:** Great River Energy  
Coal Creek Station  
2875 Third Street SW  
Underwood, North Dakota 58576

**Submitted By:** Golder Associates Inc.  
44 Union Boulevard, Suite 300  
Lakewood, Colorado 80228

**October 13, 2016**

**1649586**





## Table of Contents

1.0	INTRODUCTION.....	1
1.1	Purpose .....	1
1.2	Site Background .....	1
2.0	OWNER, OPERATOR, AND UNIT IDENTIFICATION (§257.73(C)(1)(I)).....	1
3.0	HISTORY OF CONSTRUCTION .....	1
3.1	Location of Unit (§257.73(c)(1)(ii)) .....	1
3.2	Purpose (§257.73(c)(1)(iii)) .....	2
3.3	Watershed Information (§257.73(c)(1)(iv)).....	2
3.4	Foundation Information (§257.73(c)(1)(v)).....	2
3.5	Materials and Site Preparation (§257.73(c)(1)(vi)).....	2
3.6	Detailed Dimensional Drawings (§257.73(c)(1)(vii)) .....	3
3.7	Instrumentation (§257.73(c)(1)(viii)).....	3
3.8	Area-Capacity Curves (§257.73(c)(1)(ix)).....	3
3.9	Spillways and Diversion Features (§257.73(c)(1)(x)).....	4
3.10	Construction Specifications and Provisions (§257.73(c)(1)(xi)) .....	4
3.11	Record of Structural Instability (§257.73(c)(1)(xii)) .....	4
4.0	CLOSING .....	5
5.0	REFERENCES.....	6

## List of Figures

Figure 1	Ash Pond 91 Site Location (USGS Topographic Maps)
Figure 2	Ash Pond 91 Site Location (Aerial Photograph)
Figure 3	Ash Pond 91 Area-Capacity Information

## List of Appendices

Appendix A	Design Drawings
Appendix A-1	Ash Pond 91 Design Drawings (CPA/UPA 1992)
Appendix A-2	Ash Pond 91 Permit Drawings (Golder 2015a)



## 1.0 INTRODUCTION

### 1.1 Purpose

Golder Associates Inc. (Golder) has prepared the following History of Construction for the Ash Pond 91 CCR Surface Impoundment (Ash Pond 91) at Great River Energy's (GRE's) Coal Creek Station (CCS). The Environmental Protection Agency's (EPA's) Coal Combustion Residual (CCR) Rule, 40 Code of Federal Regulations (CFR) Part 257, promulgated April 17, 2015 and effective October 19, 2015, requires compilation of the information specified in §257.73(c) to detail the construction history of CCR facilities no later than October 17, 2016 for facilities with either height of 5 feet or more and a storage volume of 20 acre-feet, or a height of more than 20 feet.

### 1.2 Site Background

Coal Creek Station is located in McLean County, approximately 10 miles northwest of Washburn, North Dakota. The lined Ash Pond 91 footprint comprises approximately 75 acres, and is used as a combined dewatering and storage facility for CCRs including fly ash, bottom ash, and flue-gas desulfurization (FGD) material.

## 2.0 OWNER, OPERATOR, AND UNIT IDENTIFICATION (§257.73(C)(1)(II))

Coal Creek Station (and Ash Pond 91) is currently owned and operated by Great River Energy (GRE).

Corporate Address:

Great River Energy  
12300 Elm Creek Boulevard  
Maple Grove, Minnesota 55369

Coal Creek Station Address:

Great River Energy  
Coal Creek Station  
2875 Third Street SW  
Underwood, North Dakota 58576

The North Dakota Department of Health (NDDH) Division of Waste Management is the environmental regulatory body for the CCR facilities at CCS. Ash Pond 91 is currently permitted with the North Dakota Department of Health (NDDH) under Permit Number 0033.

## 3.0 HISTORY OF CONSTRUCTION

### 3.1 Location of Unit (§257.73(c)(1)(ii))

Ash Pond 91 is located in the southwest ¼ of Section 16 and the southeast ¼ of Section 17 of Township 145 North, Range 82 West, in McLean County, North Dakota. Figure 1 shows the location of Ash Pond 91



on the most recent USGS topographic map, and Figure 2 shows the location of Ash Pond 91 on a recent aerial photograph.

### **3.2 Purpose (§257.73(c)(1)(iii))**

Ash Pond 91 is used as a combined dewatering and storage facility for CCRs including fly ash, bottom ash, and flue-gas desulfurization (FGD) material and will be closed with CCR materials in place.

### **3.3 Watershed Information (§257.73(c)(1)(iv))**

The Ash Pond 91 CCR surface impoundment is located within the following Hydrologic Unit (Watershed-Based Performance Management Using Hydrologic Unit, ND 2016) per the Natural Resources Conservation Service (NRCS): Hydrologic Unit 12 Subwatershed 101301010701 Weller Slough-Coal Lake Coulee (40,582 acres).

### **3.4 Foundation Information (§257.73(c)(1)(v))**

The location of Ash Pond 91 was originally characterized by Burns & McDonnell in 1973. A geotechnical investigation was completed by Black & Veatch in 1977 and a hydrogeologic study was performed for CCS by Barr Engineering in 1982. Site geology, soils, and hydrology, including drainage and surface water flow, were examined during these prior studies to determine site suitability for disposal of CCRs. Foundation soils consist of existing natural soils and are generally classified as lean clays, clayey sands, and fat clays. Sandy lean clays dominant the existing natural soils with an effective cohesion of 500 pounds per square foot (psf) and an effective friction angle of 19 degrees (based on shear strength testing).

The foundation soils of Ash Pond 91 consist of native soils (lean clays, clayey sands, and fat clays) and embankment fill materials sourced from nearby native soils (lean clays, clayey sands, and fat clays). Ash Pond 91 was cleaned out, deepened, and relined in 1993 (CPA 1993). According to the 1993 construction report, the foundation materials were compacted in 12-inch lifts to 93% standard Proctor density.

### **3.5 Materials and Site Preparation (§257.73(c)(1)(vi))**

Ash Pond 91 was originally part of the South Ash Pond, which was built in the late 1970s on a foundation of re-compacted site soils (glacial tills) and put into service in 1979. In 1981, the South Ash Pond was taken out of service to reconstruct the clay liner and was put back into service from 1982 until 1987, at which point CCR materials were removed. The South Ash Pond was then divided into Ash Pond 91 and Ash Pond 92 in 1988. Ash Pond 91 was deepened and a new composite liner consisting of a 2-foot thick compacted clay liner underlying a 40-mil high-density polyethylene (HDPE) geomembrane was completed in 1993. The 2-foot thick compacted clay liner was compacted in six-inch loose lifts at 95% of the standard Proctor compaction effort. The liner is overlain with 1 foot of sand, 1 foot of Pit Run gravel, and a drainage system consisting of collection pipes that generally slope to the north side of the facility.





Construction began in 2015 to allow for the vertical containment of CCR materials over the Ash Pond 91 footprint. This included the installation of a composite liner consisting of a geosynthetic clay liner (GCL) overlain with a 60-mil HDPE liner in the areas between Ash Pond 91 and the Upstream Raise CCR Surface Impoundment (Upstream Raise).

It is anticipated that Ash Pond 91 will continue to operate as a surface impoundment receiving sluiced FGD material and dry CCR materials (fly ash and bottom ash) until approximately 2028. After the sluiced FGD material reaches its design height, free liquid in the sluiced FGD material will begin to drain and Ash Pond 91 will only receive dry CCR materials in the construction of a cap/crown until approximately 2031.

During active placement of CCR materials in Ash Pond 91, FGD material will be sluiced directly to Ash Pond 91. Dewatered bottom ash and dry fly ash are hauled by truck to Ash Pond 91. Bottom ash is used as a perimeter drainage layer and fly ash around the perimeter provides an erosion and trafficking surface on the exterior of the facility. Both bottom ash and fly ash are trafficked and spread using dozers. Material properties information of CCR materials used in construction of Ash Pond 91 are presented under separate cover in the Hazard Potential Classification Assessment, Structural Stability Assessment, and Safety Factor Assessment Report (Golder 2016a).

### **3.6 Detailed Dimensional Drawings (§257.73(c)(1)(vii))**

Permit drawings for Ash Pond 91 (CPA/UPA 1992 and Golder 2015a) are included in Appendix A and show facility dimensions, drainage pathways, and facility surroundings.

Ash Pond 91 operates with a minimum freeboard of approximately 3 feet and a design freeboard of approximately 6-feet. A run-on analysis was performed as part of the inflow design flood control system plan (Golder 2016b) indicating that Ash Pond 91 is operated with adequate freeboard to contain the 24-hour, 100-year storm event.

### **3.7 Instrumentation (§257.73(c)(1)(viii))**

There is currently no instrumentation within Ash Pond 91.

### **3.8 Area-Capacity Curves (§257.73(c)(1)(ix))**

Elevation-area-capacity information is shown in Figure 3. Areas were calculated using as-built topography and design grades. Above the elevation of the original soil berms of Ash Pond 91, the area of the facility becomes smaller with increasing elevation. CCR capacities are approximate and were calculated using an average end area method.



### 3.9 Spillways and Diversion Features (§257.73(c)(1)(x))

There are no spillways associated with Ash Pond 91. Existing controls are in place to monitor water levels in Ash Pond 91 and limit potential overtopping of the impoundment. The only inflow to the facility (besides precipitation) may include hydraulically conveyed coal rejects and FGD material. The design crest of the soil perimeter berms surrounding Ash Pond 91 are at an approximate elevation of 1922 feet, which is approximately 24 feet above surrounding topography, preventing stormwater run-on into Ash Pond 91.

Existing controls in place to monitor the water levels in Ash Pond 91 include weekly observations of water levels by CCS personnel, and daily observations by CCS operations personnel. Additional observations are noted by GRE employees familiar with site CCR units. After large storm events, CCS personnel evaluate site conditions, including impoundment water levels, and are able to adjust operations to maintain water levels below design maximum elevations. Should water levels within Ash Pond 91 reach above desired operating levels during FGD material deposition, GRE has operating procedures to lower gravity drain (decant) pipelines into the water to transfer water to the adjacent Drains Pond CCR Surface Impoundment (Drains Pond System). Contact water in perimeter ditches flows passively from Ash Pond 91 to the Drains Pond System.

### 3.10 Construction Specifications and Provisions (§257.73(c)(1)(xi))

The following documents contain the specifications, construction quality assurance reports, and provisions for operation of Ash Pond 91.

- The final report for the foundation, liner, and embankment construction completed in 1993 on Ash Pond 91 (CPA 1993).
- The geomembrane quality assurance services documentation performed in 1993 on Ash Pond 91 (Golder 1993).
- The operations plan for Ash Pond 91, Ash Pond 92, and Section 16 (Golder 2015b).
- The geosynthetics material specifications for the liner construction performed on the 2016 Ash Pond 91 Upstream Raise Construction (Golder 2016c).
- The geosynthetics installation specifications for the liner construction performed on the 2016 Ash Pond 91 Upstream Raise Construction (Golder 2016d).
- The construction specifications for the foundation, liner, and embankment construction performed on the 2016 Ash Pond 91 Upstream Raise Construction (Golder 2016e).

### 3.11 Record of Structural Instability (§257.73(c)(1)(xii))

No record of structural instability has been noted for Ash Pond 91. Weekly Inspections are performed by site personnel and annual inspections are performed by a registered professional engineer.



#### 4.0 CLOSING

Golder Associates Inc. has prepared the above History of Construction for the Ash Pond 91 CCR surface impoundment at Great River Energy's Coal Creek Station. Based on our review of the available information, to the extent feasible, this report provides the information required by 40 CFR §257.73(c)(i) through (xii), as related to the construction of the Ash Pond 91 CCR surface impoundment.

#### GOLDER ASSOCIATES INC.

Todd Stong, PE  
Senior Engineer/Associate

TS/CS/rjg

Craig Schuettpeiz, PE  
Senior Project Engineer



## 5.0 REFERENCES

- Barr. 1982. *Seepage and Stability Analysis*. Prepared for Cooperative Power Association. February.
- Black & Veatch. 1978. *South Ash Pond Geotechnical Data*. March.
- Burns & McDonnell. 1973. *Report on the Environmental Analysis for a North Dakota Power Supply Project*. July.
- CPA. 1993. *Cooperative Power Association Final Construction Report – Evaporation Pond 93 and Ash Pond 91*.
- CPA/UPA. 1992. *Cooperative Power Association, United Power Association – 1992 Ash Disposal Drawings, Issued for Bid*. January.
- EPA 2015. Environmental Protection Agency, Code of Federal Regulations Title 40 Parts 257: Hazardous and Solid Waste Management System; *Disposal of Coal Combustion Residuals from Electric Utilities*. April.
- Golder. 1993. *Geomembrane Quality Assurance Services – Ash Pond 91 and Drains Pond*. November.
- Golder. 2015a. *Permit Modification Document (Ash Pond 91 Upstream Raise)*, Permit No. SP-033. February.
- Golder. 2015b. *Operations Plan for Ash Pond 91, Ash Pond 92, and Section 16* Permit No. SP-033, Revision 4. February.
- Golder. 2016a. *Hazard Potential Classification, Structural Stability, and Safety Factor Assessments, Ash Pond 91 CCR Surface Impoundment*. October.
- Golder. 2016b. *Inflow Design Flood Control System Plan, Ash Pond 91 CCR Surface Impoundment*. October.
- Golder. 2016c. *Geosynthetics Material Specifications for Great River Energy Coal Creek Station 2016 Ash Pond 91 Upstream Raise Construction*. June.
- Golder. 2016d. *Geosynthetics Installation Specifications for Great River Energy Coal Creek Station 2016 Ash Pond 91 Upstream Raise Construction*. June.
- Golder. 2016e. *Construction Specifications for Great River Energy Coal Creek Station 2016 Ash Pond 91 Upstream Raise Construction – Earthworks*. July.
- ND. 2016. *North Dakota Hub Explorer*, North Dakota Geographic Information Systems. Retrieved: September 30, from <https://www.nd.gov/itd/statewide-alliances/gis>.

## FIGURES





#### REFERENCES


1. TOPOGRAPHIC MAP WAS COMPILED FROM THE FOLLOWING USGS 7.5 MINUTE TOPOGRAPHIC QUADRANGLES:  
 UNDERWOOD, NORTH DAKOTA (2014)  
 WASHBURN NE, NORTH DAKOTA (2014)  
 WASHBURN, NORTH DAKOTA (2014)  
 WASHBURN SW, NORTH DAKOTA (2014)





**GREAT RIVER ENERGY**  
**ASH POND 91 SITE LOCATION (USGS TOPOGRAPHIC MAPS)**

**FIGURE 1**



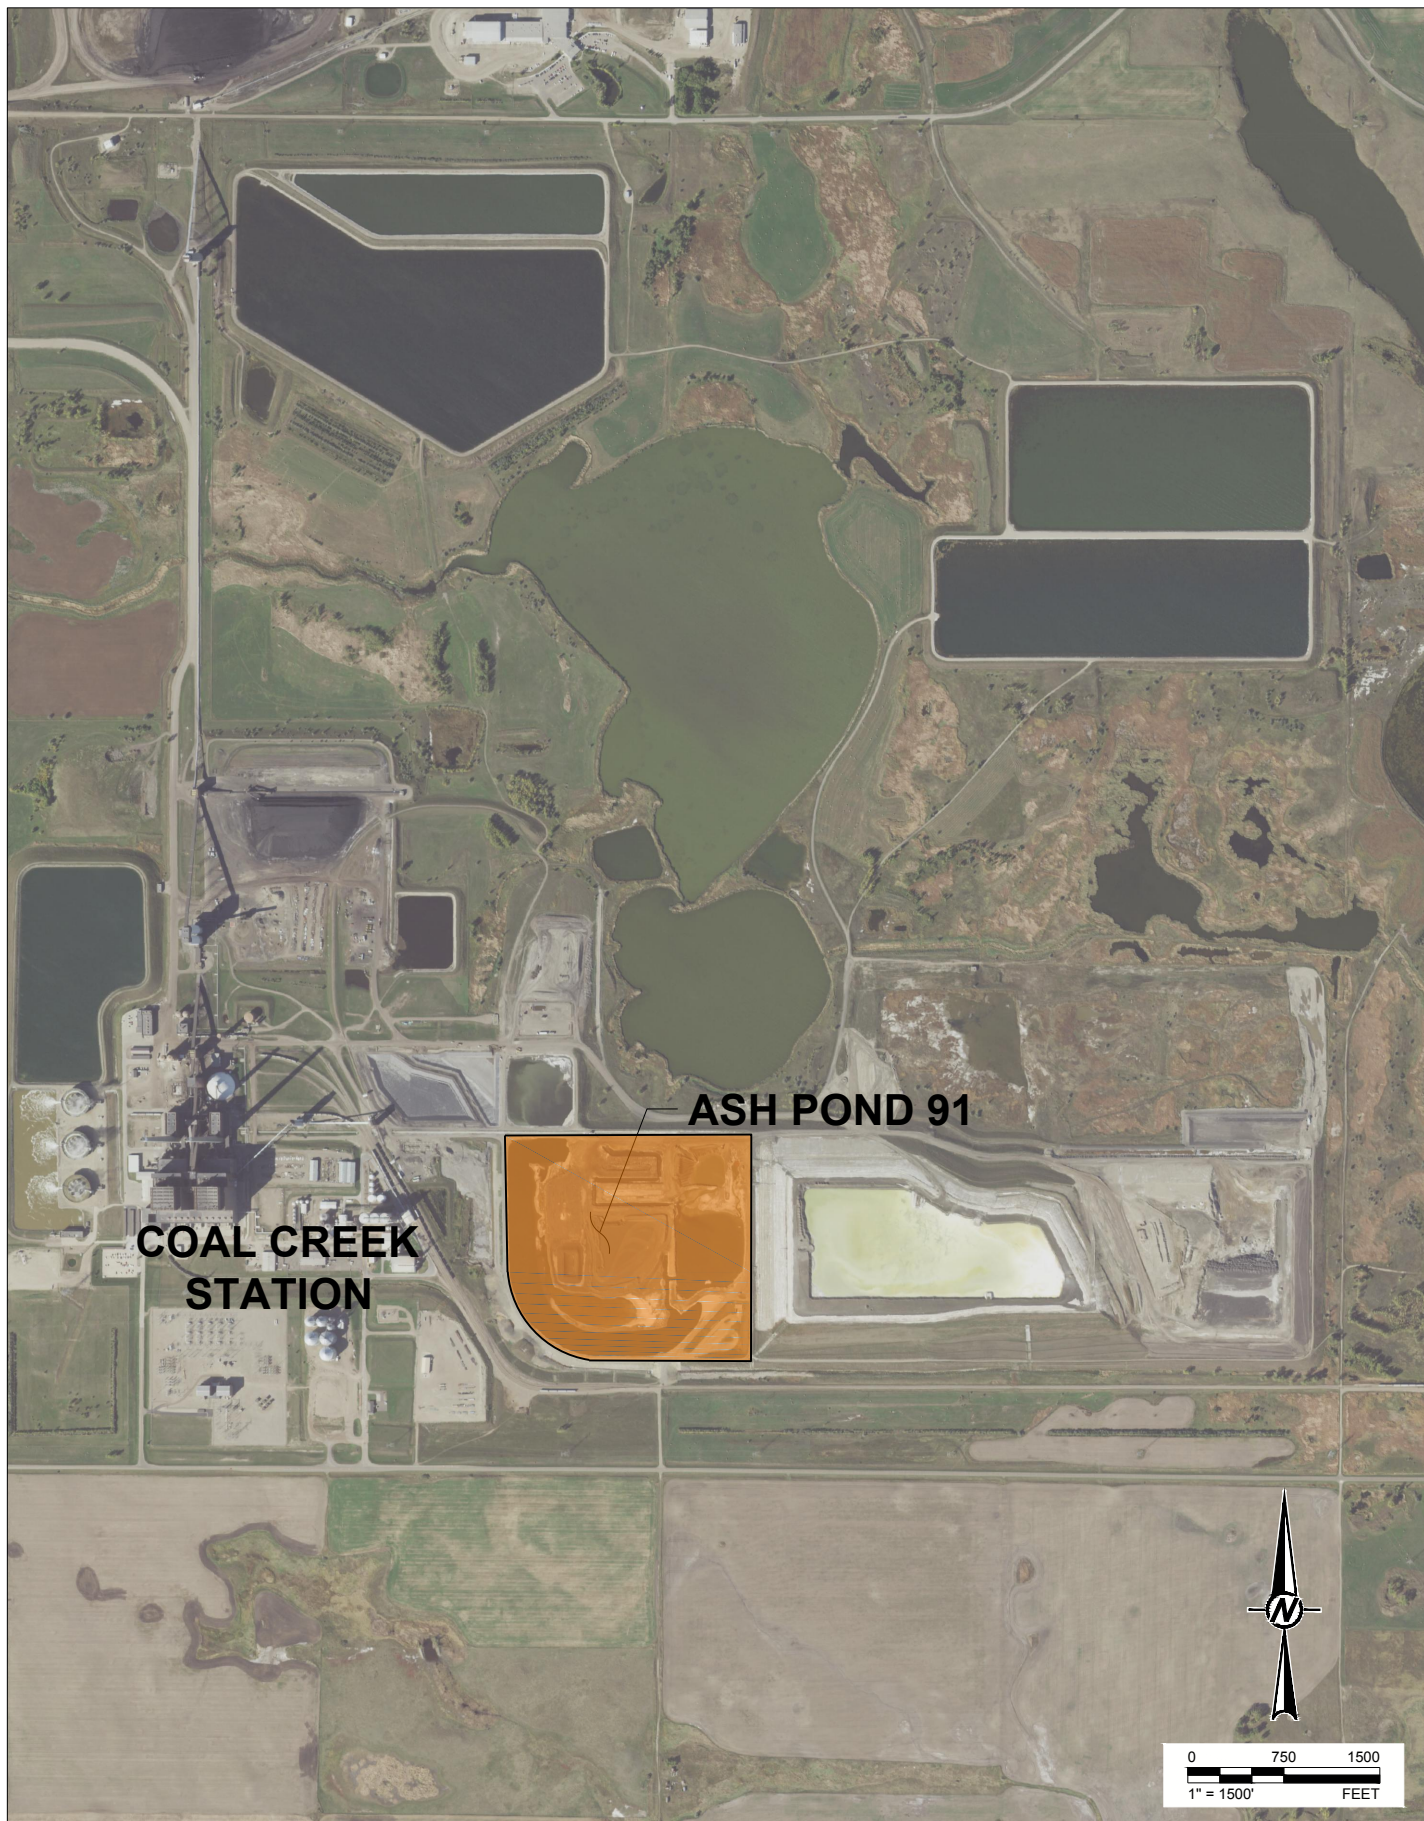

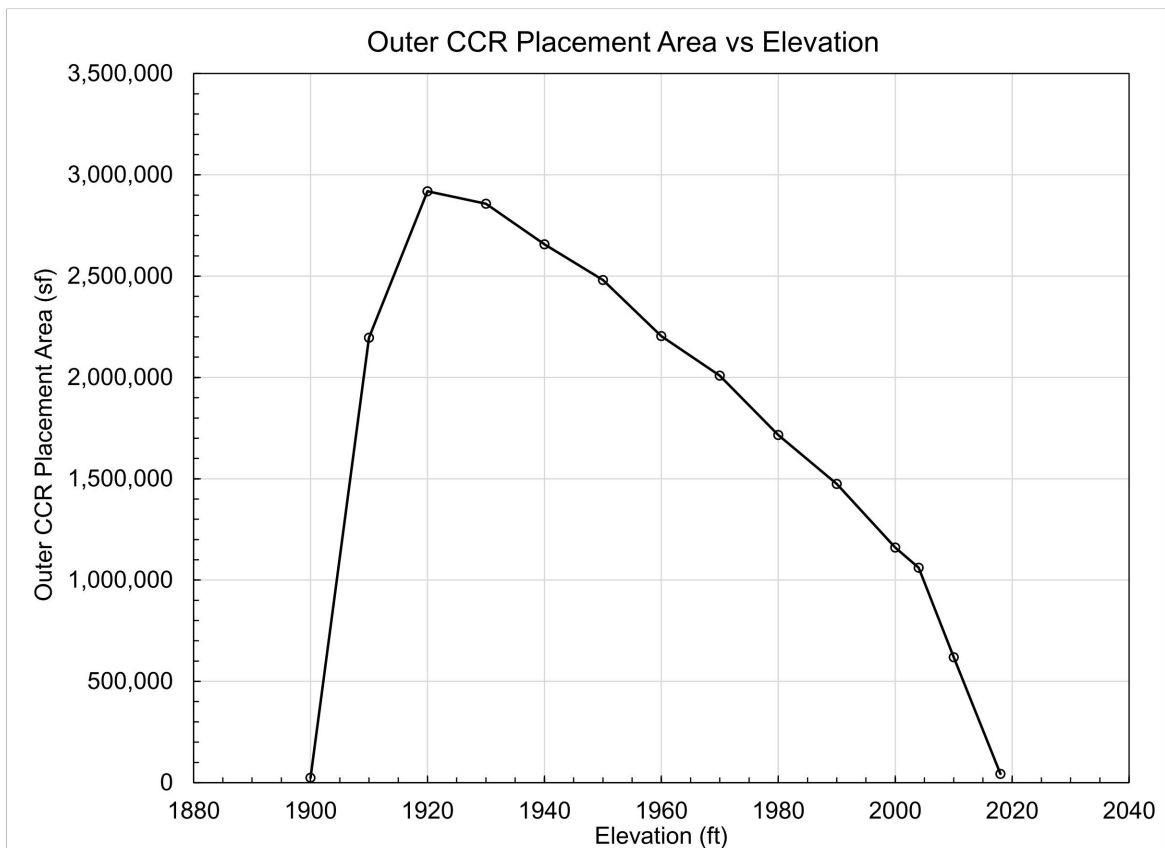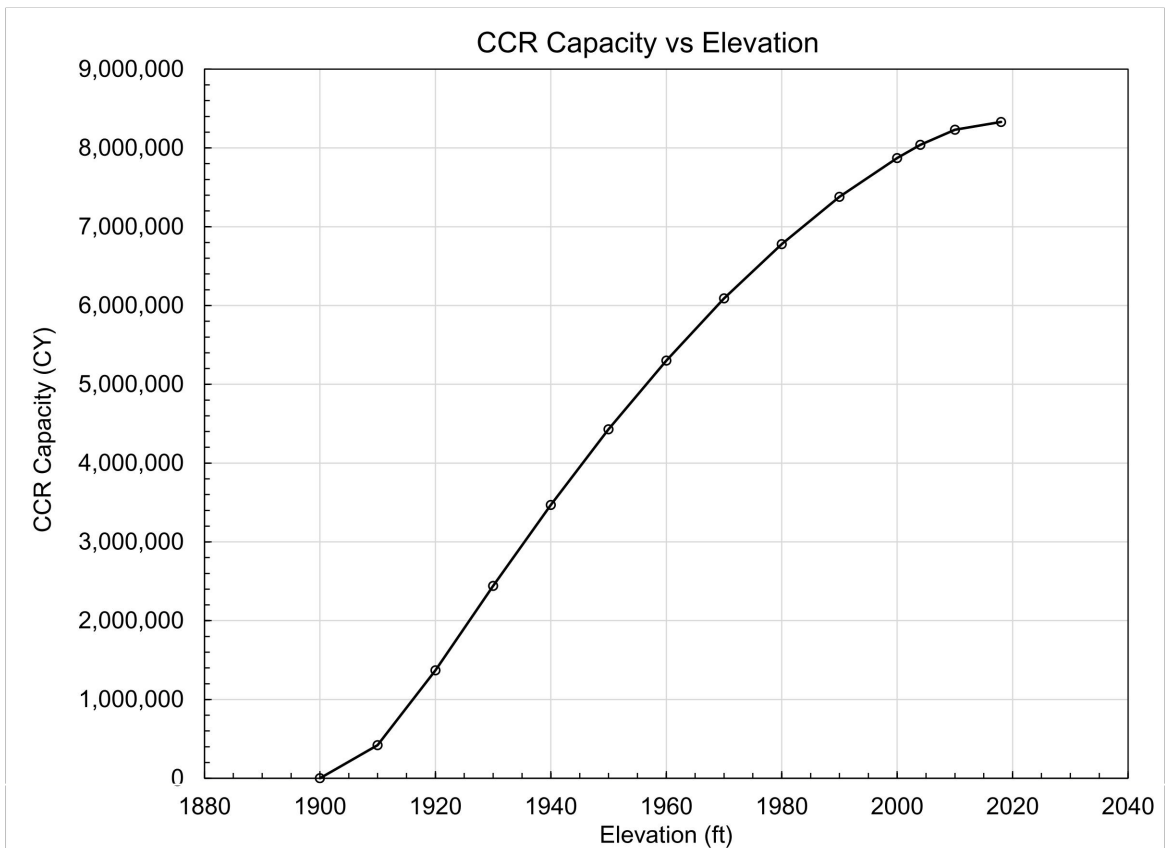



**APPENDIX A**  
**DESIGN DRAWINGS**


APPENDIX A-1  
ASH POND 91 DESIGN DRAWINGS (CPA/UPA 1992)

# COOPERATIVE POWER ASSOCIATION UNITED POWER ASSOCIATION


## COAL CREEK STATION UNDERWOOD, NORTH DAKOTA

COOPERATIVE POWER ASSOCIATION  
14615 LONE OAK ROAD  
EDEN PRAIRIE, MINNESOTA 55344

UNITED POWER ASSOCIATION  
HIGHWAY 10  
ELK RIVER, MINNESOTA 55330

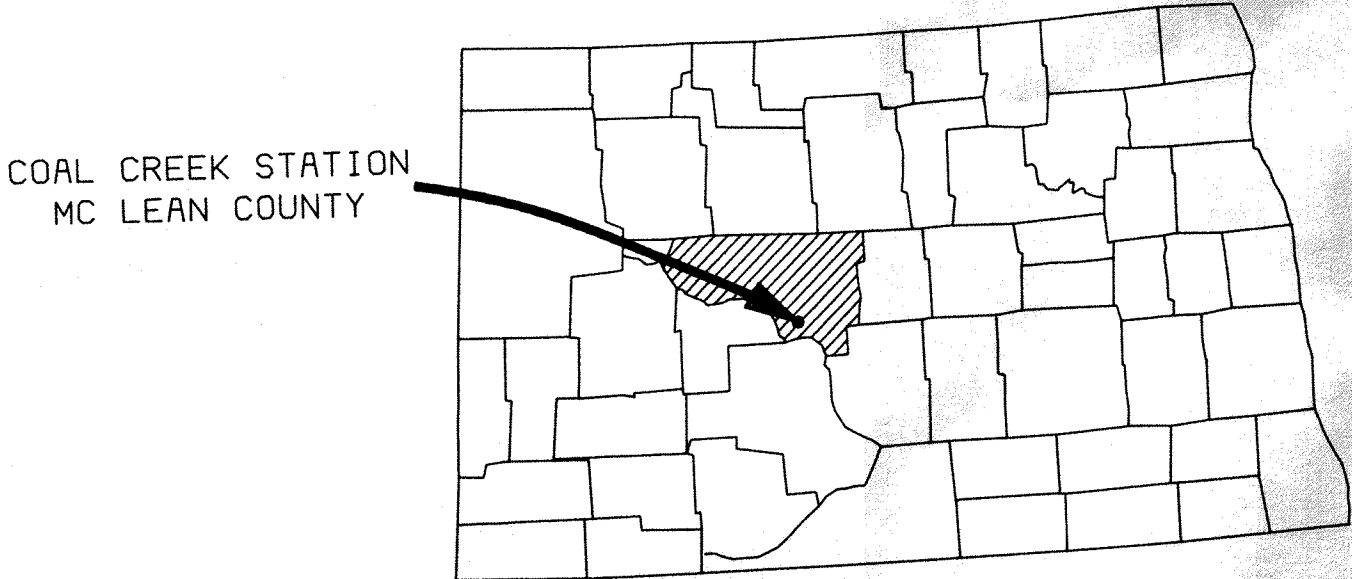

NORTH DAKOTA

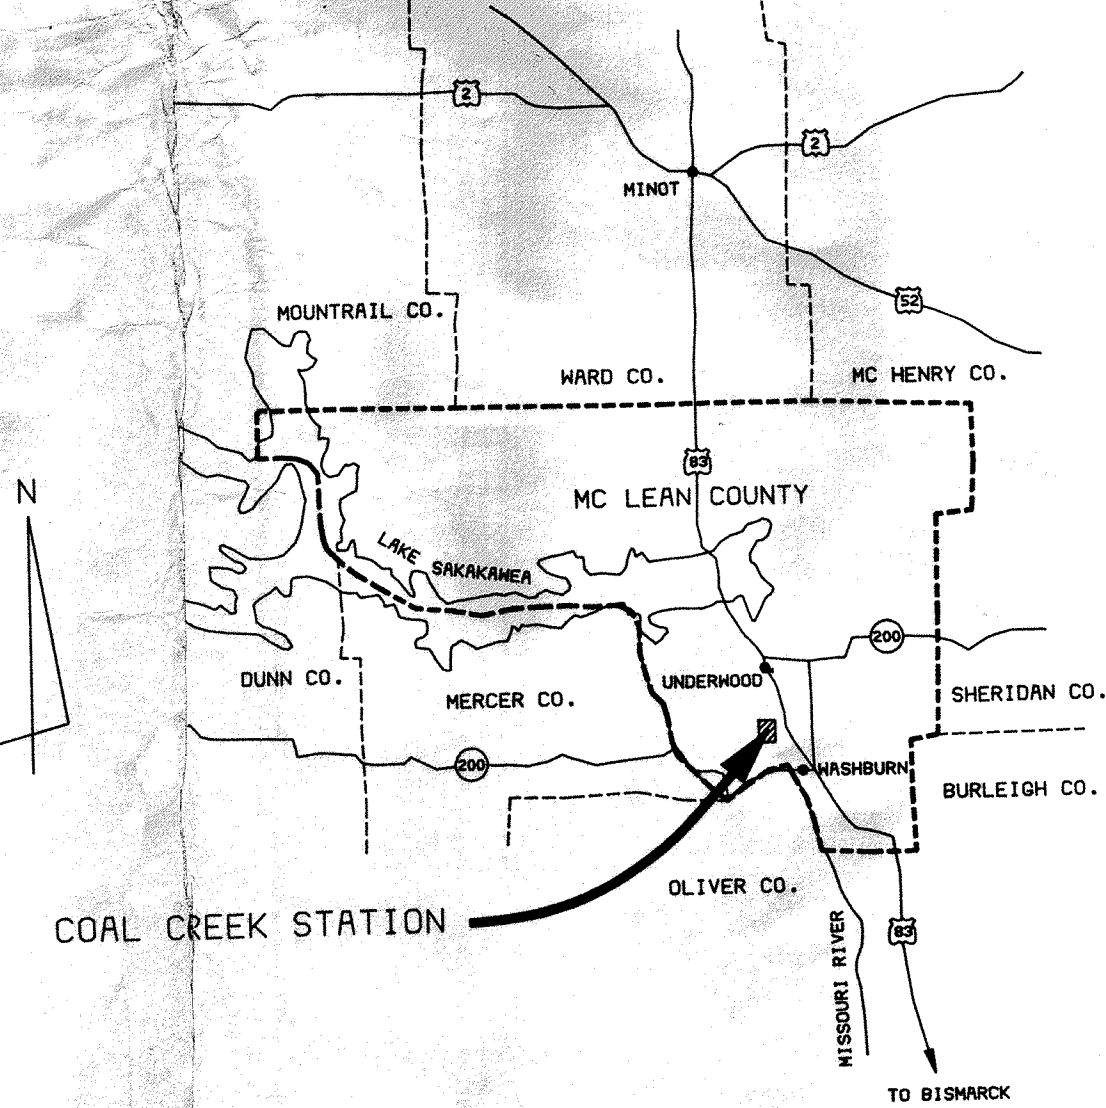

SITE LOCATION MAP

DRAWING NO.	DRAWING TITLE
92G213-1	EXISTING GROUND EVAPORATION POND 93
92G213-2	LAYOUT - TOP OF SUBGRADE EVAPORATION POND 93
92G213-3	LAYOUT - TOP OF BROWN CLAY EVAPORATION POND 93
92G213-4	LAYOUT - TOP OF GRAY CLAY EVAPORATION POND 93
92G213-5	LAYOUT - TOP OF SAND EVAPORATION POND 93
92G213-6	LAYOUT - TOP OF BOTTOM ASH EVAPORATION POND 93
92G213-7	EXISTING GROUND ASH POND 91
92G213-8	LAYOUT - TOP OF SUBGRADE ASH POND 91
92G213-9	LAYOUT - TOP OF BROWN CLAY ASH POND 91
92G213-10	LAYOUT - TOP OF GRAY CLAY ASH POND 91
92G213-11	LAYOUT - TOP OF SAND ASH POND 91
92G213-12	LAYOUT - TOP OF ROCK ASH POND 91
92G213-13	LAYOUT - TOP OF BOTTOM ASH ASH POND 91
92G213-14	LAYOUT - DRAIN SYSTEM ASH POND 91
92G213-15	PIPE ROUTING ALONG POND 94 TO POND 93
92G213-16	TYPICAL SECTIONS AND DETAILS
92G213-17	TYPICAL SECTIONS AND DETAILS
92G213-18	PLAN VIEW-EVAP. POND 92 OUTLET & SEWAGE LINE DETAIL
92G213-19	DETAILS MISCELLANEOUS
92G213-20	DEWATERING, PERFORATED PIPE DETAILS


FOR BID ONLY

PROJECT TITLE:  
1992 ASH DISPOSAL

WORKORDER NO.:  
92G213

Plant  
Drain  
Pond 91

# Ash Pond 91 Existing Ground

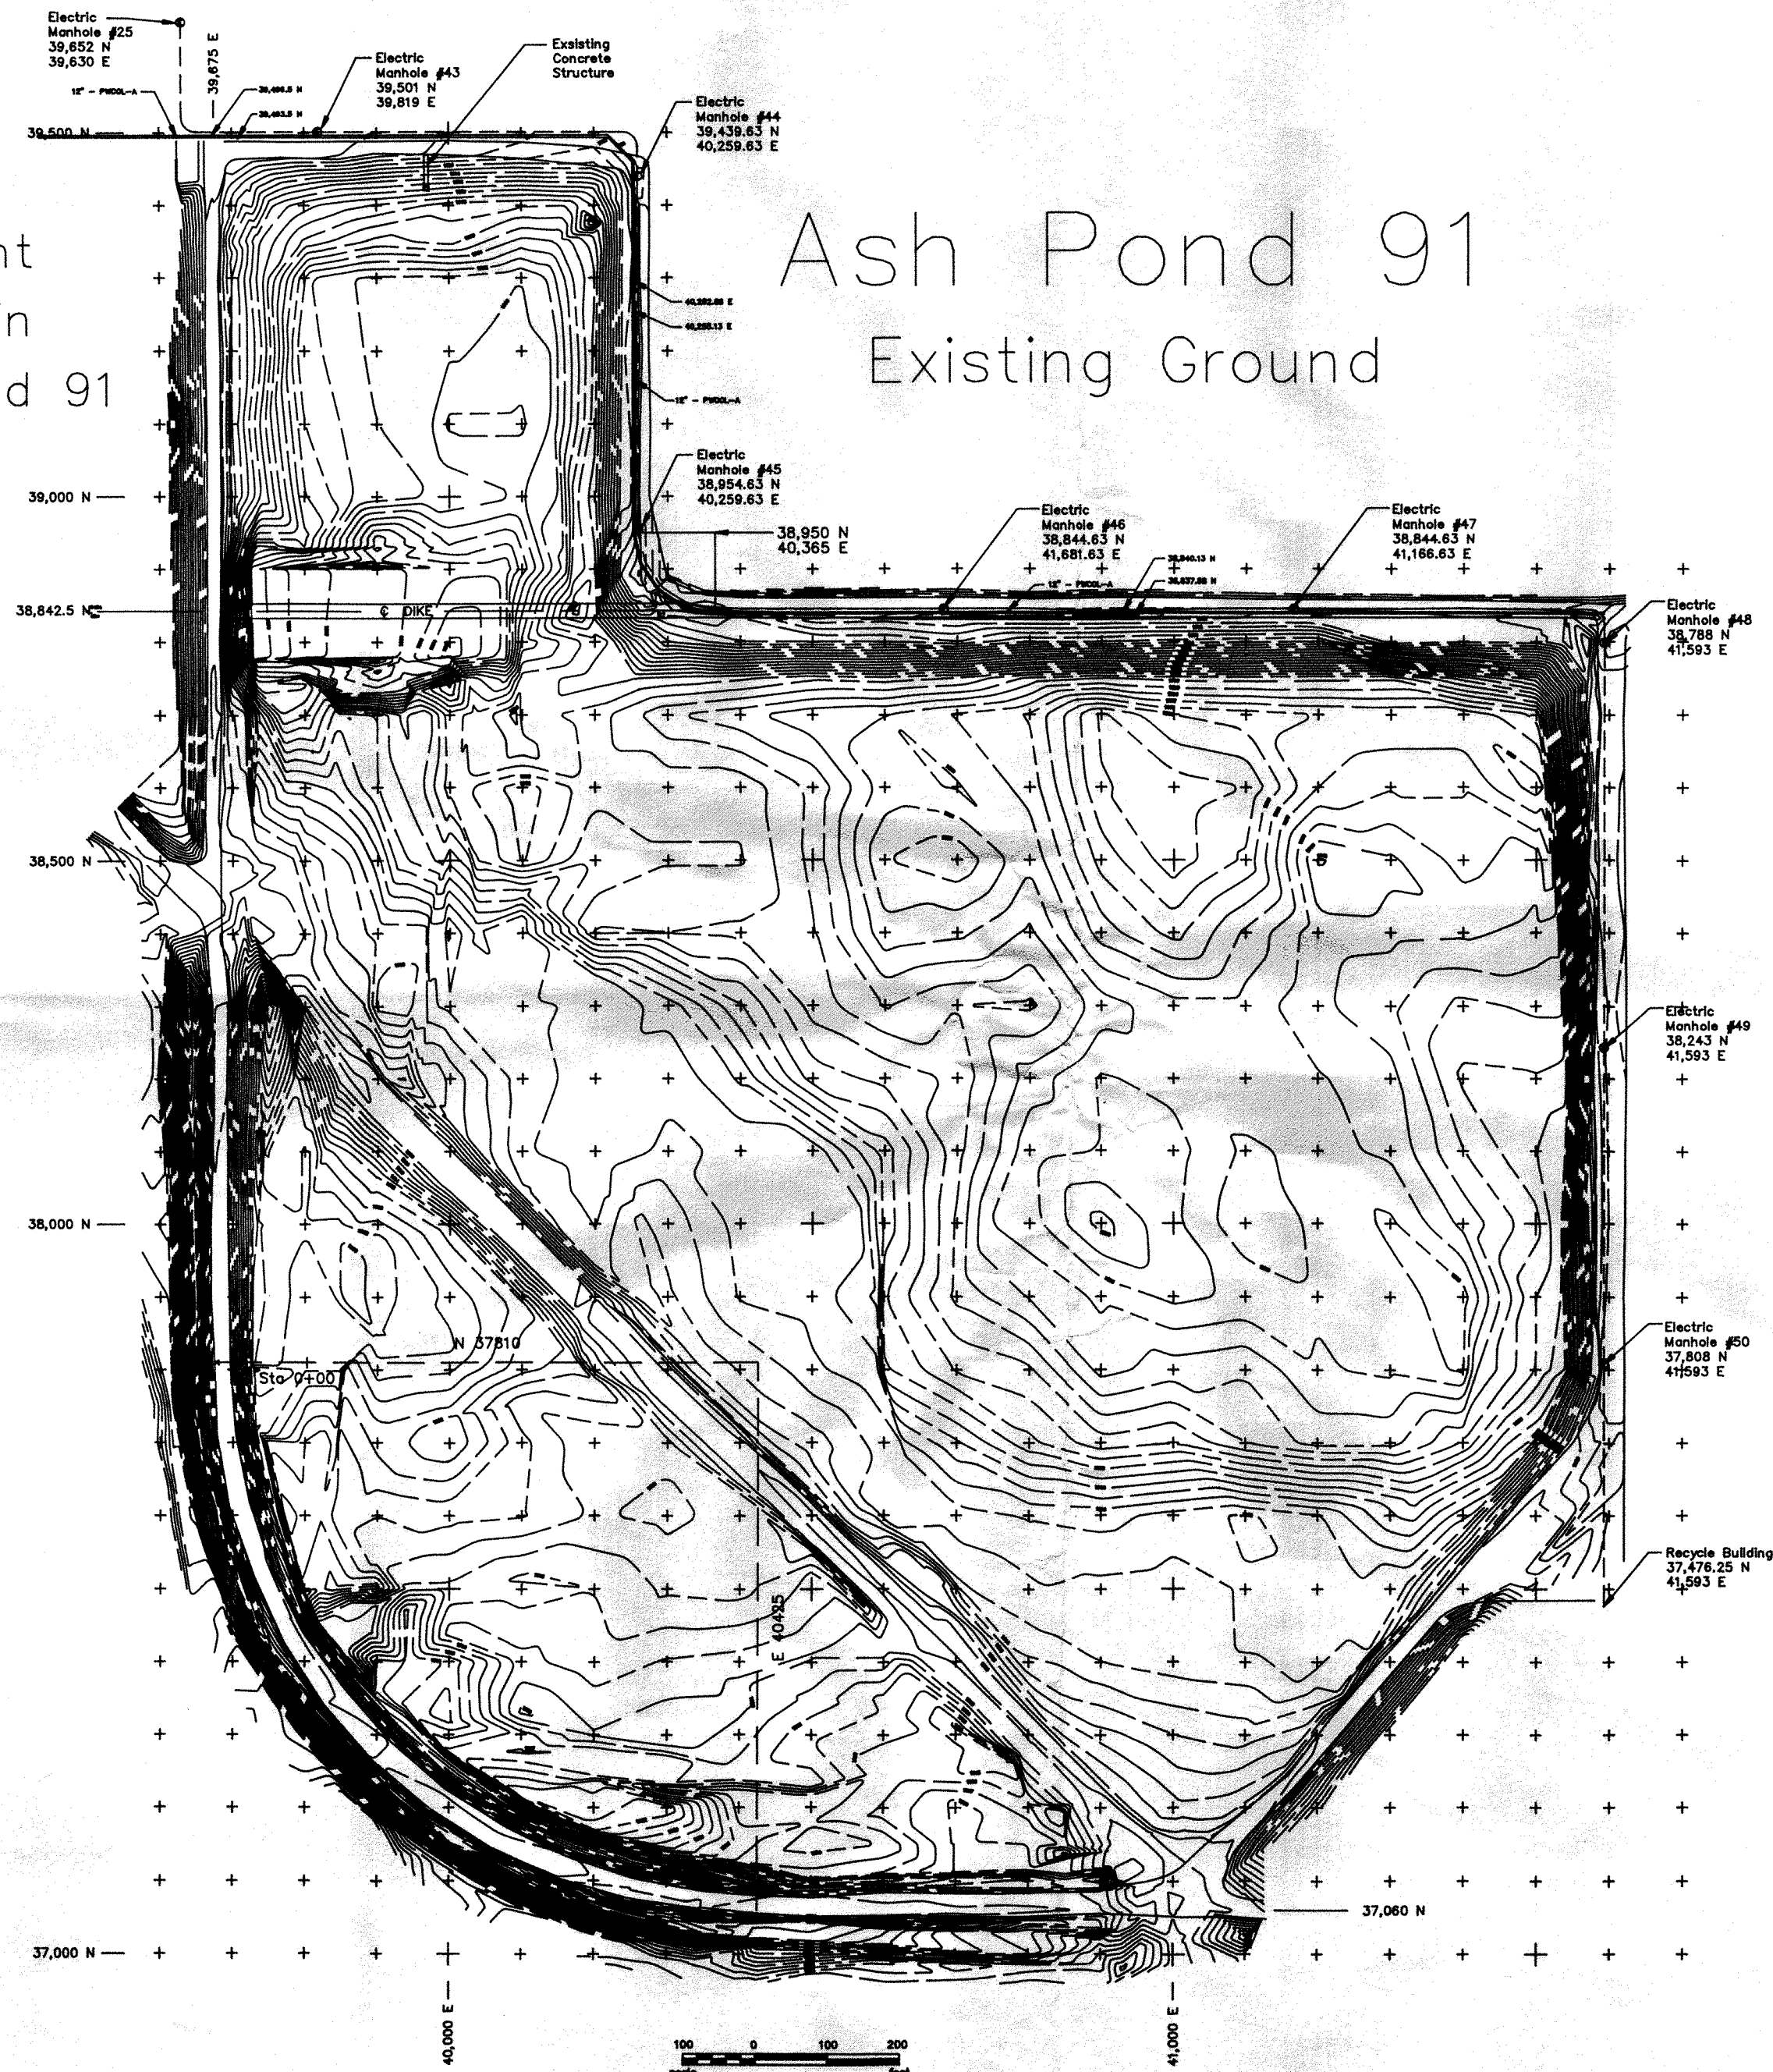

- 2 12,000 C.Y. OF RIP RAP IS STOCKPILED AT APPROXIMATELY 39,000 E AND 39,000 N.
- 1 EXISTING ASH IN POND 91 TO BE REMOVED UNDER AN EXISTING CONTRACT. AFTER REMOVAL IS COMPLETE, A SURVEY OF GROUND CONDITIONS WILL BE COMPLETED PRIOR TO CONSTRUCTION OF LINER SYSTEM.

## GENERAL NOTES


FOR BID ONLY

DRAWING NO.	REVISION	REFERENCE DRAWINGS
DWN. BAK DATE 12/30/91 W/O 920213	CHK.	EXISTING GROUND ASH POND 91
		1992 ASH DISPOSAL
		DRAWING NO. 92G213-7

01/09/92 ISSUED FOR BID  
DATE REVISIONS AND RECORD OF ISSUE

0 BK AS AS  
NO. BY CK APP



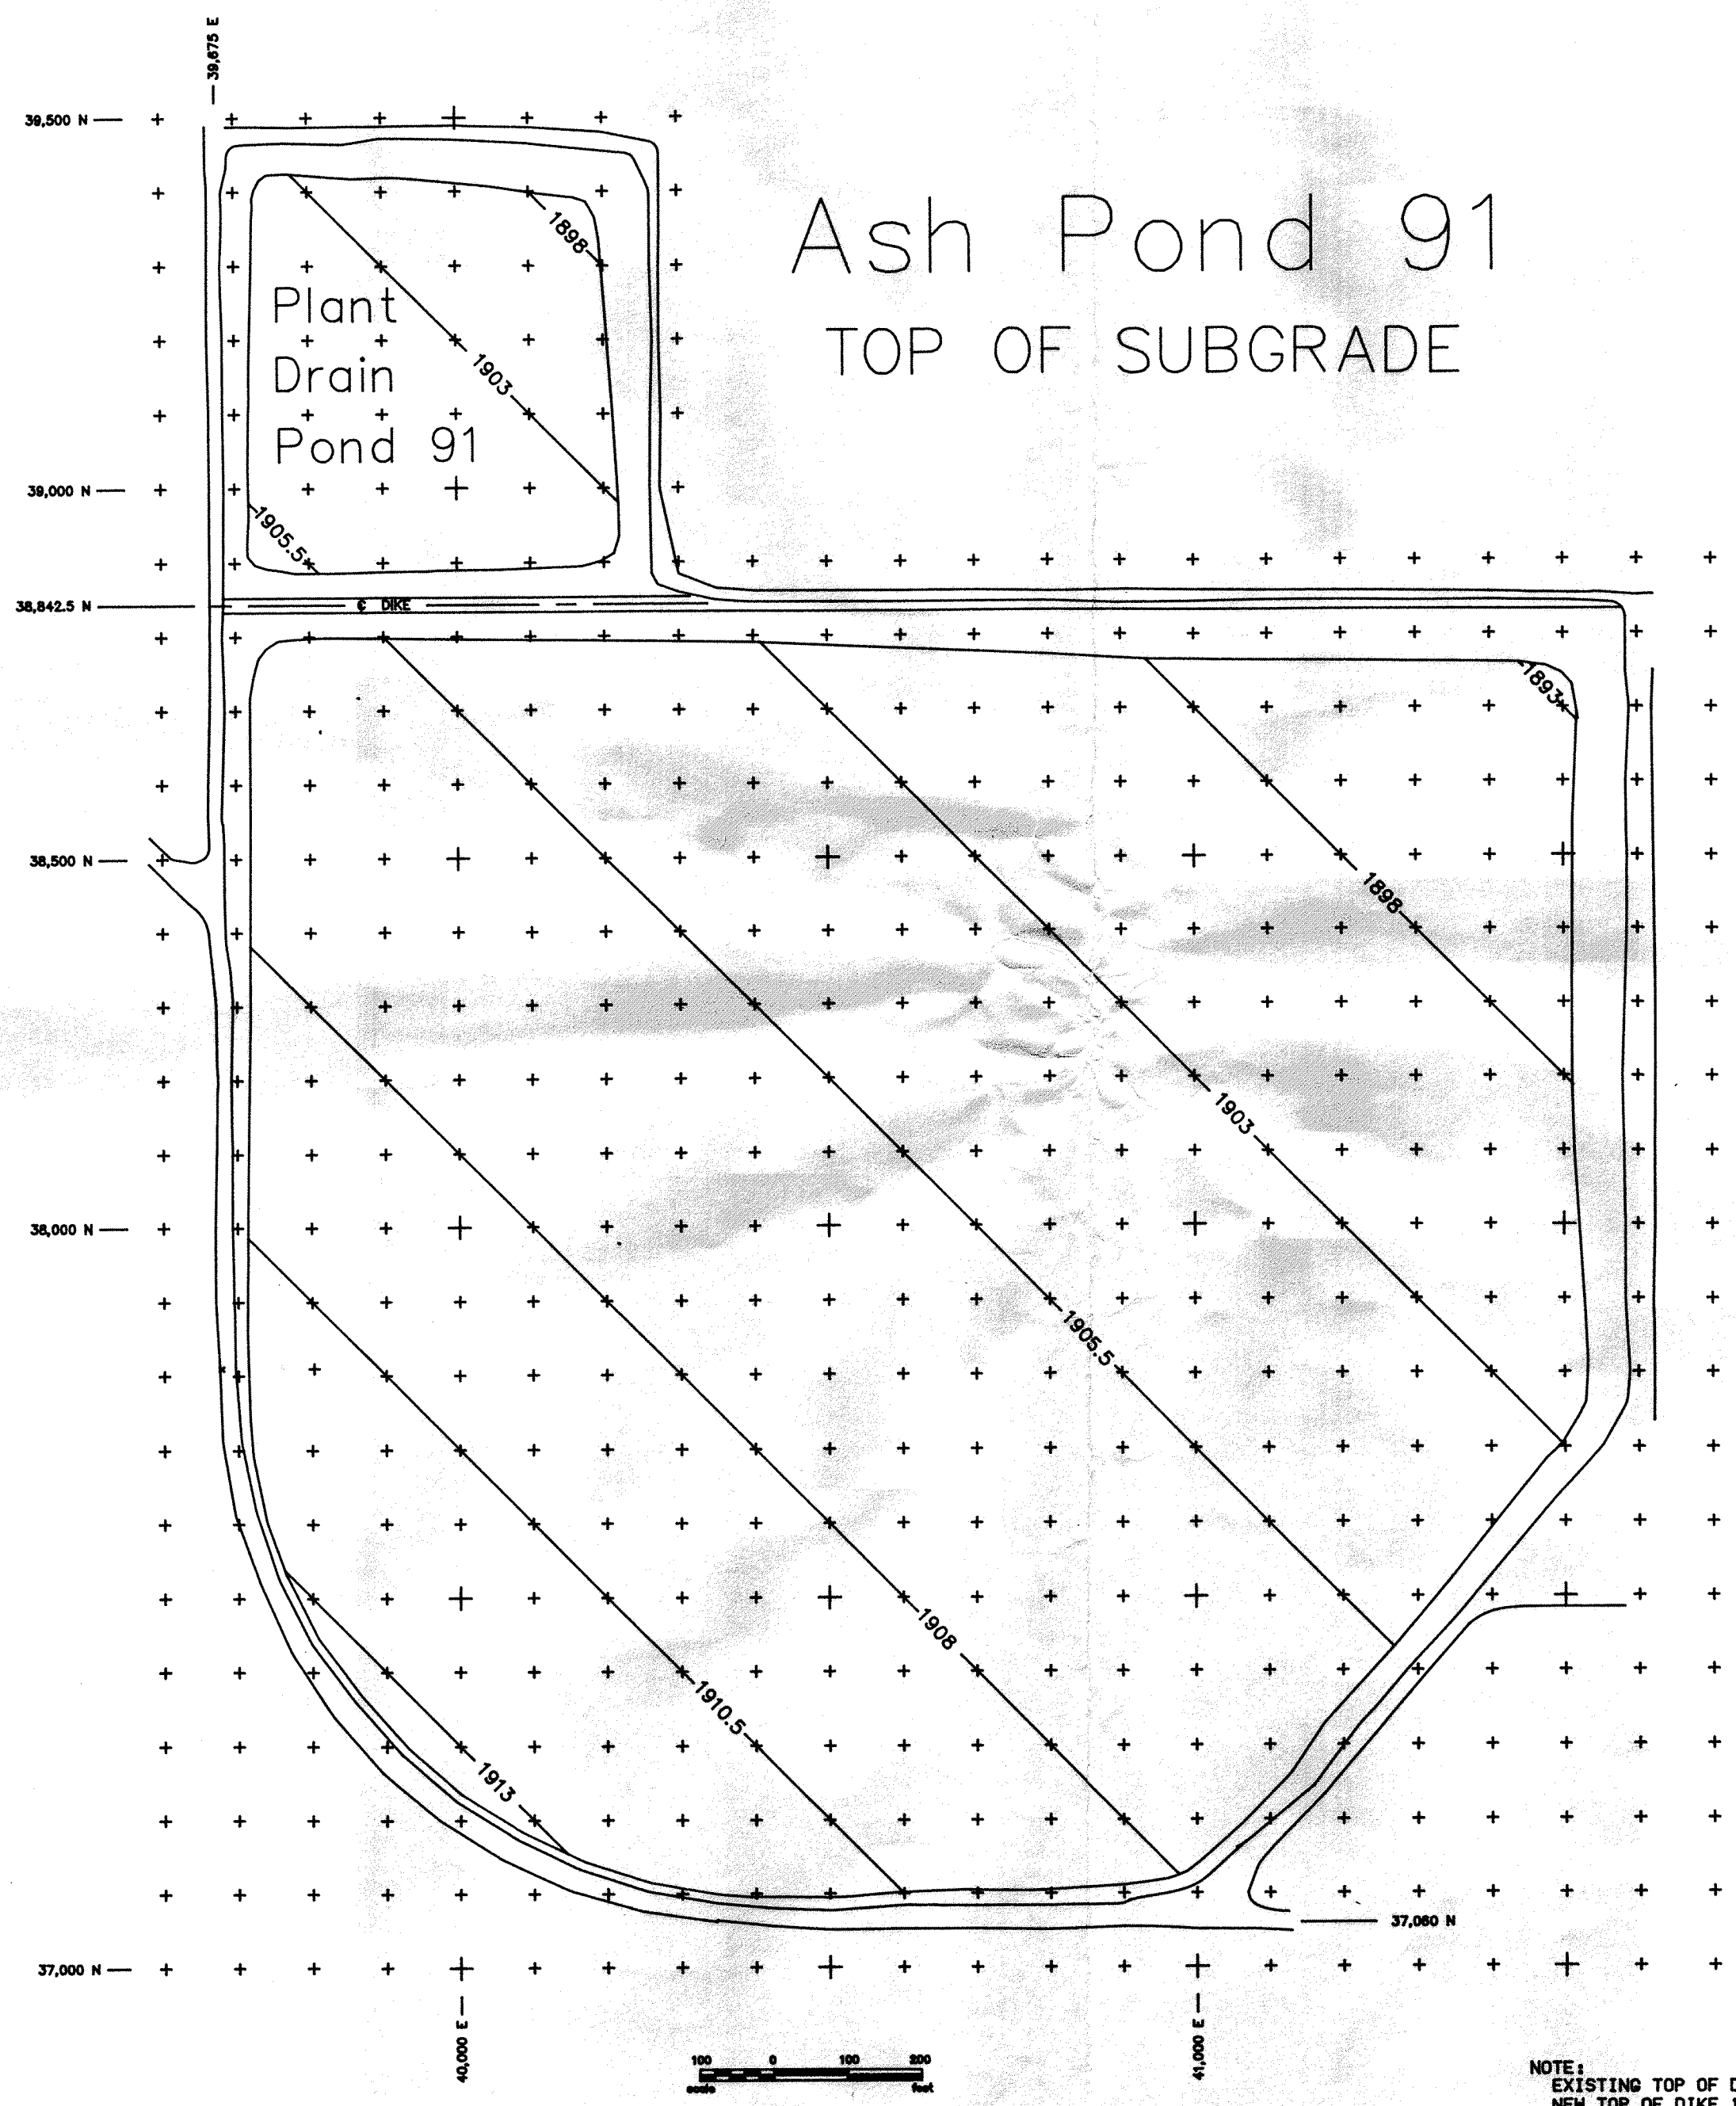


# Ash Pond 91

## TOP OF SUBGRADE

### GENERAL NOTES


FOR BID ONLY

### REFERENCE DRAWINGS


DRAWN BY		LAYOUT - TOP OF SUBGRADE ASH POND 91
DATE 12/30/91		
W/D 920213		
		1992 ASH DISPOSAL
		DRAWING NO. 92G213-8

01/08/92	ISSUED FOR BID	0	1	2	100
DATE	REVISIONS AND RECORD OF ISSUE	0	1	2	100



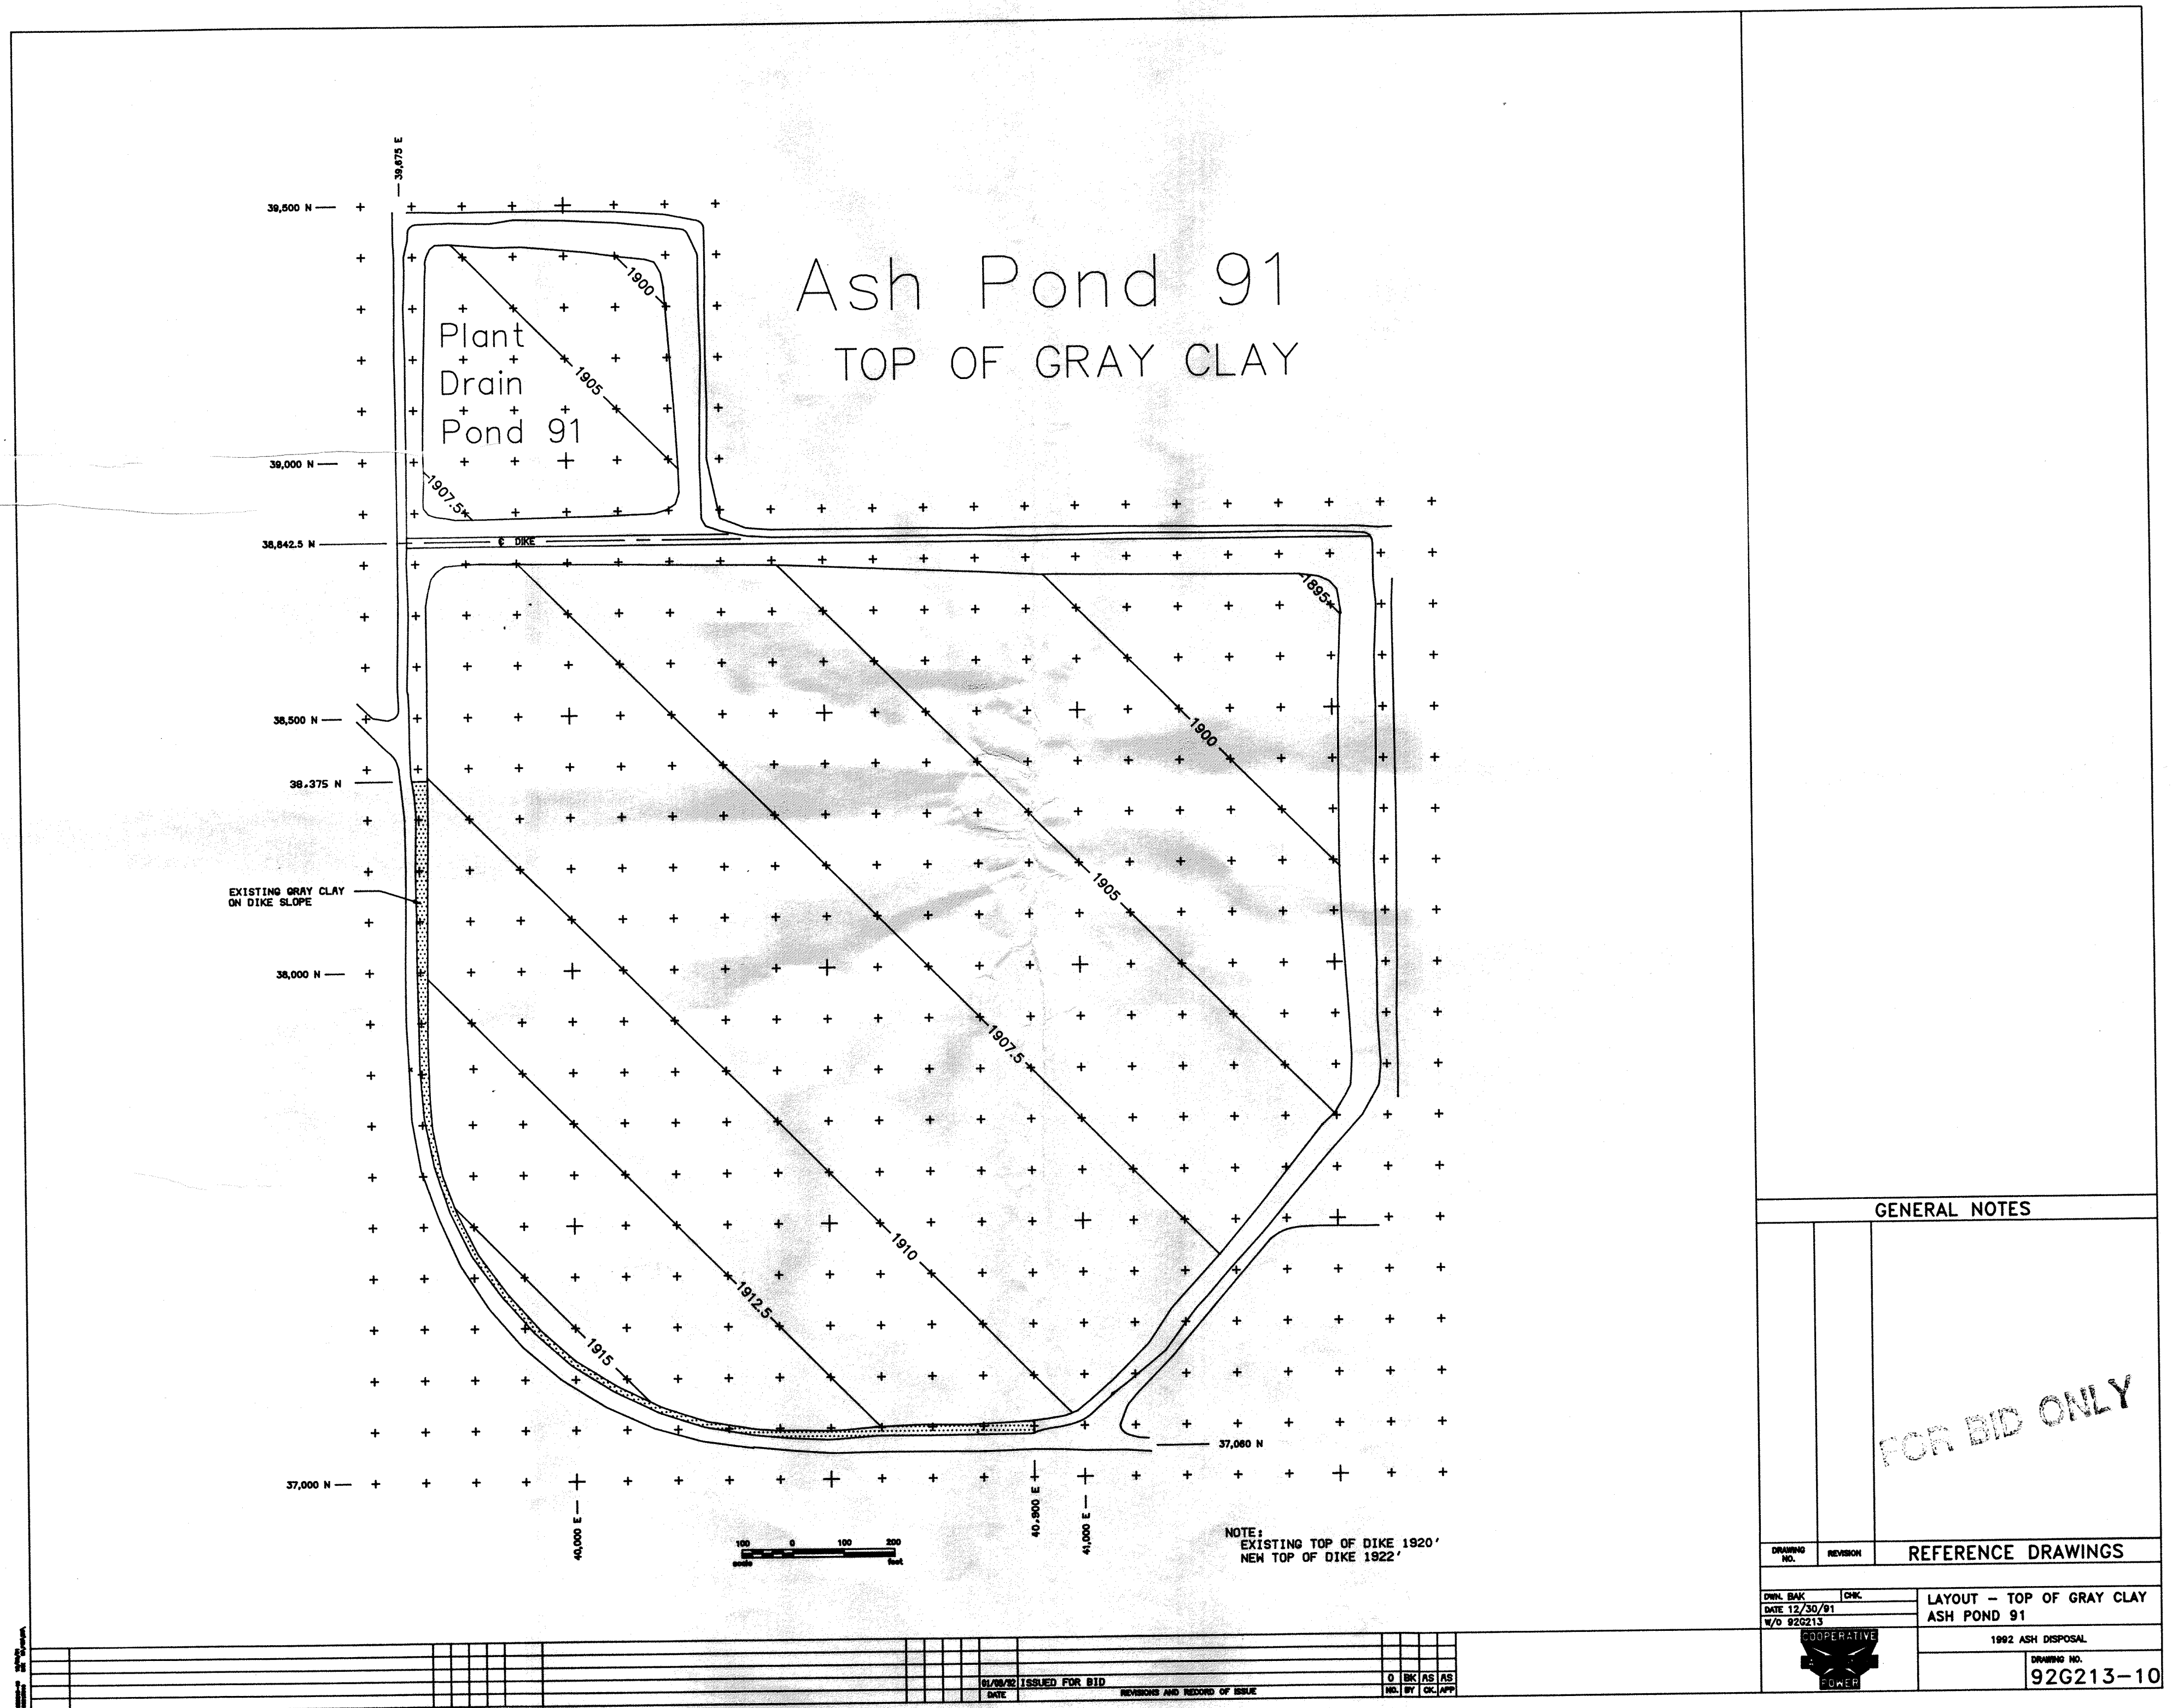



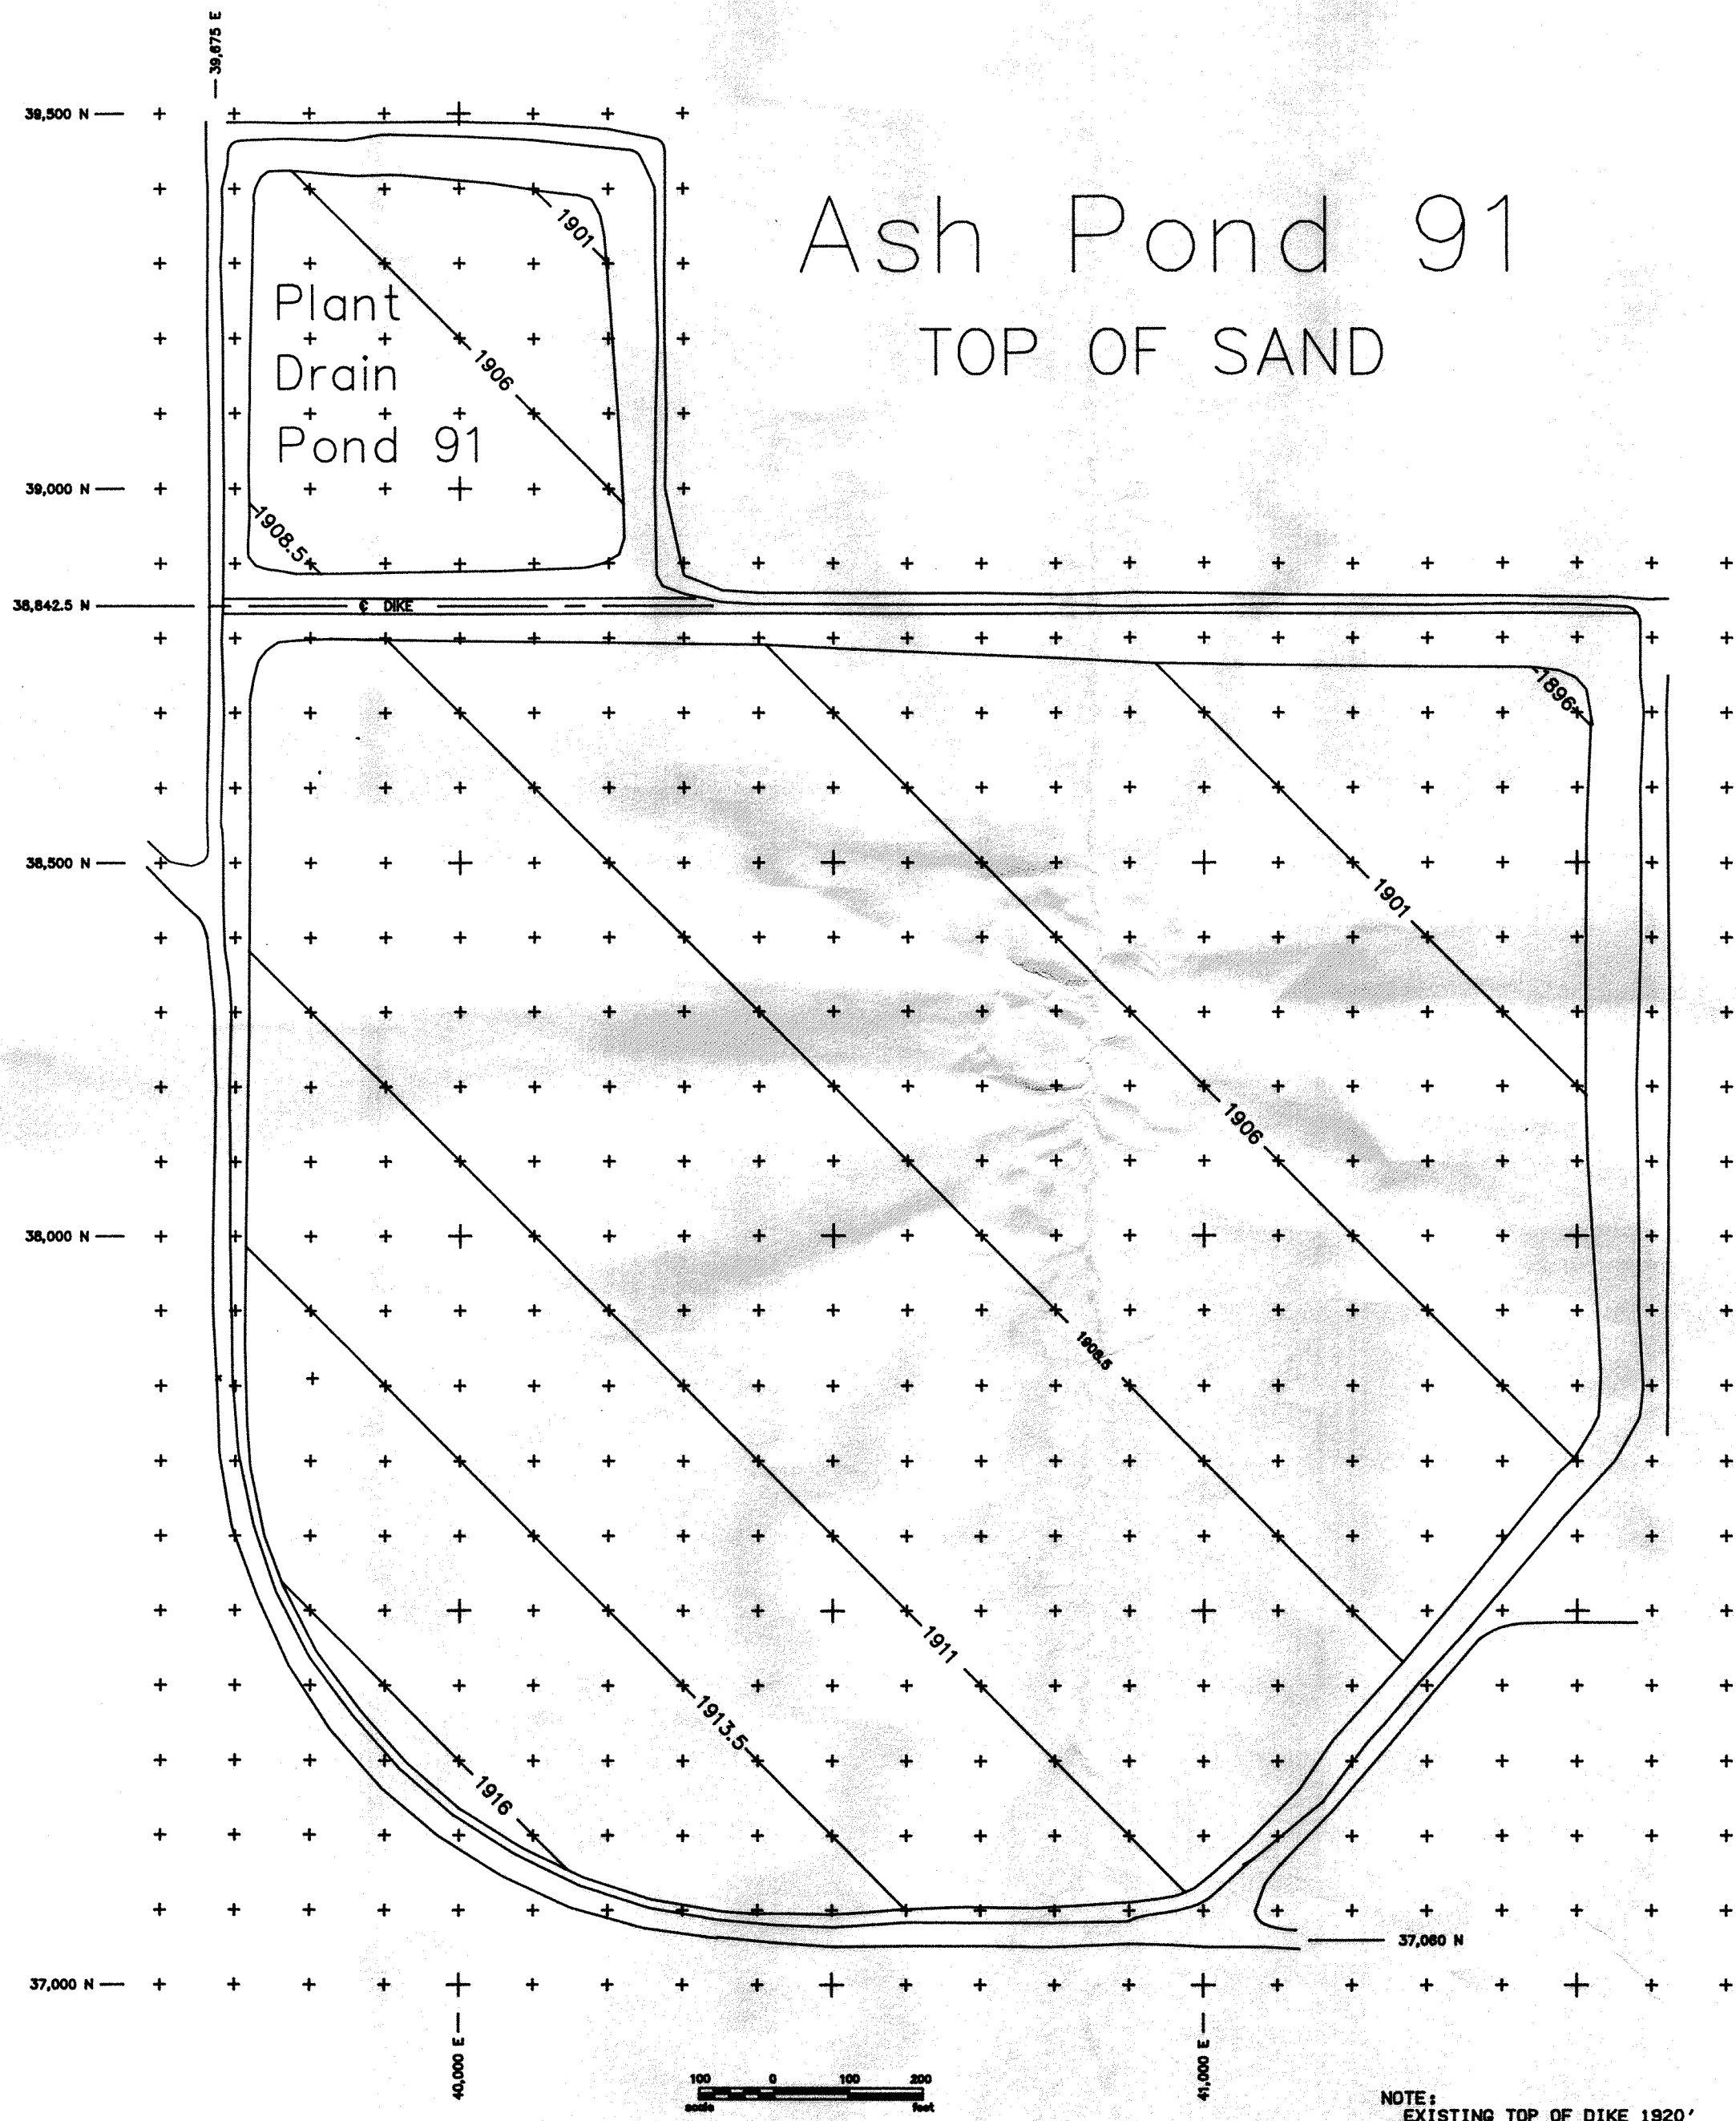

# Ash Pond 91

## TOP OF SAND

### GENERAL NOTES


FOR BID ONLY

### REFERENCE DRAWINGS

OWNER: BAK	DATE: 12/30/91	W/O: 92G213	COOPERATIVE POWER	LAYOUT - TOP OF SAND ASH POND 91	1992 ASH DISPOSAL	DRAWING NO. 92G213-11
------------	----------------	-------------	-------------------	-------------------------------------	-------------------	--------------------------

01/19/92	ISSUED FOR BID	REVISIONS AND RECORD OF ISSUE	0	BAK	AS	AS
DATE			NO.	BY	CHK.	APP.



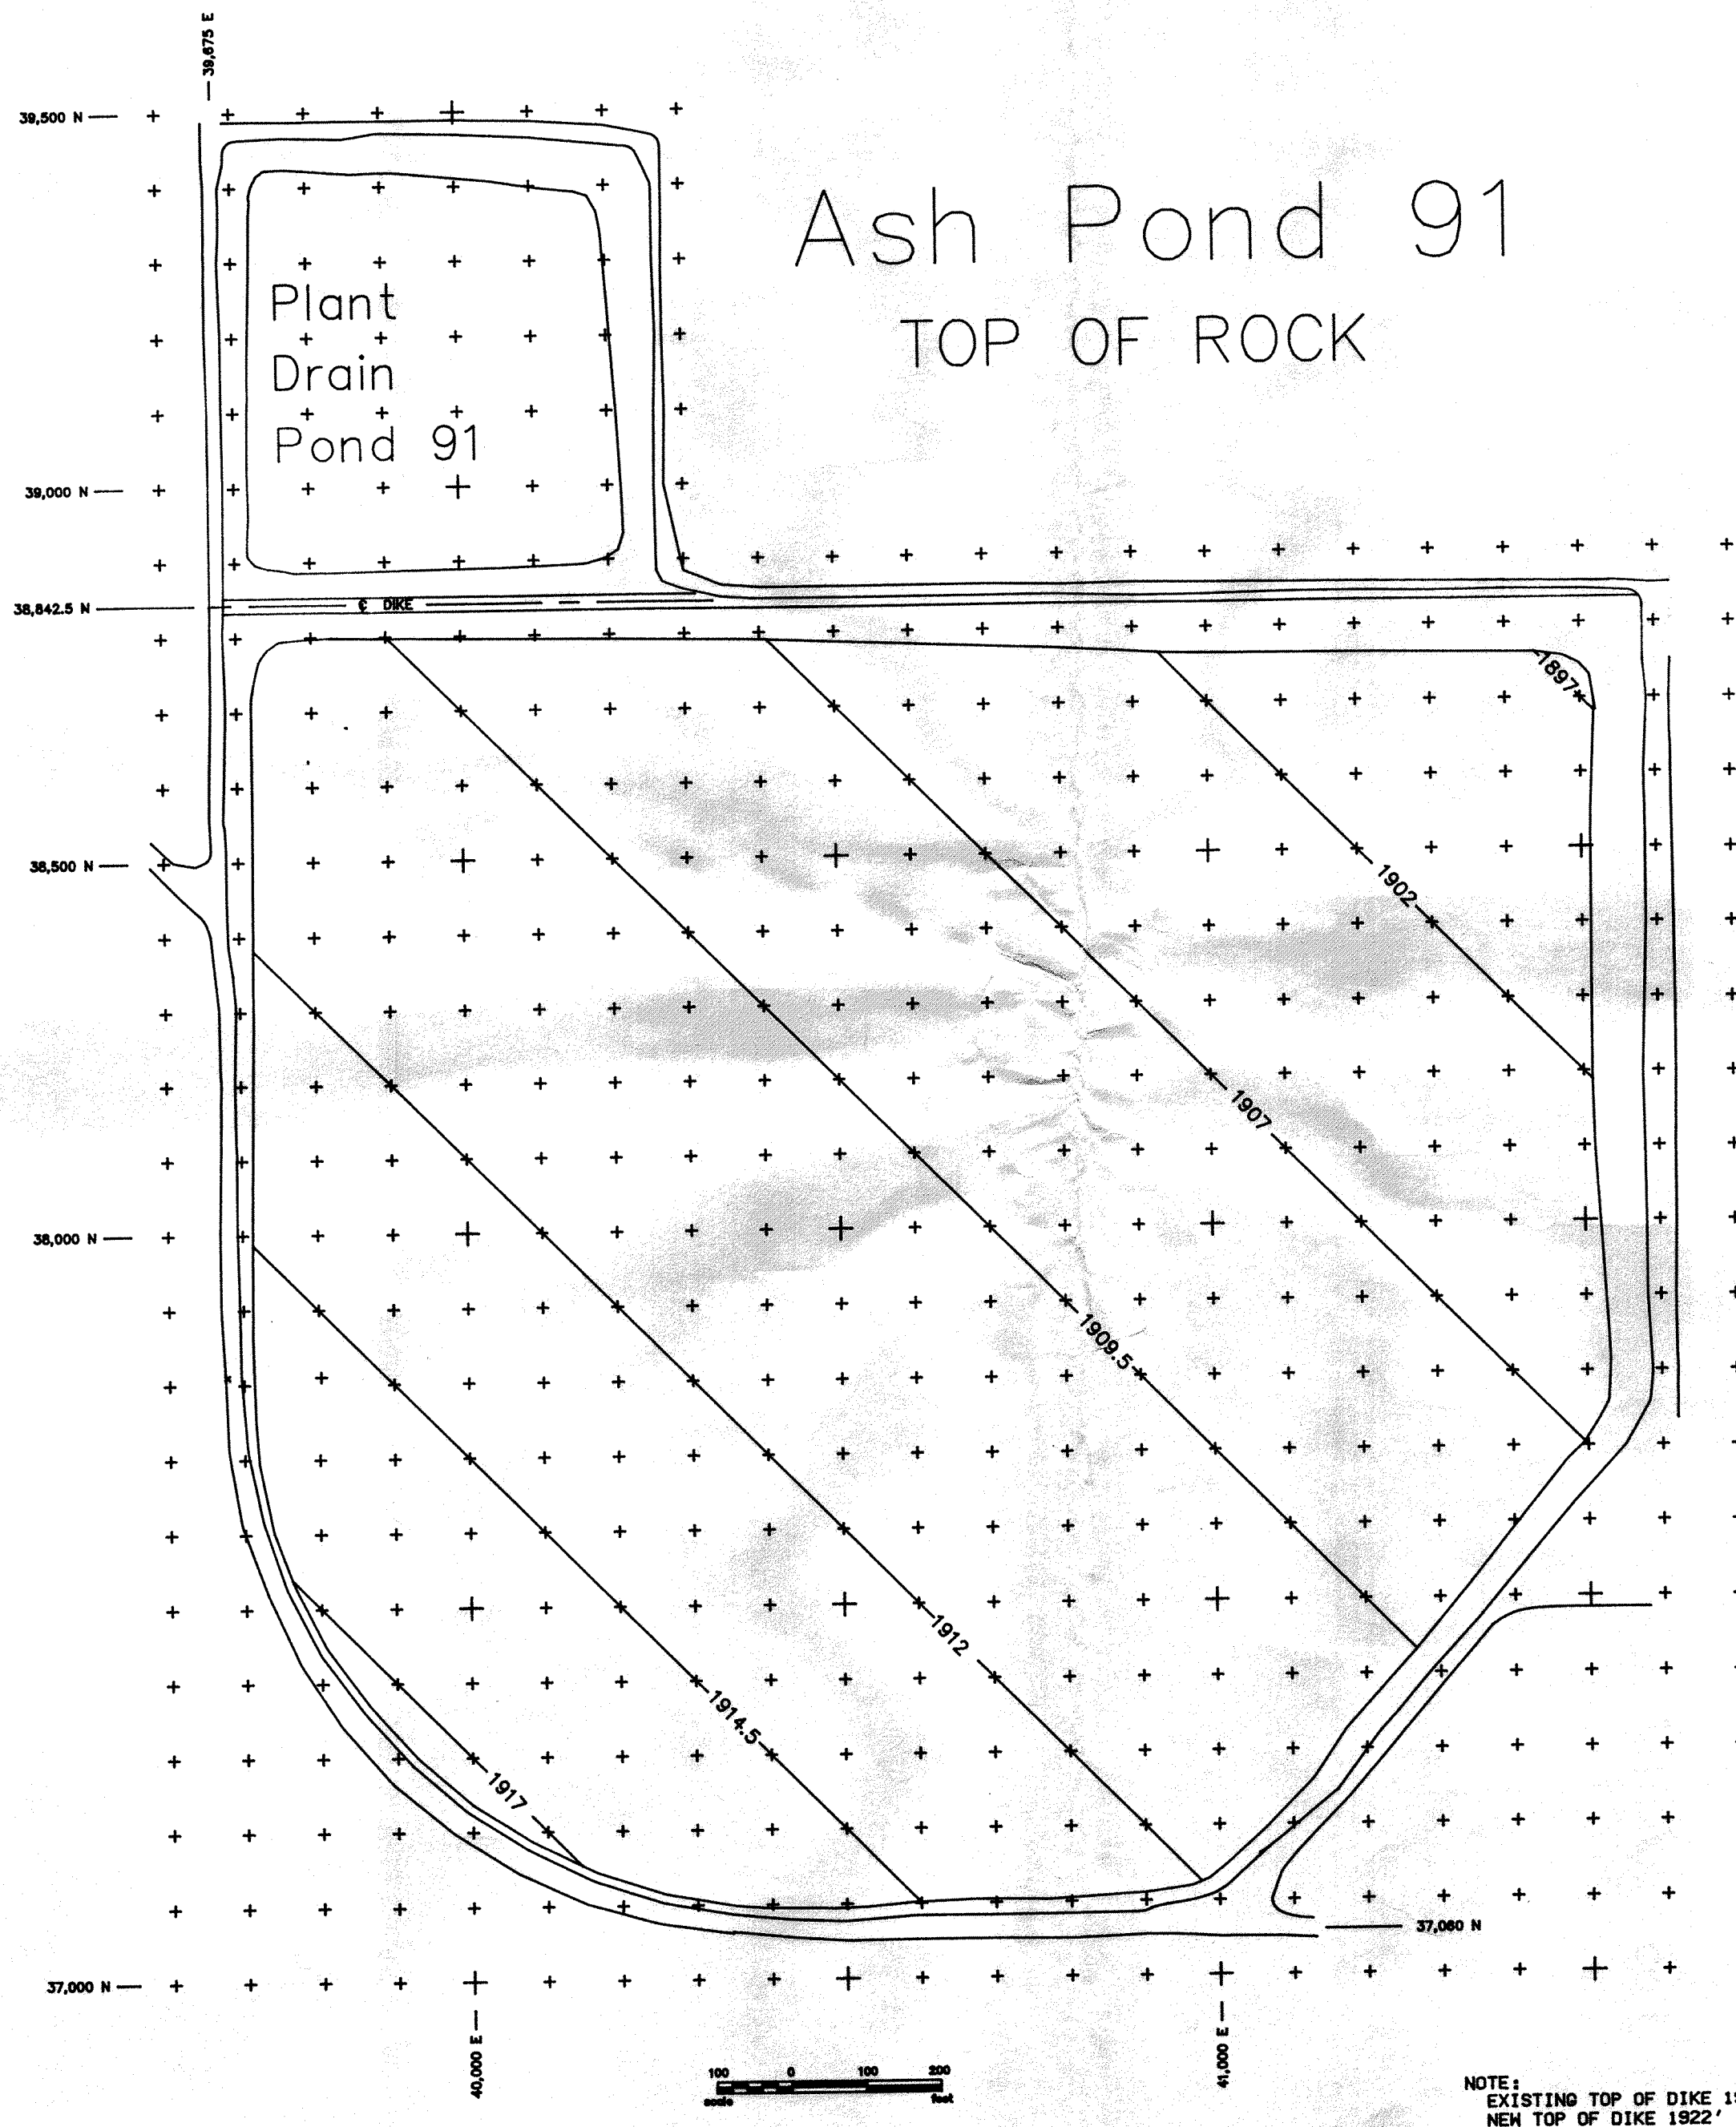

# Ash Pond 91

## TOP OF ROCK

Plant  
Drain  
Pond 91

### GENERAL NOTES

FOR BID ONLY

### REFERENCE DRAWINGS

DRAWN BY: CHC  
DATE: 12/30/91  
W/O 92G213

LAYOUT - TOP OF ROCK  
ASH POND 91

1992 ASH DISPOSAL




DRAWING NO.  
92G213-12

ISSUED FOR BID

REVISIONS AND RECORD OF ISSUE

0 BK AS AS  
NO. BY CL APP



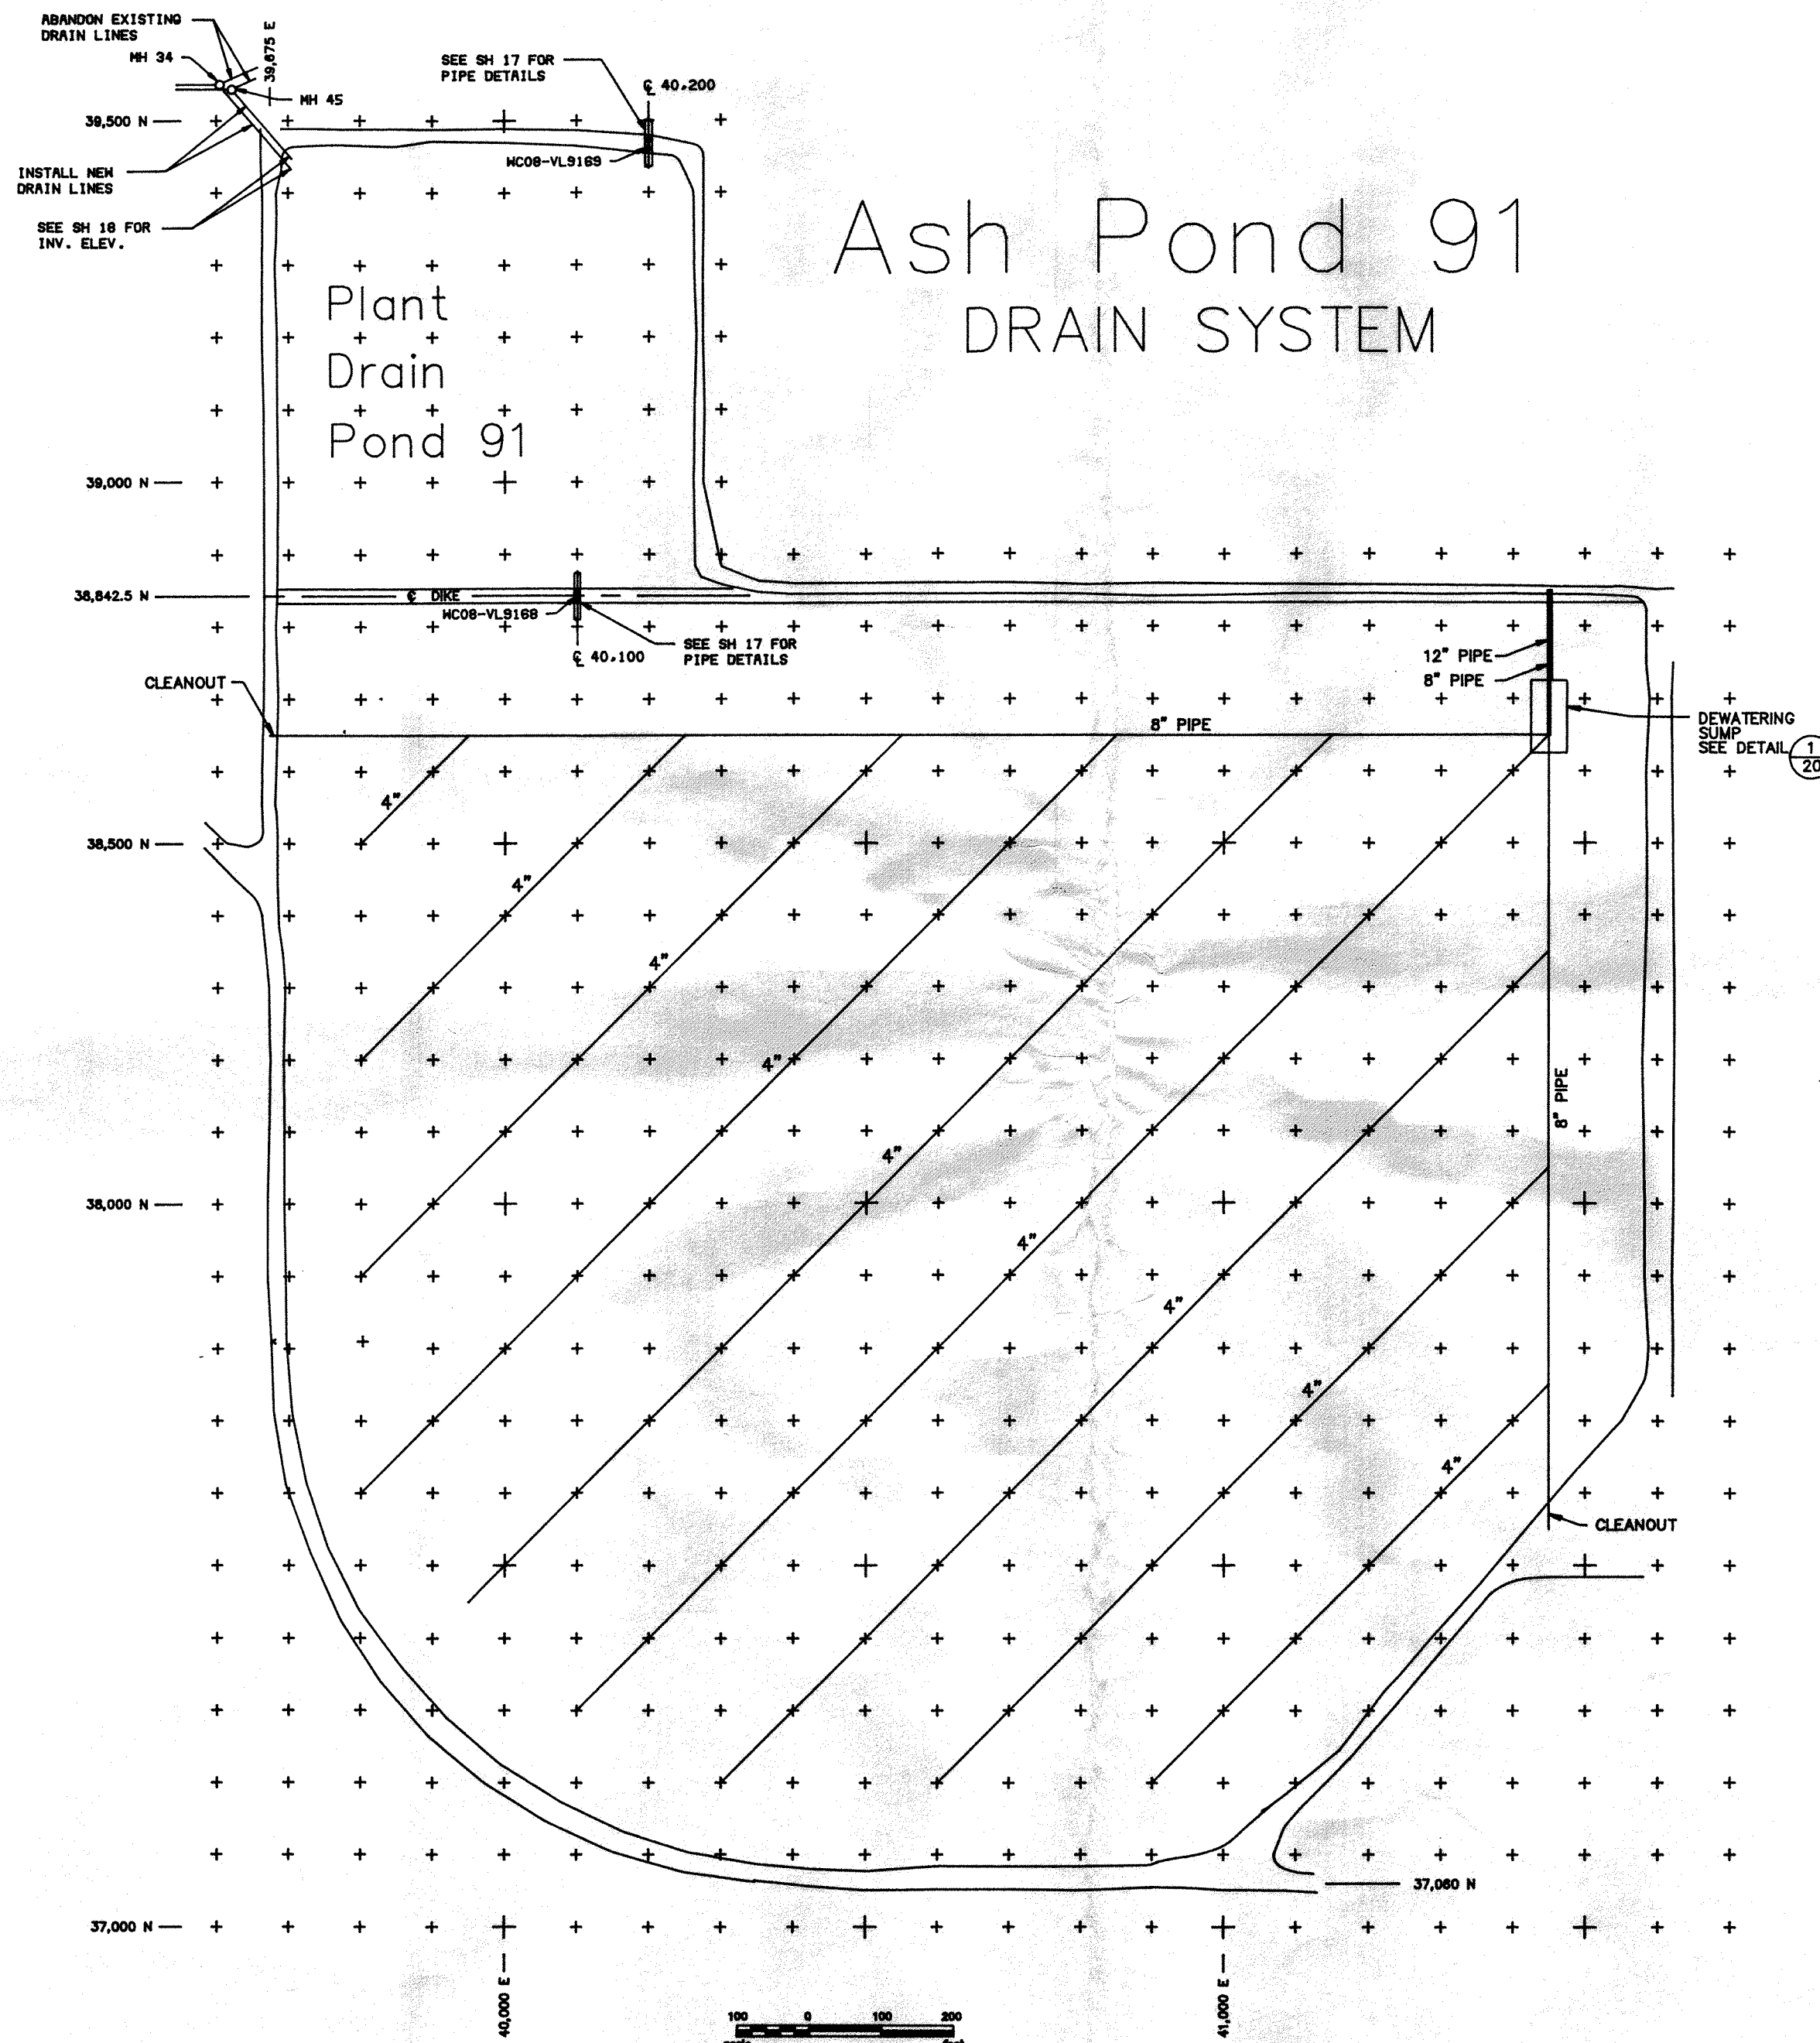

# GENERAL NOTES

FOR BID ONLY

## REFERENCE DRAWINGS

DRAWN BY: [ ]  
DATE: 12/30/91  
W/O: 92G213

CHK: [ ]  
LAYOUT - DRAIN SYSTEM  
ASH POND 91

1992 ASH DISPOSAL



DRAWING NO.


92G213-14

01/09/92 ISSUED FOR BIDS


REVISIONS AND RECORD OF ISSUE

0 BK AS/AS  
REL BY: [ ]




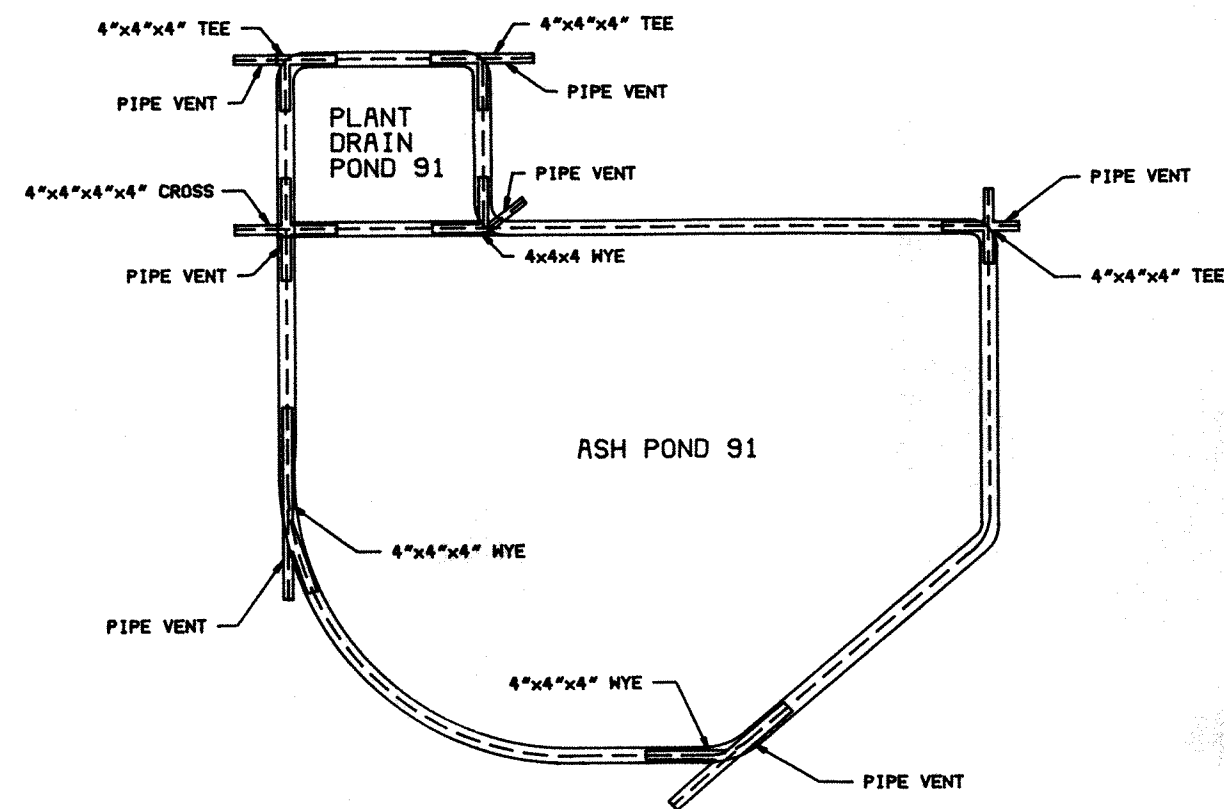


1 GAS PIPING AND TRENCH LAYOUT ASH POND 91  
NOT TO SCALE

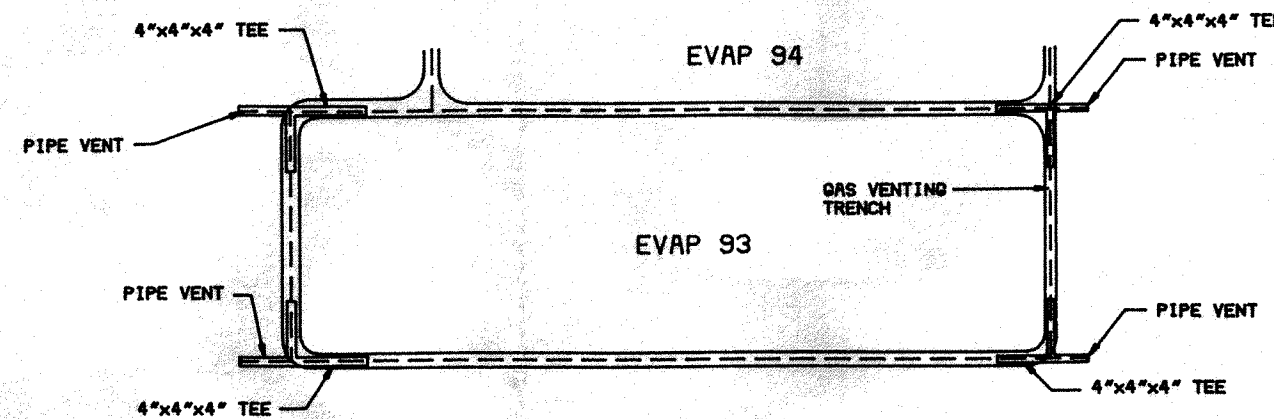


2 GAS PIPING AND TRENCH LAYOUT EVAPORATION POND 93  
NOT TO SCALE

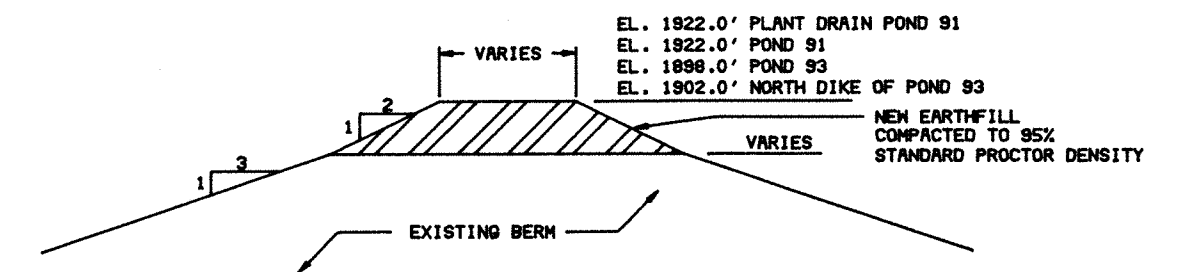


3 BERM RAISING DETAIL  
NOT TO SCALE

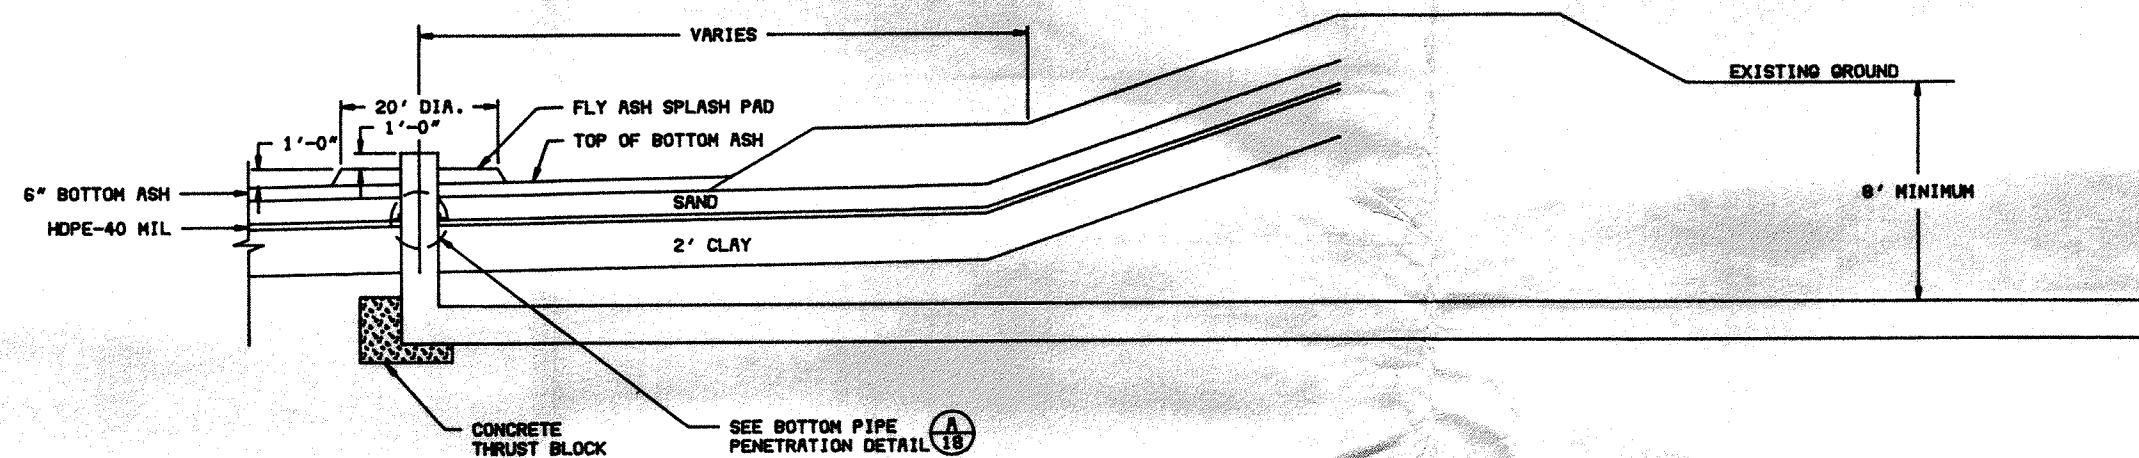

4 EVAPORATION POND 93 INLET DETAIL  
NOT TO SCALE

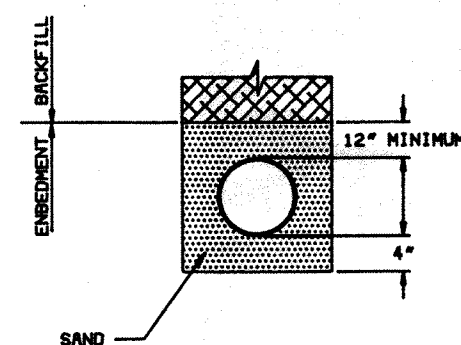


TYPICAL PIPE BEDDING  
NOT TO SCALE

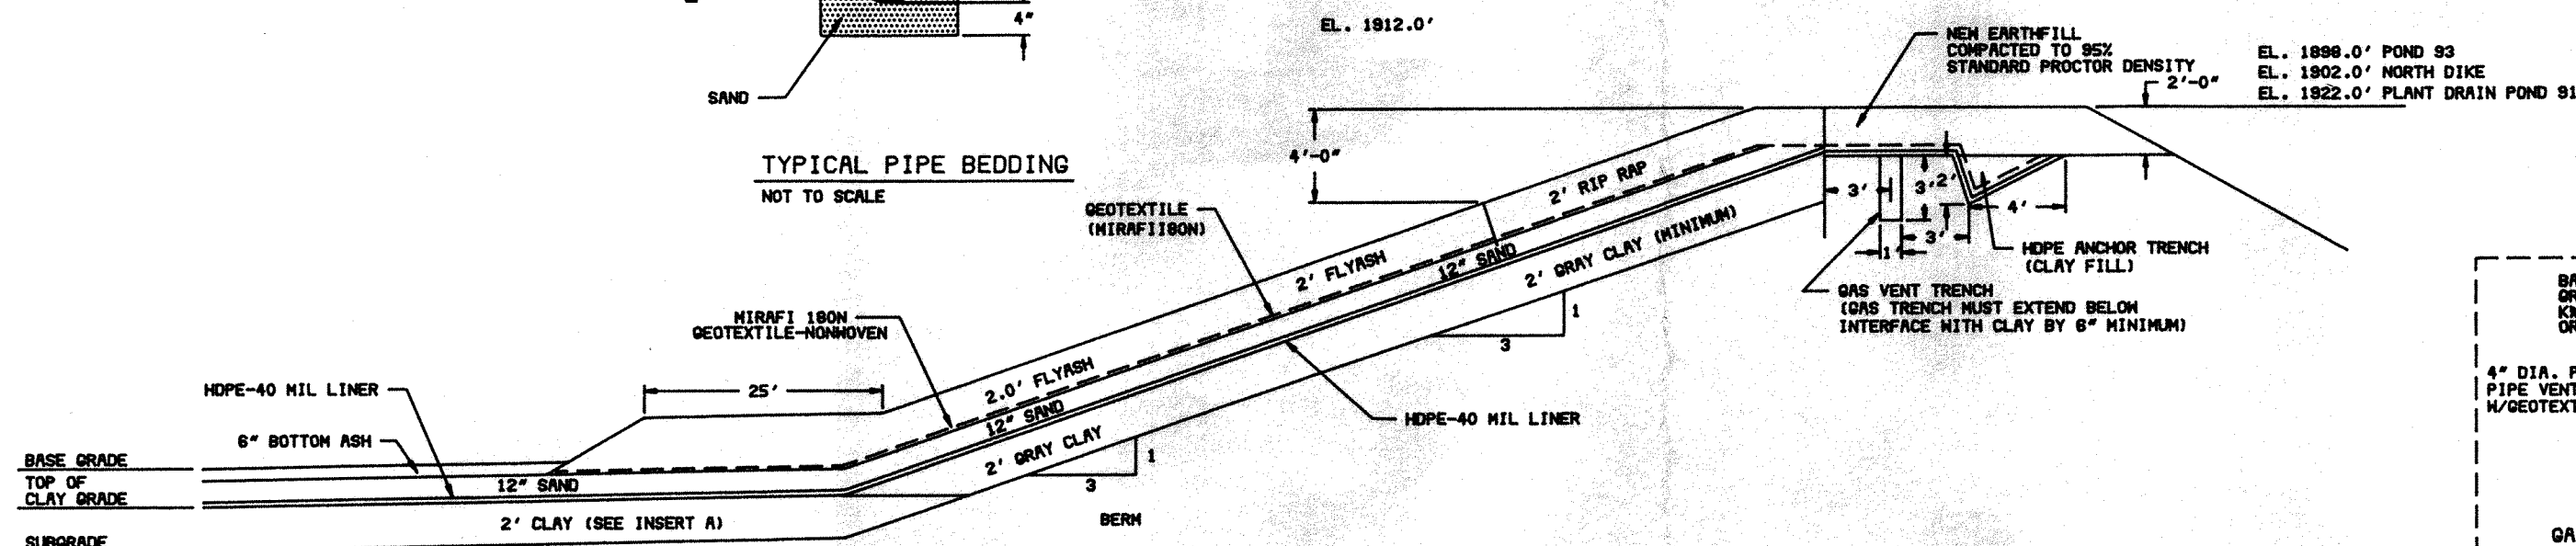

INSERT A

6" GRAY CLAY
18" BROWN CLAY

5 TYPICAL BERM & BOTTOM SECTION  
EVAPORATION POND 93 AND PLANT DRAIN POND 91  
NOT TO SCALE

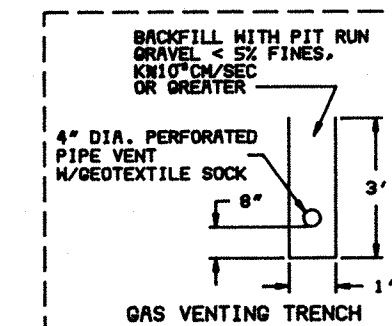

- NOTE:
1. PROVIDE PERFORATED PIPE VENTS (PVC-SHED40). EACH APPROX. 120' LONG AND 4" DIA. IN THE GAS VENTING TRENCHES. THE EXACT LENGTHS TO BE DETERMINED BY SITE REPRESENTATIVE.
  2. THE EXPOSED ENDS OF 4" DIA. GAS VENTING PIPE SHALL BE PROTECTED WITH BOTH A 1/2" STAINLESS STEEL SCREEN AND REGULAR SCREENING MATERIALS.

# GENERAL NOTES

FOR BID ONLY



DRAWING NO.	REVISION	REFERENCE DRAWINGS
OWN: BAK	CHK:	TYPICAL SECTIONS AND DETAILS
DATE 12/26/91		1992 ASH DISPOSAL
W/O 920213		DRAWING NO. 92G213-16

11/26/92


11/26/92 ISSUED FOR BID

REVISIONS AND RECORD OF ISSUE


0 SK/AS/AS  
NA/ BY OK/APP

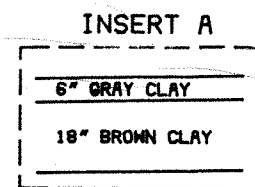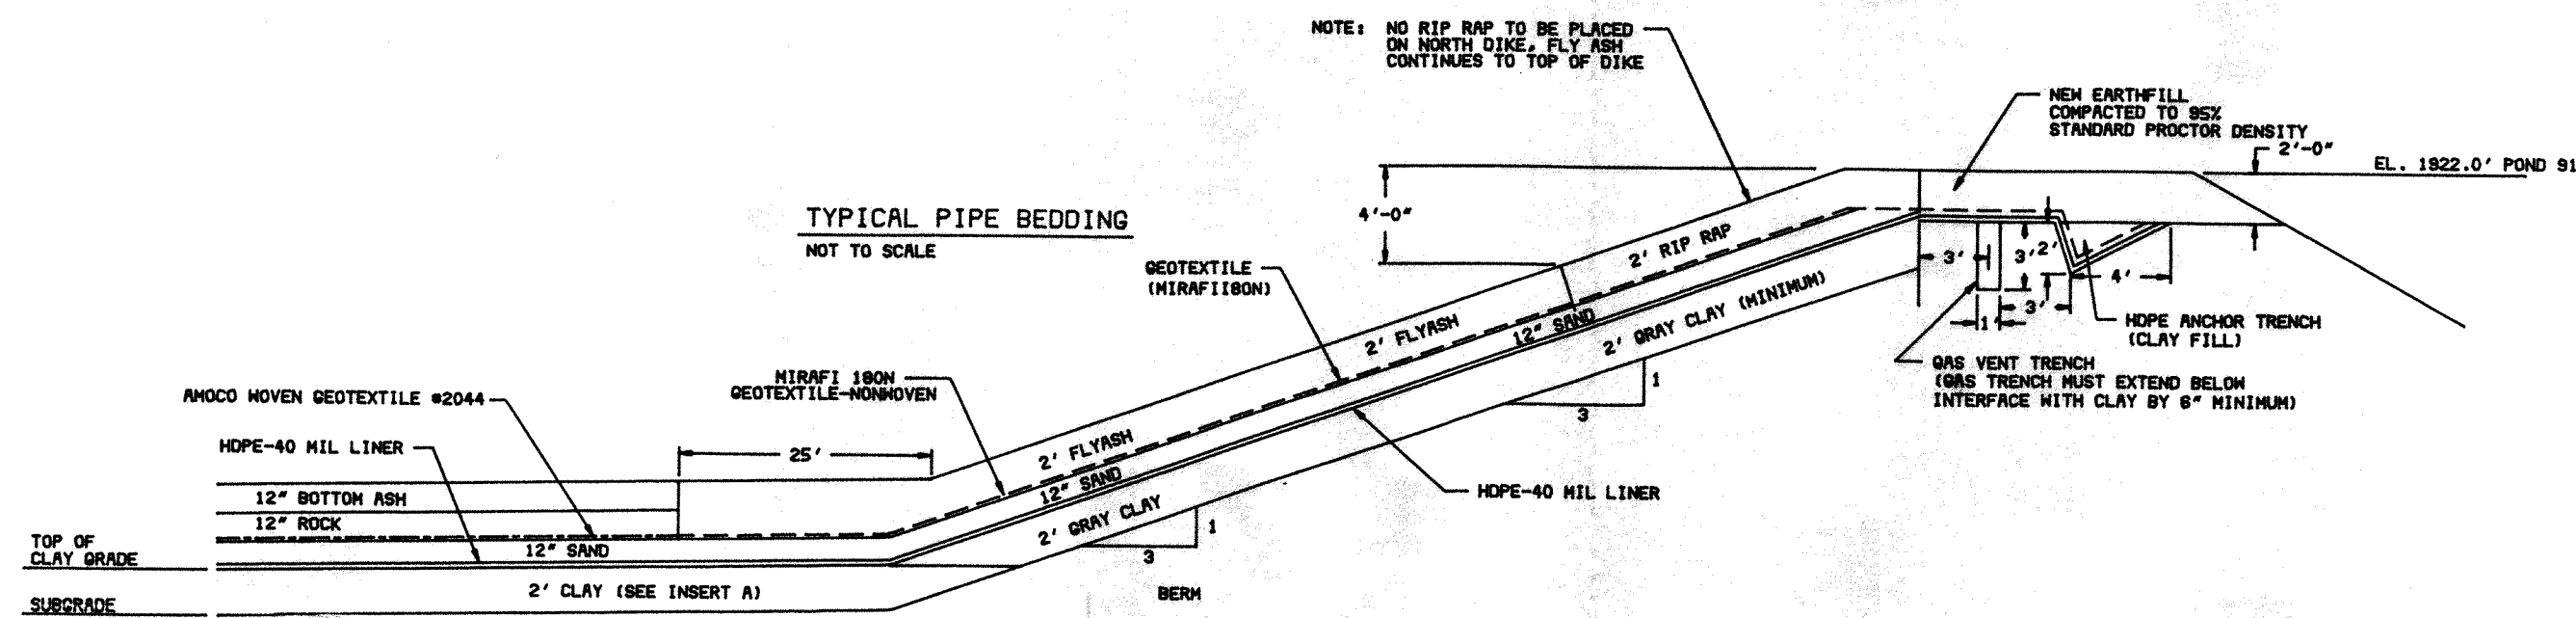

BERM & BOTTOM SECTION  
ASH POND 91  
NOT TO SCALE

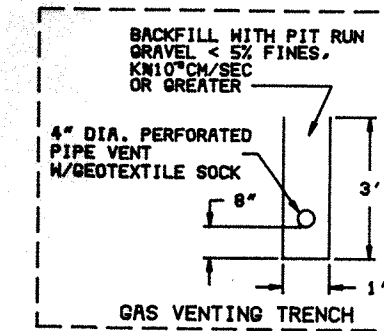

- NOTE:
1. PROVIDE PERFORATED PIPE VENTS (PVC-SHED40), EACH APPROX. 120' LONG AND 4" DIA. IN THE GAS VENTING TRENCHES. THE EXACT LENGTHS TO BE DETERMINED BY SITE REPRESENTATIVE.
  2. THE EXPOSED ENDS OF 4" DIA. GAS VENTING PIPE SHALL BE PROTECTED WITH BOTH A 1/2" STAINLESS STEEL SCREEN AND REGULAR SCREENING MATERIALS.

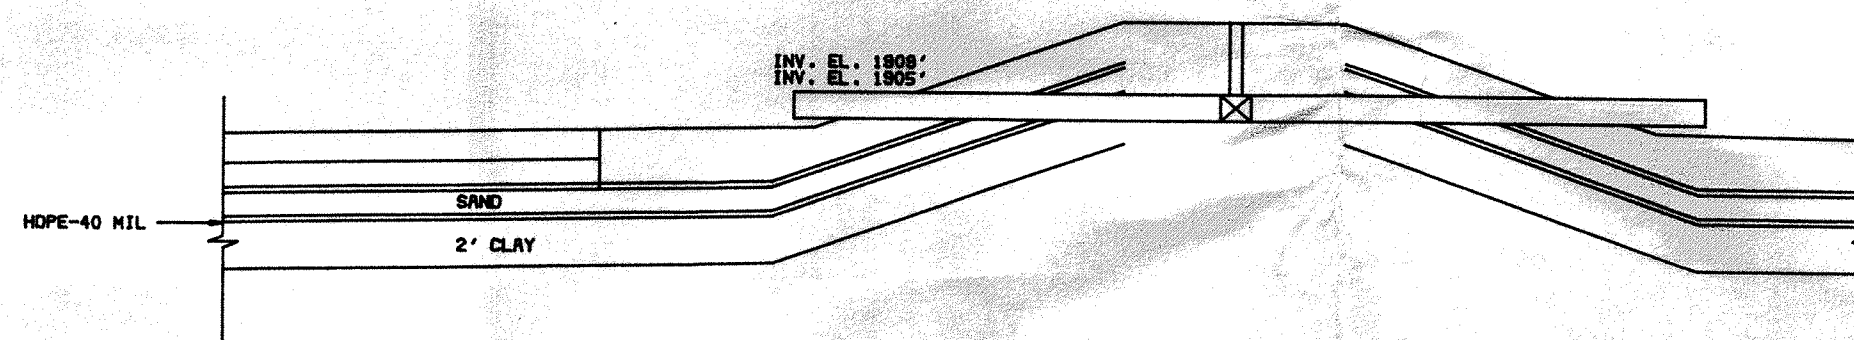

PIPE PENETRATION - BERM  
ASH POND 91 AND DRAIN POND 91  
NOT TO SCALE

VALVE LIST											
ITEM NO.	SYSTEM TAG	DESCRIPTION	S & V FILE NO.	SIZE IN.	PRESS. IN.	PRESS. CLASS	TYPE	BODY END MAT PREP	WFR NO.	SHOP NO.	REMARKS
	WC08-VL9189	ASH POND 91- PLANT DRAIN POND		18	100	150	GR	CI			UNDERGROUND VALVE WITH VALVE BOX
	WC08-VL9189	PLANT DRAIN POND DISCHARGE		18	100	150	GR	CI			UNDERGROUND VALVE WITH VALVE BOX

# GENERAL NOTES

FOR BID ONLY

## REFERENCE DRAWINGS

DRAWN BY: [ ]  
DATE: 12/26/81  
W/O: 926213

## TYPICAL SECTIONS AND DETAILS

1982 ASH DISPOSAL

DRAWING NO.





92G213-17

01/01/92 ISSUED FOR BID

DATE REVISIONS AND RECORD OF ISSUE

0 OK AS AS  
NO. BY: CLK/APP



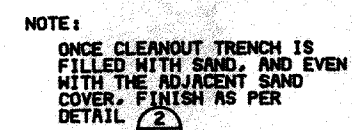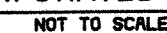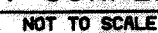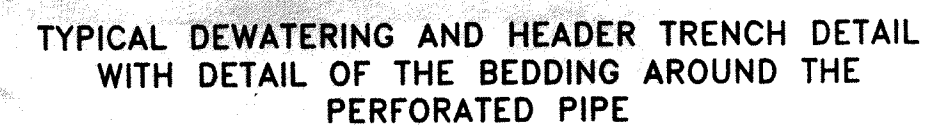

**TYPICAL CLEAN-OUT RISERS  
EAST AND WEST SLOPES**

### GENERAL NOTES


FOR EYE ONLY

OWN. BAK	CHK.	DETAILS MISCELLANEOUS
DATE 01/02/92		
W/O 826213		


1992 ASH DISPOSAL

DRAWING NO.
-------------


92G213-19

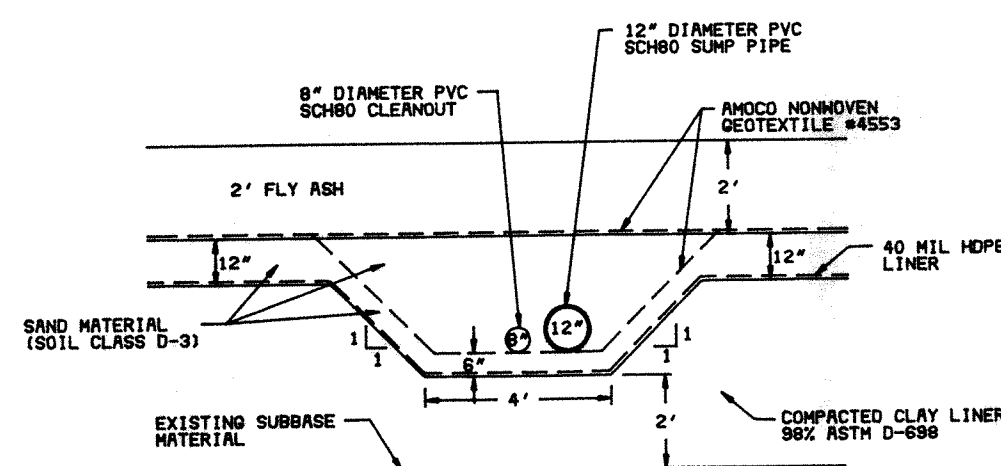


SECTION A - A

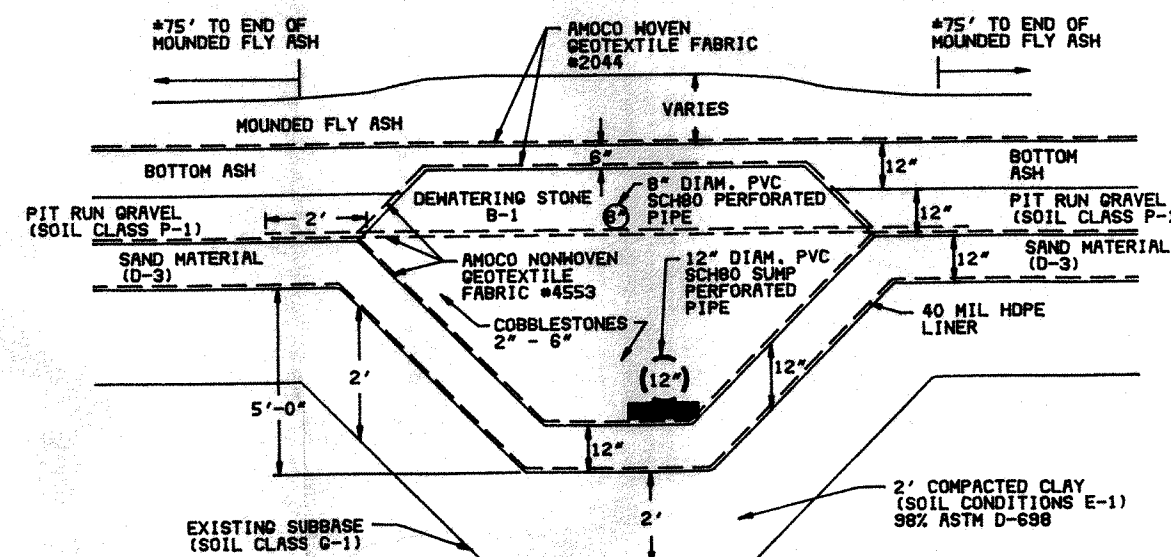

SECTION B - B

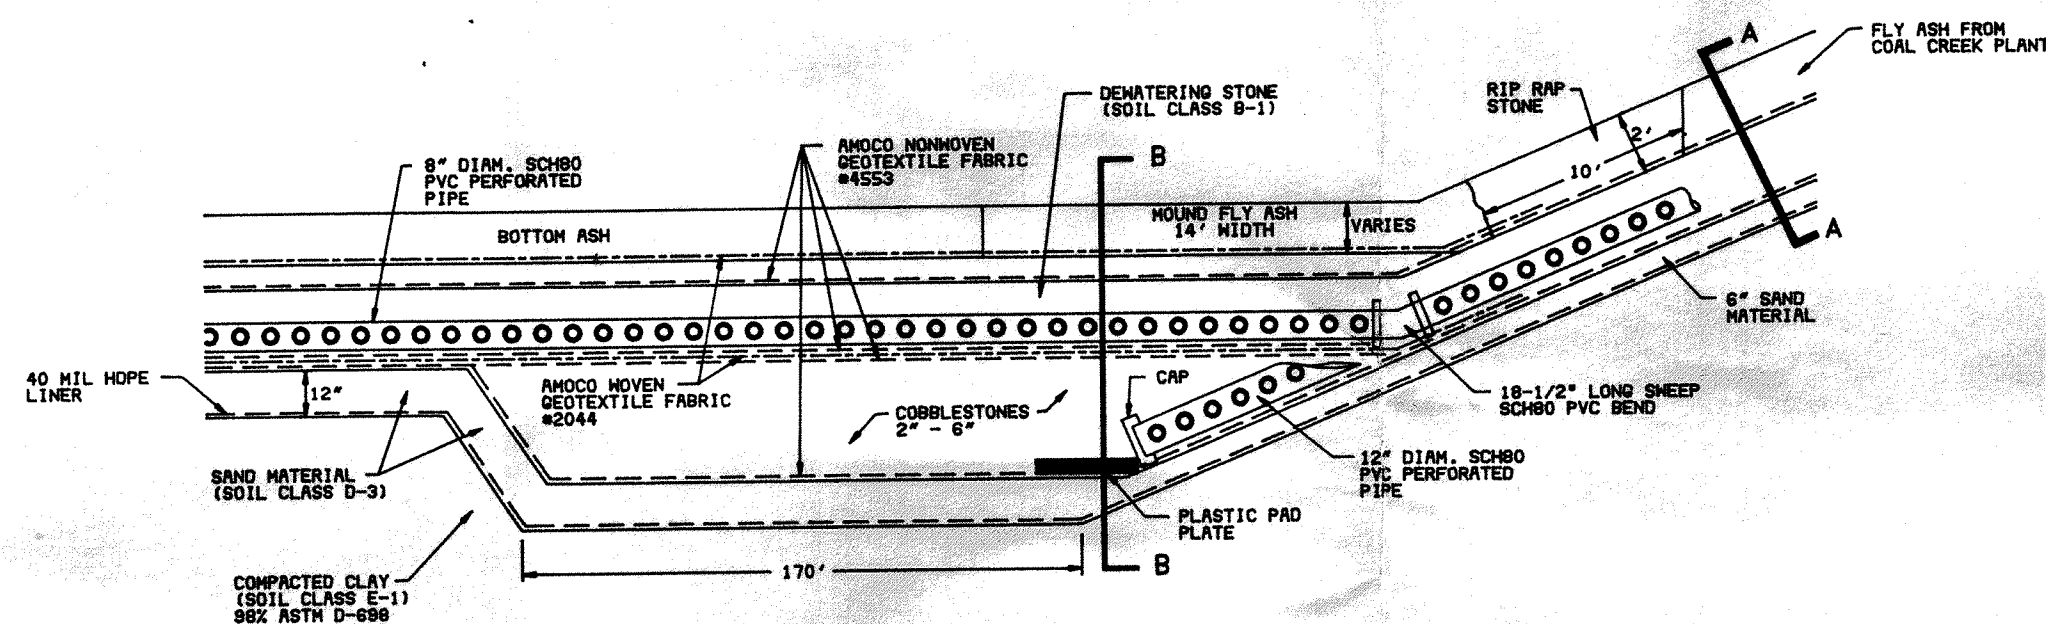

1  
20 DEWATERING SUMP DETAIL  
NOT TO SCALE

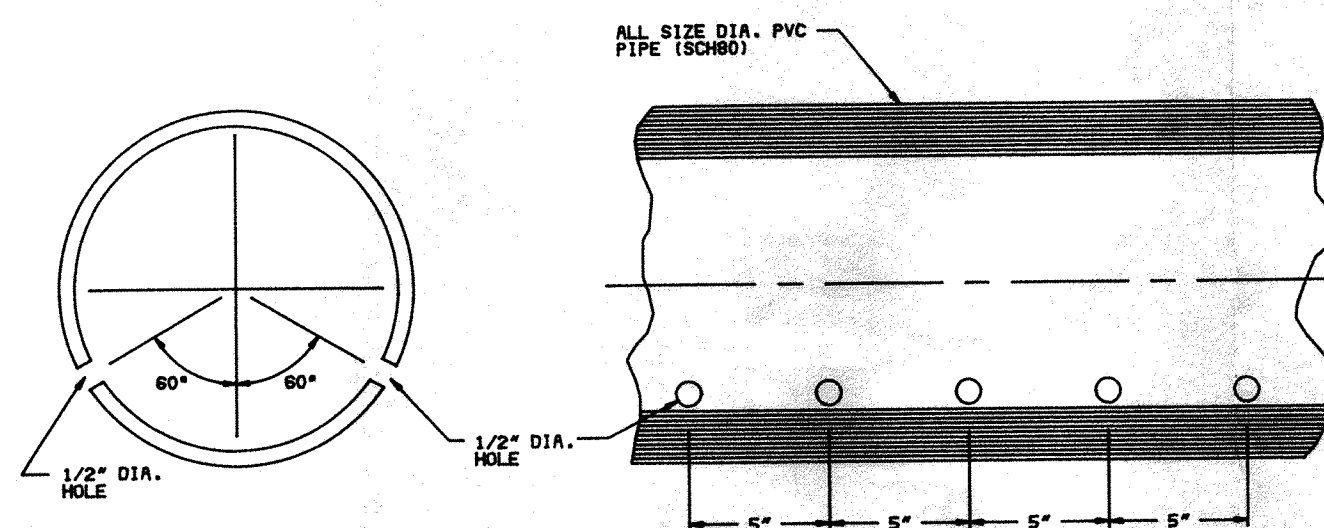

2  
20 PERFORATED PIPE DETAIL (ALL SIZES)  
NOT TO SCALE

GENERAL NOTES

REFERENCE DRAWINGS

DATE 01/03/92	CHK	DEWATERING, PERFORATED PIPE DETAILS
W/O 92G213		1992 ASH DISPOSAL
		DRAWING NO. 92G213-20

01/03/92 ISSUED FOR BID  
DATE REVISIONS AND RECORD OF ISSUE


0 BK AS AS  
ML BY CL JPM

APPENDIX A-2  
ASH POND 91 PERMIT DRAWINGS (GOLDER 2015A)



GREAT RIVER ENERGY  
PERMIT NO. 033 MODIFICATION  
ASH POND 91

Prepared for:

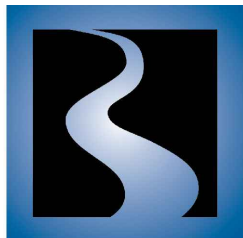


GREAT RIVER  
ENERGY®  
A Truist Energy Cooperative

Coal Creek Station  
Underwood, North Dakota

Prepared by:




Golder Associates Inc.  
44 Union Boulevard, Suite 300  
Lakewood, Colorado USA 80228

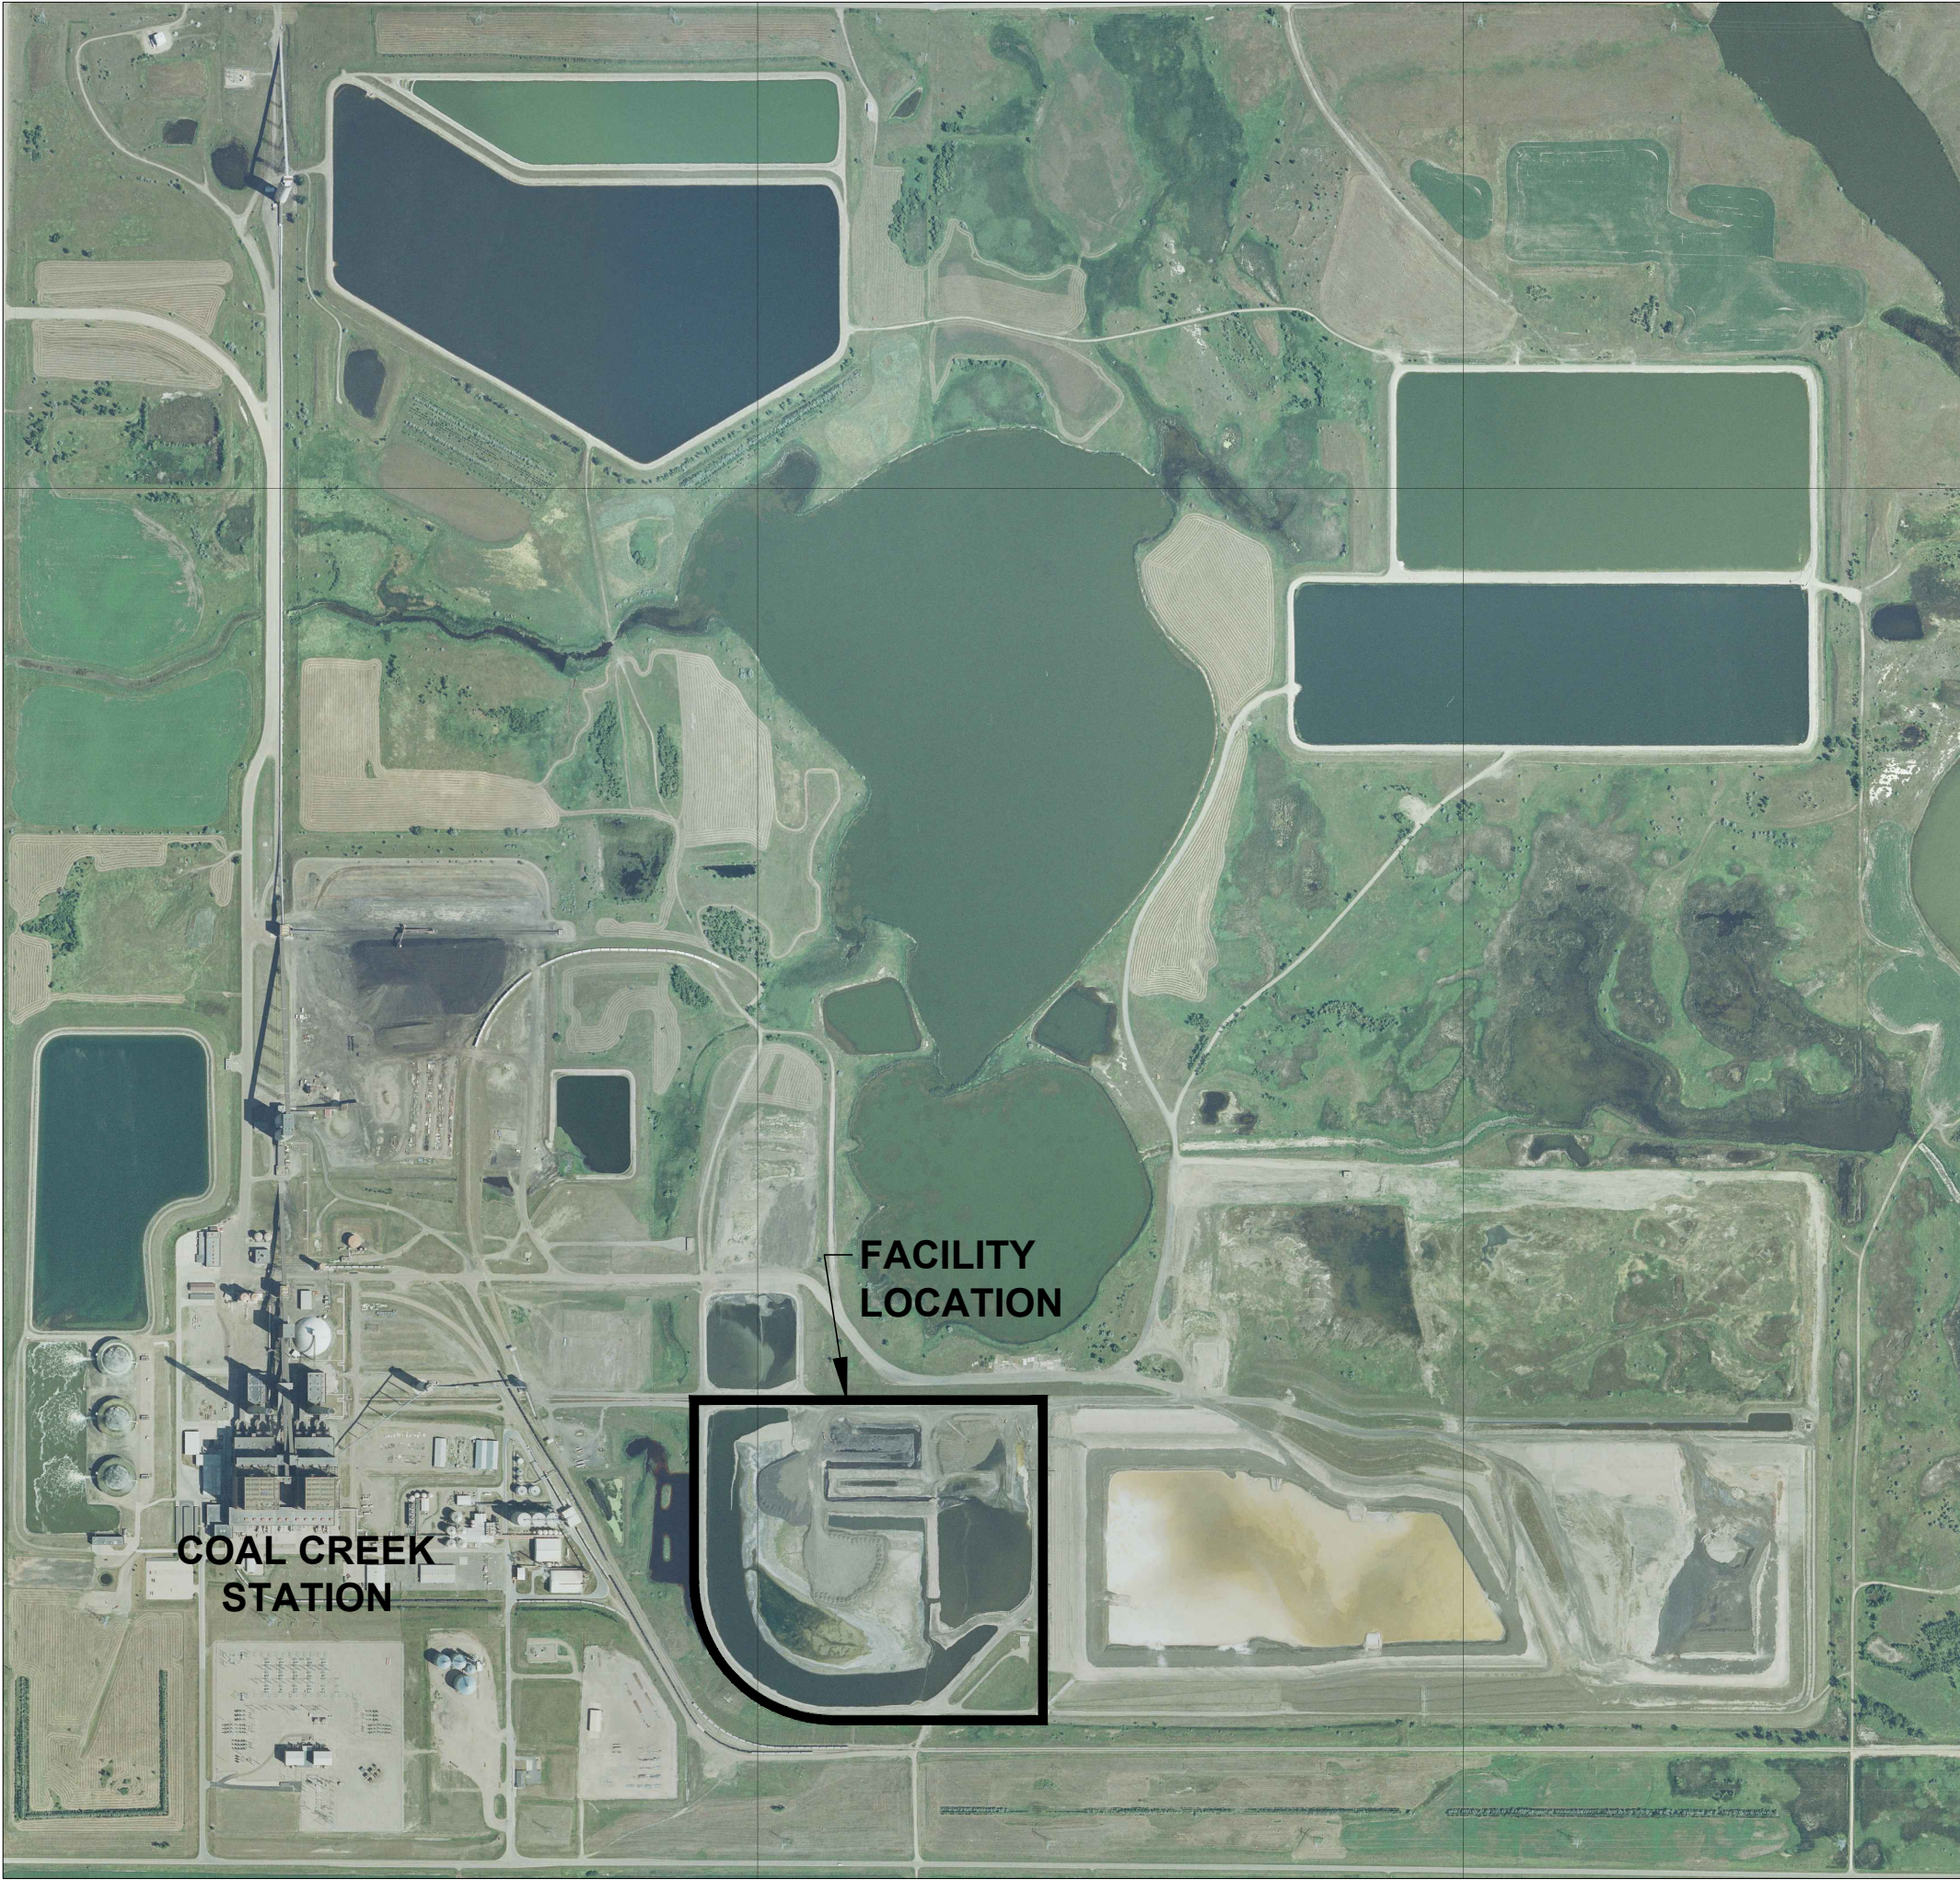

DRAWING LIST		
DRAWING NO.	TITLE	REVISION
1	TITLE SHEET	B
2	EXISTING CONDITIONS	B
3	PROPOSED TOP OF LINER	B
4	PROPOSED FINAL CCP GRADES	B
5	FINAL COVER GRADES AND SURFACE WATER PLAN	B
6	CROSS SECTIONS	B
7	SECTION DETAILS	B
8	LINER DETAILS	B
9	HYDRAULIC DETAILS	B
10	COVER DETAILS	B

B	2015-02-11	ISSUED FOR PERMIT MODIFICATION	CCS	CCS	TJS	RRJ	
A	2014-11-10	ISSUED FOR CLIENT REVIEW	CCS	CCS	TJS	RRJ	
Rev.	YYYY-MM-DD	DESCRIPTION	PREPARED	DESIGN	REVIEW	APPROVED	

SEAL

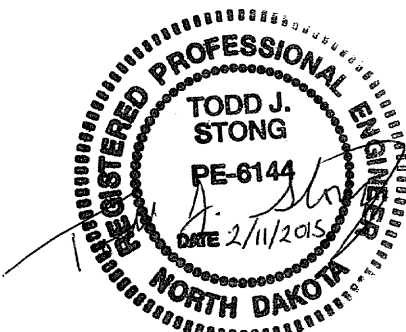

CLIENT



GREAT RIVER ENERGY  
COAL CREEK STATION  
UNDERWOOD, NORTH DAKOTA

CONSULTANT



GOLDER ASSOCIATES INC.  
44 UNION BLVD, SUITE 300  
LAKEWOOD, COLORADO  
USA  
(303) 980-0540  
www.golder.com


PROJECT  
ASH POND 91  
PERMIT NO. 0033 MODIFICATION

TITLE  
TITLE SHEET

Path: I:\Denver\golder\cgs\hcaat1\c11400644\AshPond91\Working\ | File Name: 1400644A001.dwg

1 in IF THIS MEASUREMENT DOES NOT MATCH WHAT IS SHOWN, THE SHEET SIZE HAS BEEN MODIFIED FROM ANSI D



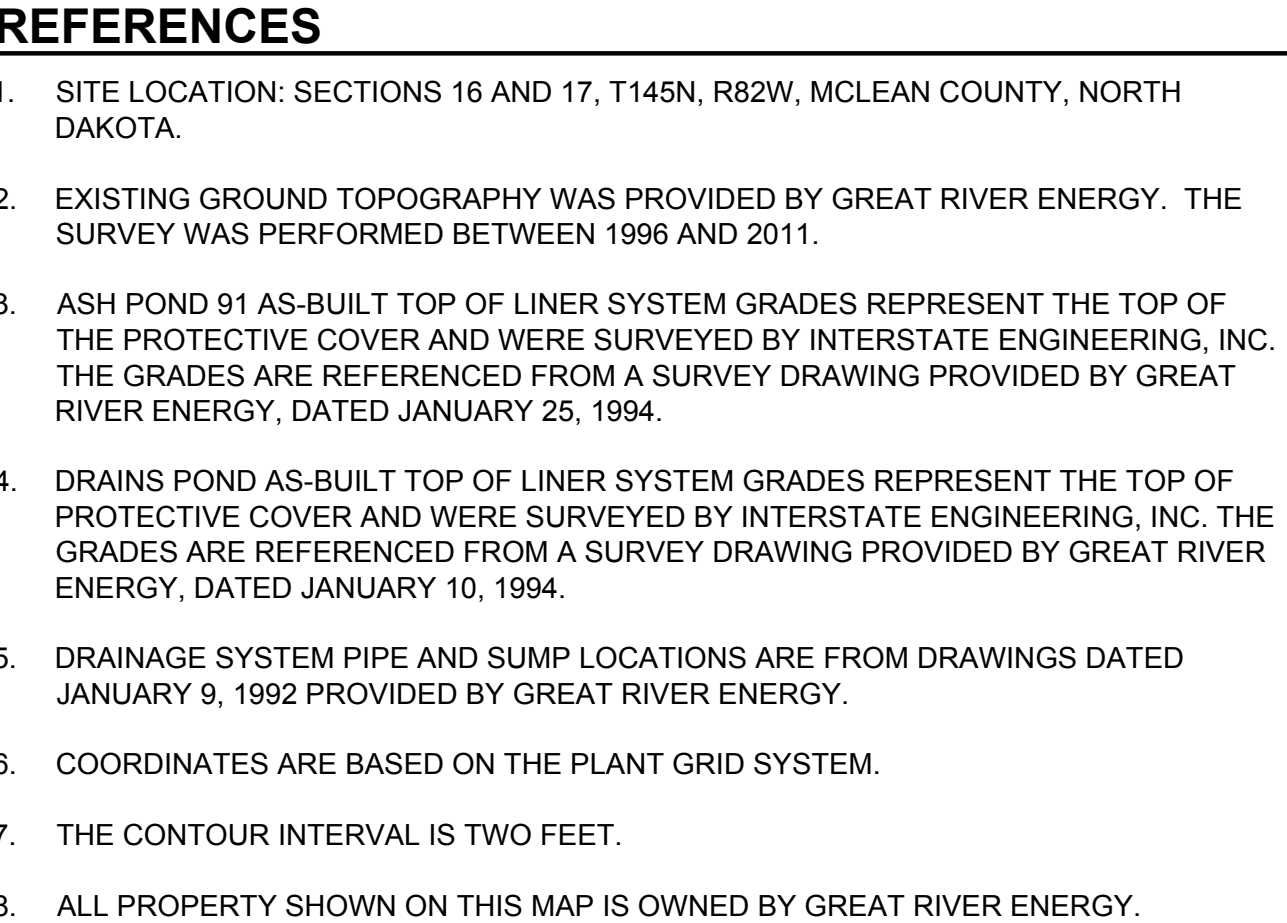

PROJECT  
 ASH POND 91  
 PERMIT NO. 0033 MODIFICATION

---


TITLE  
**EXISTING CONDITIONS**

---

PROJECT No.	Rev.	2 of 10	SHEET
1400644	B		2



Path: \\Denver-golder\golder\1411400644\AshPond91\Working\1 File Name: 1400644A003.dwg

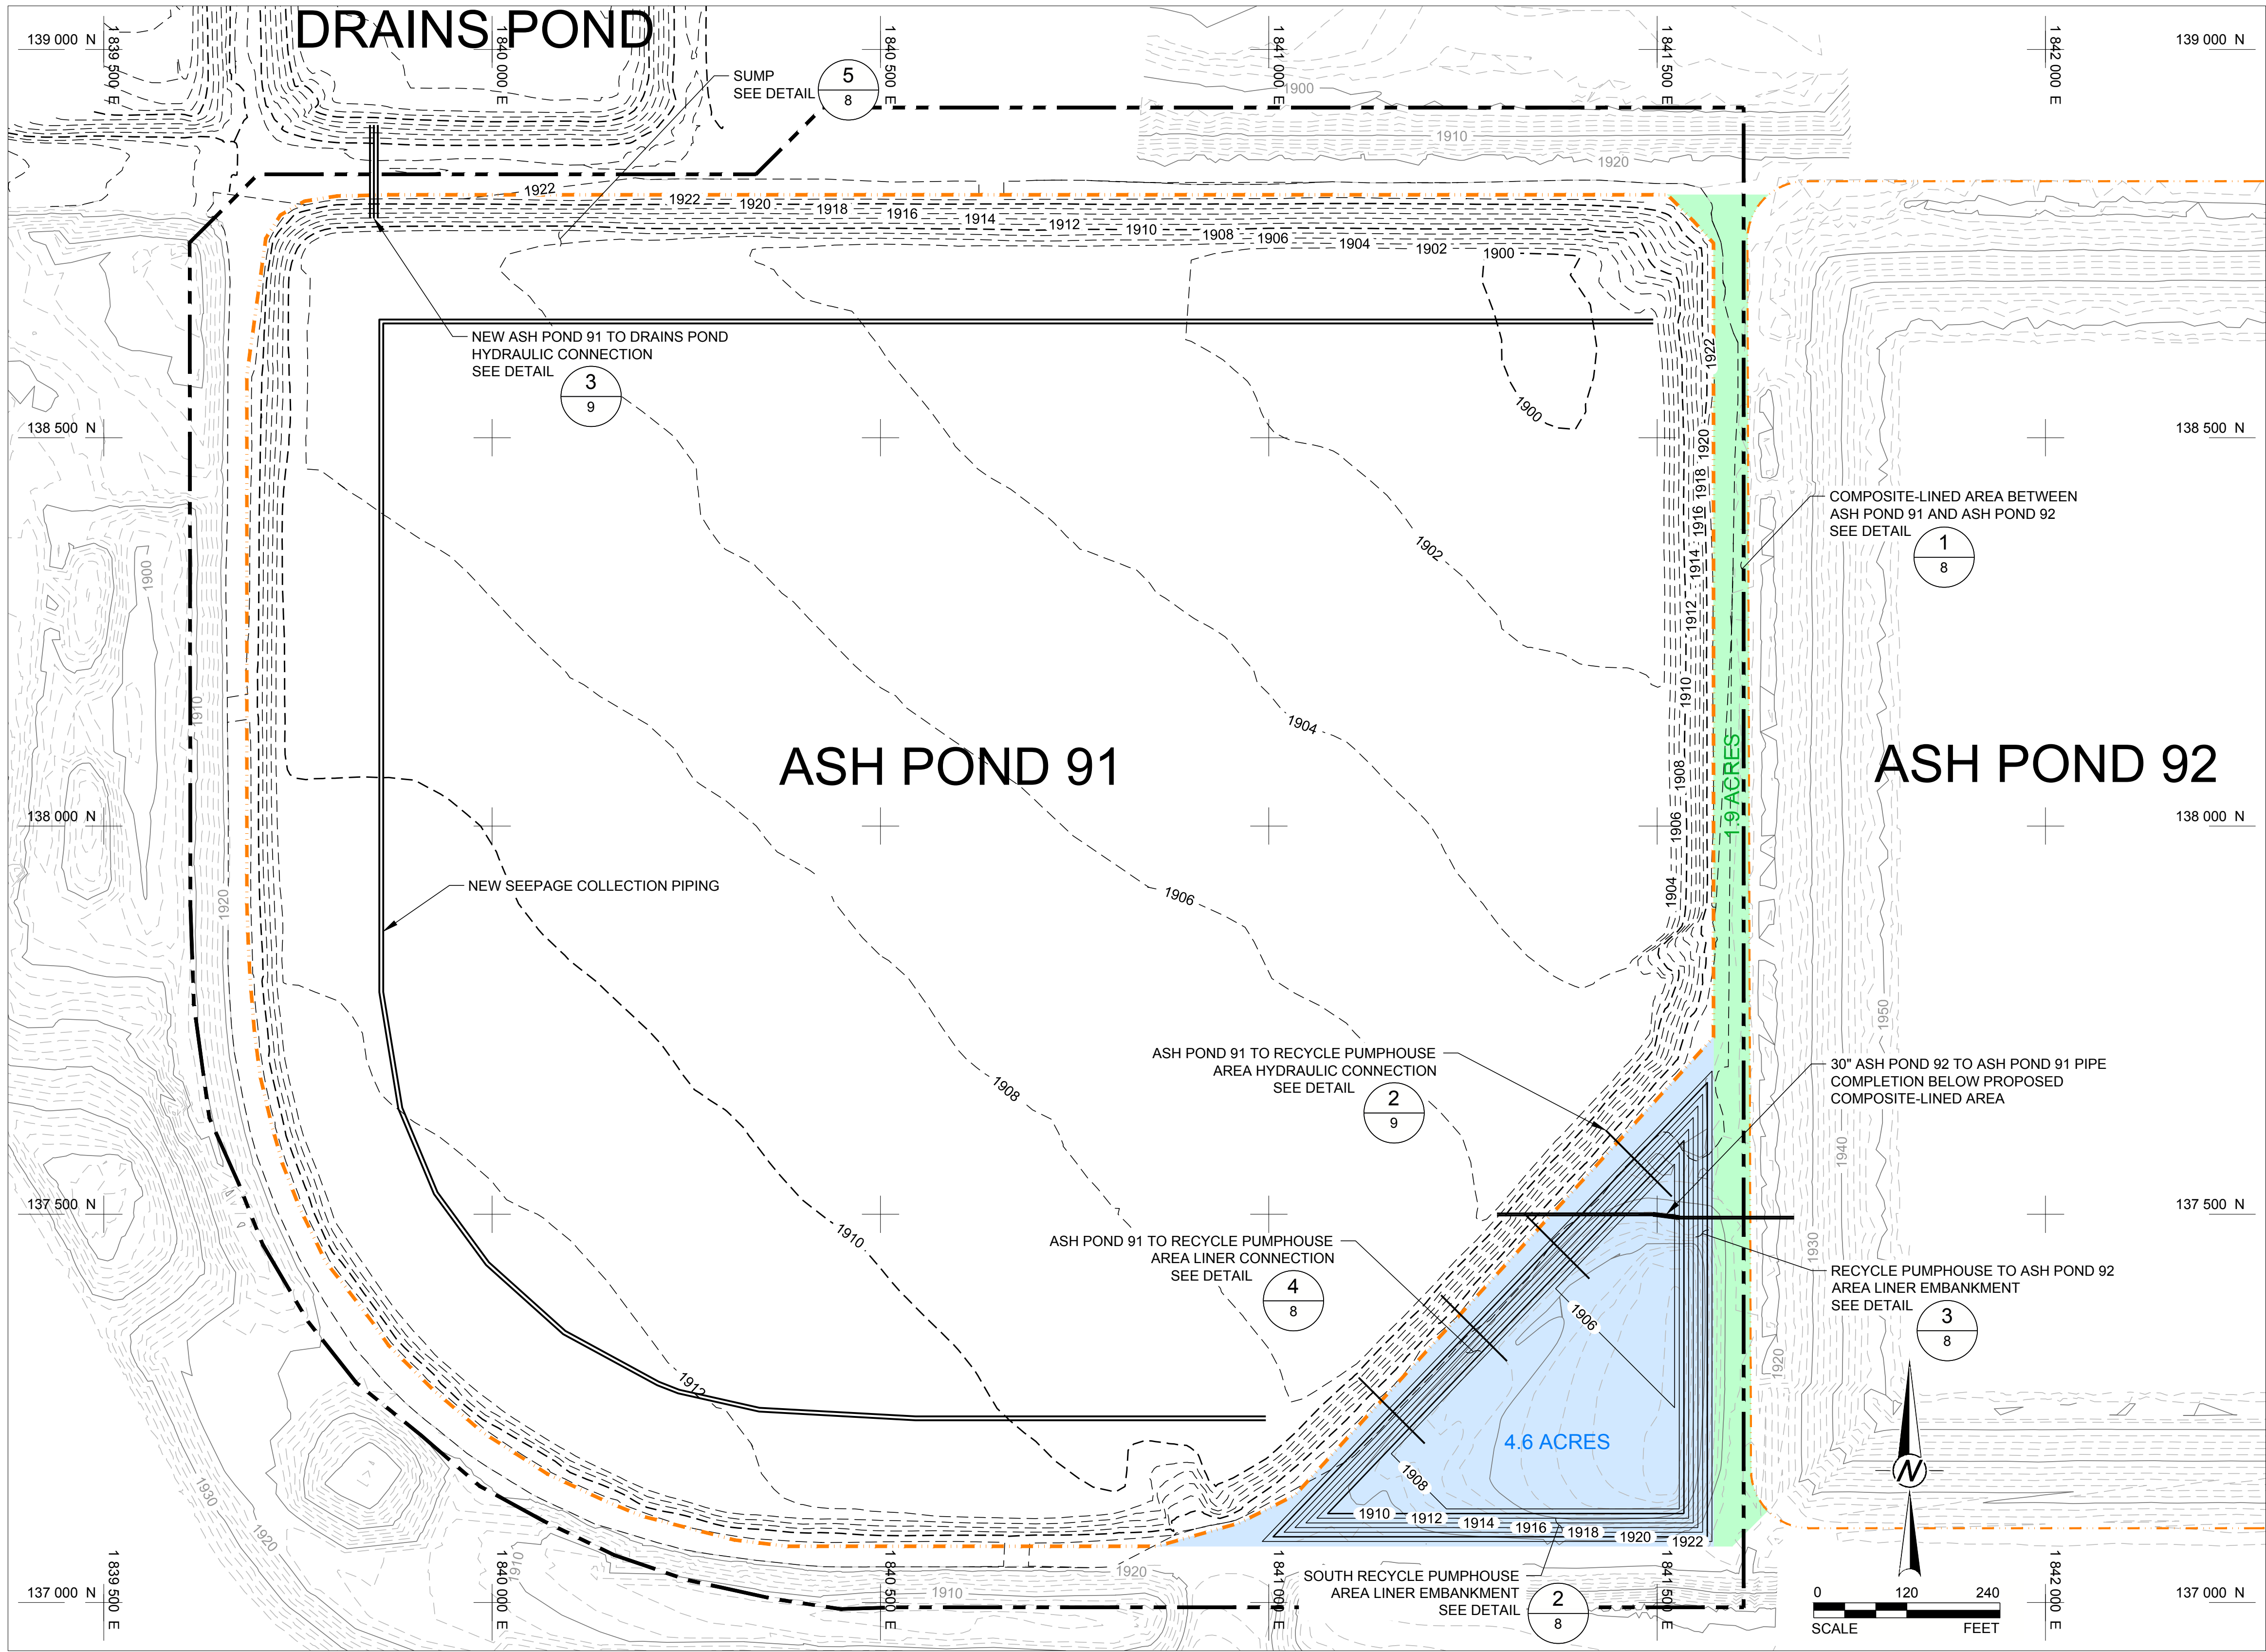

## LEGEND

- EXISTING GROUND TOPOGRAPHY (SEE REFERENCE 2)
- AS-BUILT TOP OF LINER SYSTEM GRADES (SEE REFERENCES 3 AND 4)
- PROPOSED TOP OF LINER SYSTEM GRADES
- PROPOSED COMPOSITE-LINED AREA (GEOMEMBRANE PLUS TWO FEET OF LOW PERMEABILITY SOIL)
- PROPOSED COMPOSITE-LINED AREA (GEOMEMBRANE PLUS GEOCOMPOSITE CLAY LINER)
- ASH POND 91 FACILITY BOUNDARY
- EXTENT OF EXISTING COMPOSITE LINER (APPROXIMATE)
- CROSS-OVER PIPING

## NOTES


- THE PROPOSED FACILITY BOUNDARY IS APPROXIMATE.
- EXISTING FLOOR AND CROSS-OVER PIPING NOT SHOWN FOR CLARITY.

## REFERENCES

- SITE LOCATION: SECTIONS 16 AND 17, T145N, R82W, MCLEAN COUNTY, NORTH DAKOTA.
- EXISTING GROUND TOPOGRAPHY WAS PROVIDED BY GREAT RIVER ENERGY. THE SURVEY WAS PERFORMED BETWEEN 1996 AND 2011.
- ASH POND 91 AS-BUILT TOP OF LINER SYSTEM GRADES REPRESENT THE TOP OF THE PROTECTIVE COVER AND WERE SURVEYED BY INTERSTATE ENGINEERING, INC. THE GRADES ARE REFERENCED FROM A SURVEY DRAWING PROVIDED BY GREAT RIVER ENERGY, DATED JANUARY 25, 1994.
- DRAINS POND AS-BUILT TOP OF LINER SYSTEM GRADES REPRESENT THE TOP OF PROTECTIVE COVER AND WERE SURVEYED BY INTERSTATE ENGINEERING, INC. THE GRADES ARE REFERENCED FROM A SURVEY DRAWING PROVIDED BY GREAT RIVER ENERGY, DATED JANUARY 10, 1994.
- COORDINATES ARE BASED ON THE PLANT GRID SYSTEM.
- THE CONTOUR INTERVAL IS TWO FEET.
- ALL PROPERTY SHOWN ON THIS MAP IS OWNED BY GREAT RIVER ENERGY.

B	2015-02-11	ISSUED FOR PERMIT MODIFICATION		CCS	CCS	TJS	RRJ
A	2014-11-10	ISSUED FOR CLIENT REVIEW		CCS	CCS	TJS	RRJ
Rev.	YYYY-MM-DD	DESCRIPTION		PREPARED	DESIGN	REVIEW	APPROVED

SEAL

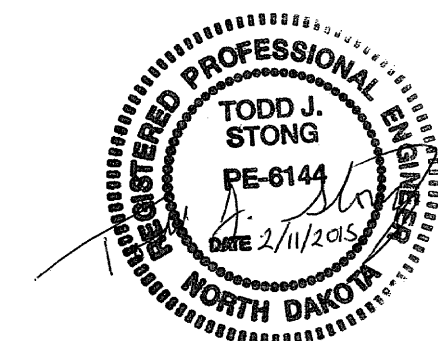

CLIENT



GREAT RIVER ENERGY  
COAL CREEK STATION  
UNDERWOOD, NORTH DAKOTA

CONSULTANT



GOLDER ASSOCIATES INC.  
44 UNION BLVD, SUITE 300  
LAKEWOOD, COLORADO  
USA  
(303) 980-0540  
www.golder.com

PROJECT  
ASH POND 91  
PERMIT NO. 0033 MODIFICATION

TITLE  
**PROPOSED TOP OF LINER**

1 in IF THIS MEASUREMENT DOES NOT MATCH WHAT IS SHOWN, THE SHEET SIZE HAS BEEN MODIFIED FROM ANSI D










IF THIS MEASUREMENT DOES NOT MATCH WHAT IS SHOWN, THE SHEET SIZE HAS BEEN MODIFIED FROM: ANSI D





Path: \\Denver-golder-gsa\\asac\\141400644\\AshPondB1\\Working\\\_1 File Name: 14006442006.dwg

LEGEND

- ASH POND 92/SW SECTION 16 DESIGN TOP OF CCP
- EXISTING GROUND TOPOGRAPHY
- PROPOSED TOP OF COVER
- PROPOSED ASH POND 91 TOP OF CCP
- APPROXIMATE LINER/FLOOR TOPOGRAPHY

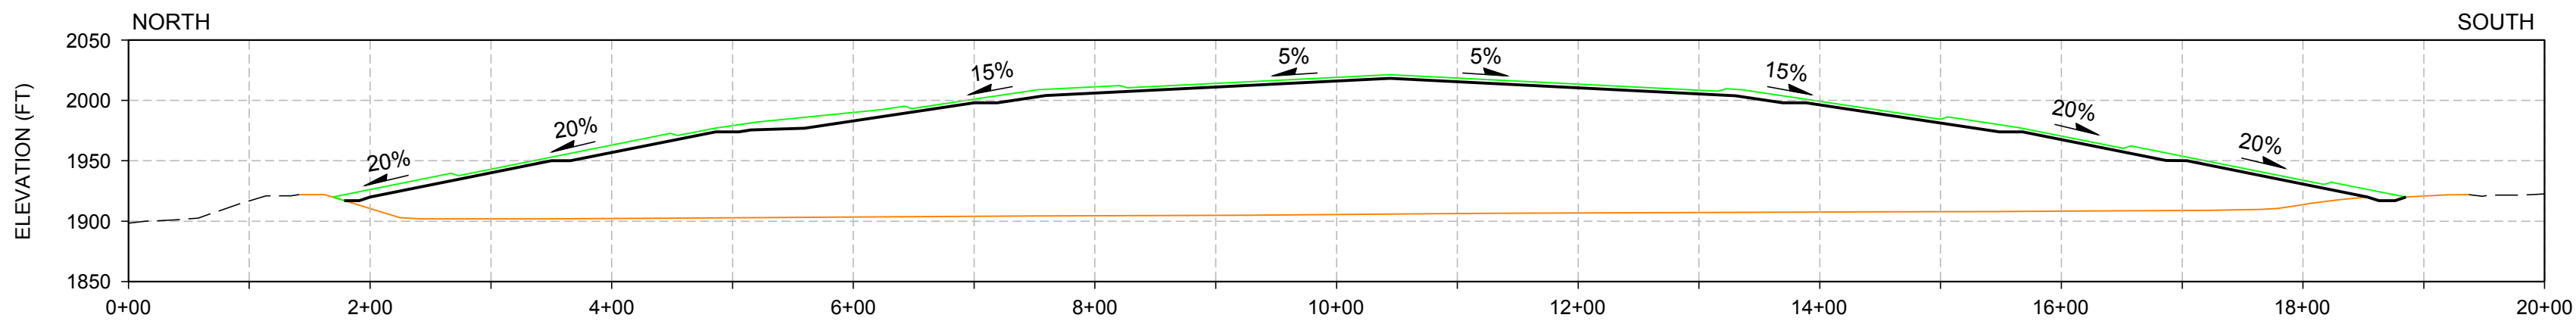

SECTION A - A'

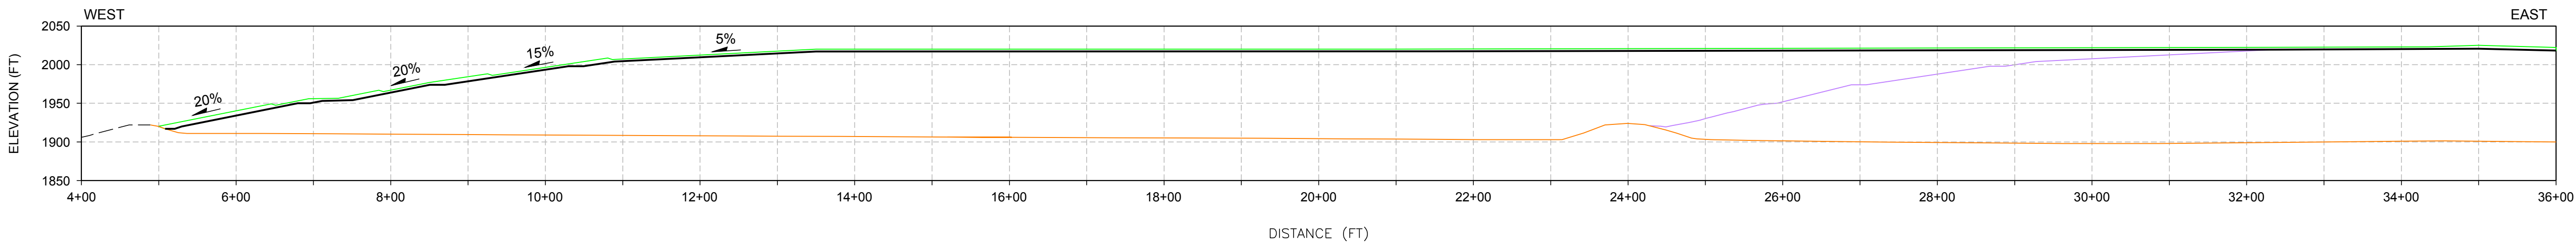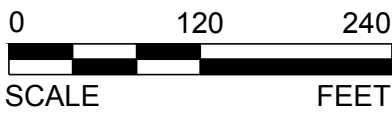


SECTION B - B'



B	2015-02-11	ISSUED FOR PERMIT MODIFICATION	RFS	CCS	TJS	RRJ
A	2014-11-10	ISSUED FOR CLIENT REVIEW	RFS	CCS	TJS	RRJ
Rev.	YYYY-MM-DD	DESCRIPTION	PREPARED	DESIGN	REVIEW	APPROVED

SEAL

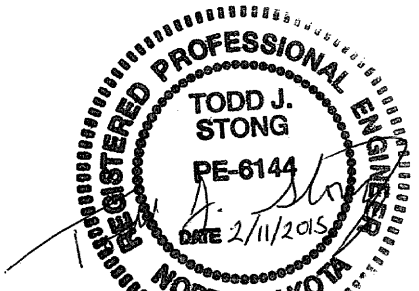

CLIENT



GREAT RIVER ENERGY  
COAL CREEK STATION  
UNDERWOOD, NORTH DAKOTA

CONSULTANT



GOLDER ASSOCIATES INC.  
44 UNION BLVD. SUITE 300  
LAKEWOOD, COLORADO  
USA  
(303) 980-0540  
www.golder.com

PROJECT  
ASH POND 91  
PERMIT NO. 0033 MODIFICATION

TITLE  
CROSS SECTIONS

PROJECT No.  
1400644


Rev.  
B 6 of 10

SHEET  
6


1 in. IF THIS MEASUREMENT DOES NOT MATCH WHAT IS SHOWN, THE SHEET SIZE HAS BEEN MODIFIED FROM ANSI D






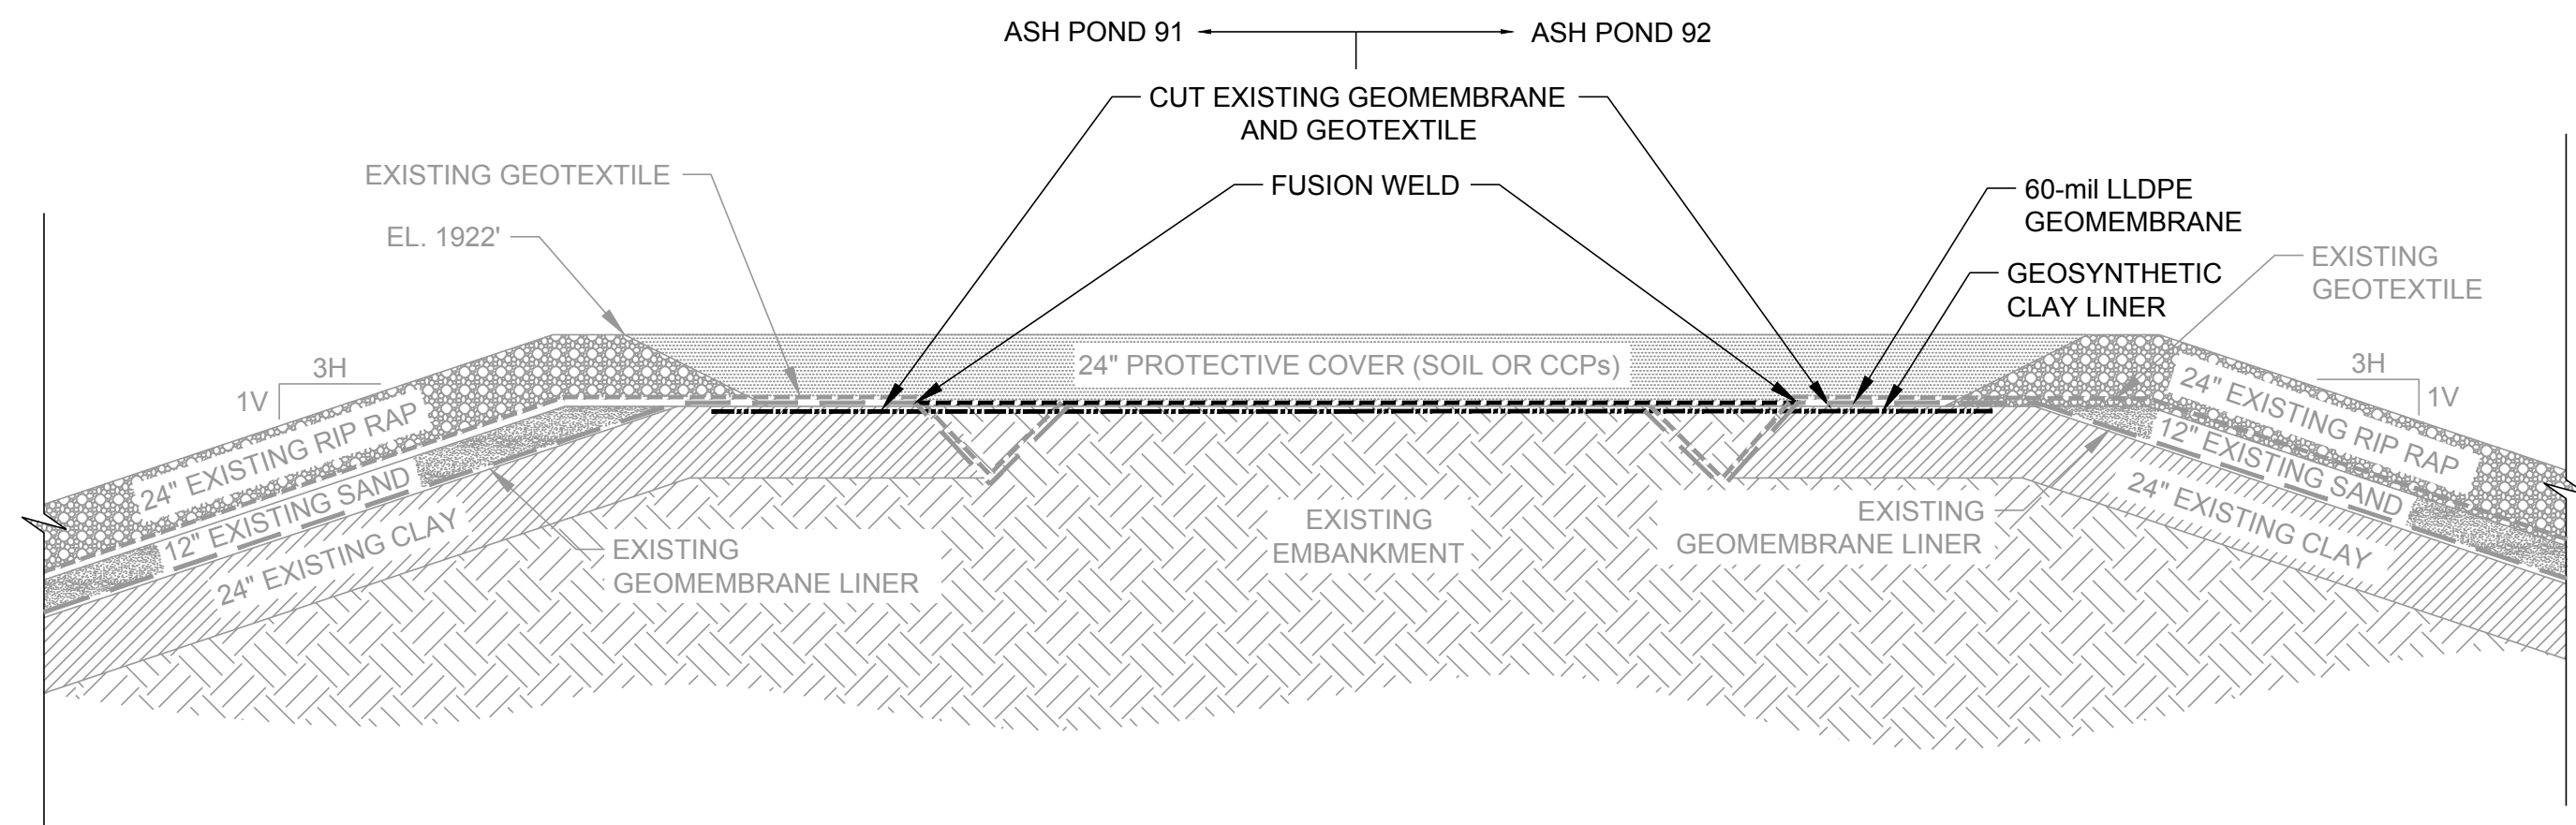


ASH POND 91 TO ASH POND 92 BERM CONNECTION  
N.T.S. 1/8

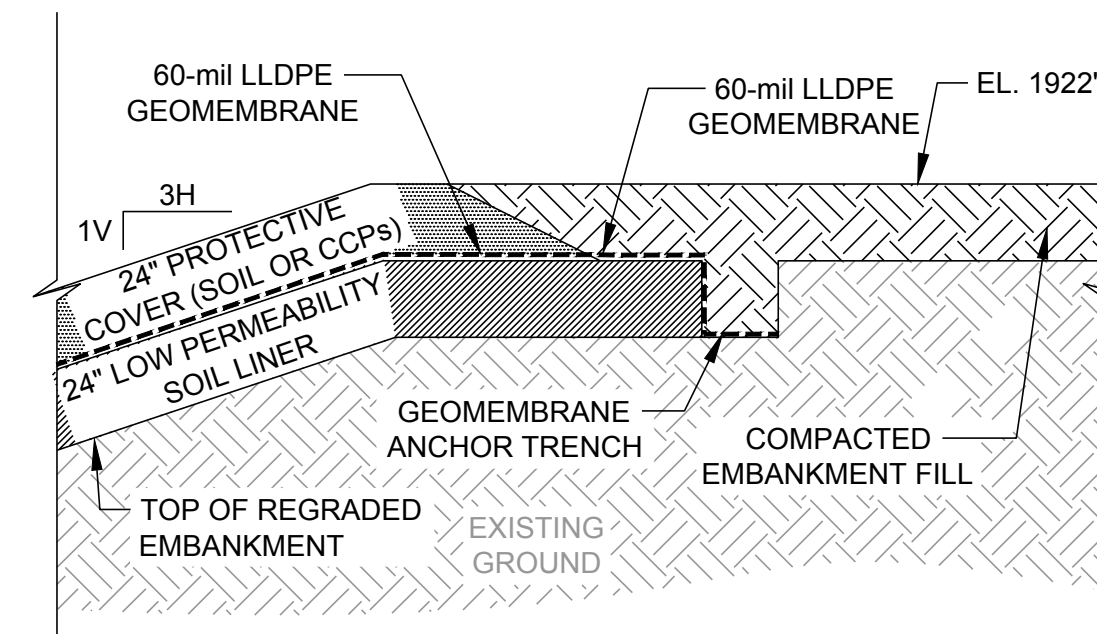


SOUTH RECYCLE PUMPHOUSE AREA LINER  
EMBANKMENT DETAIL  
N.T.S. 2/8

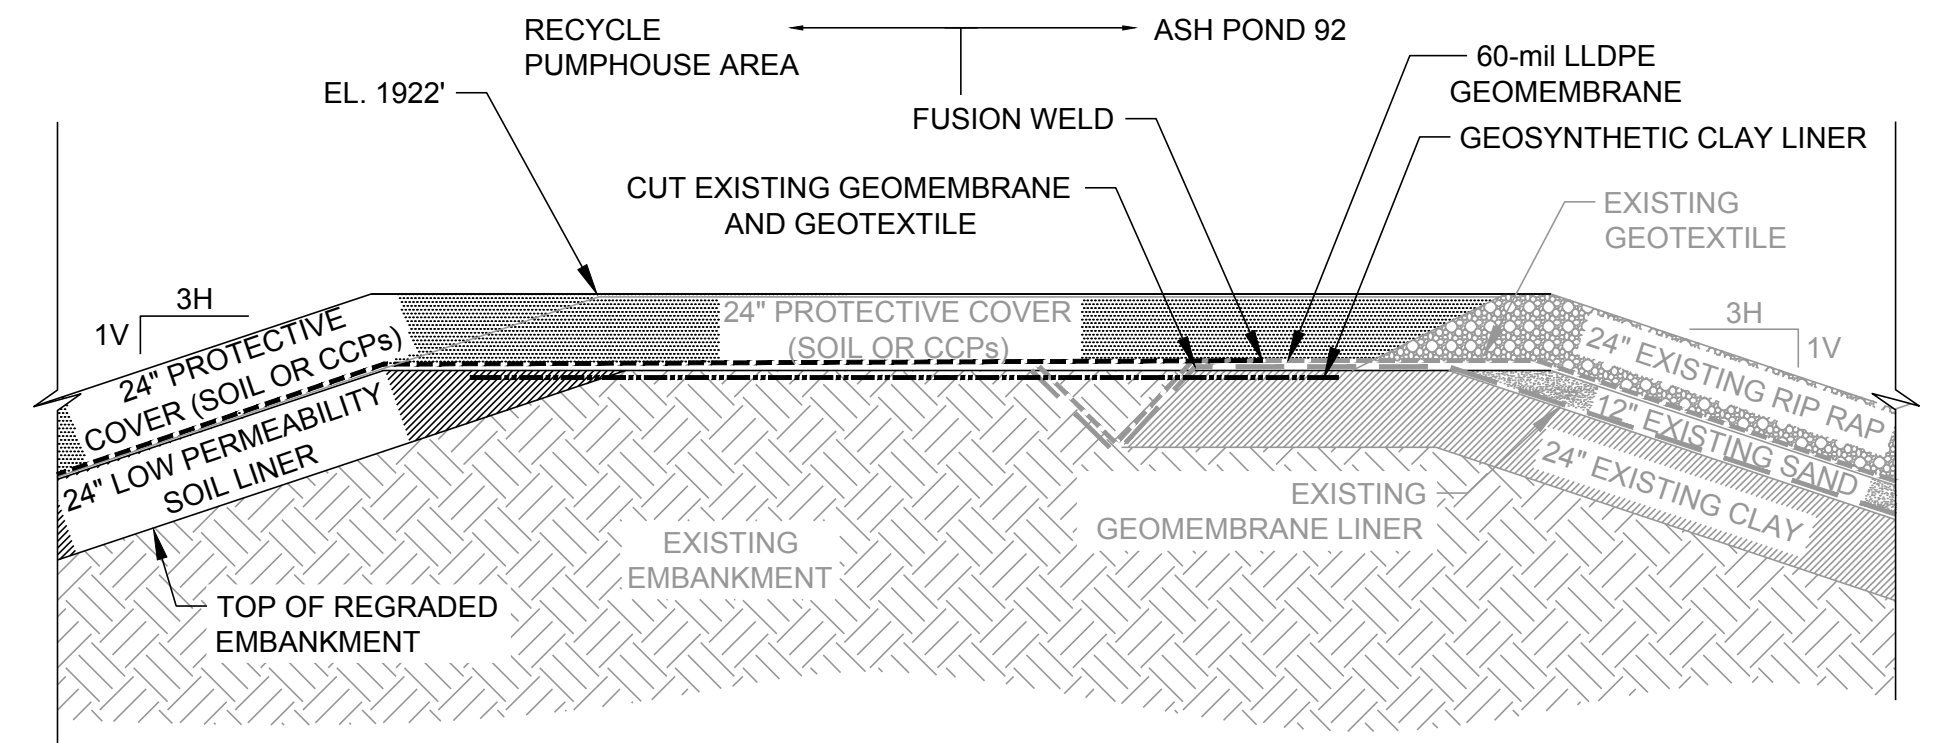


RECYCLE PUMPHOUSE AREA TO ASH POND 92  
LINER CONNECTION DETAIL  
N.T.S. 3/8

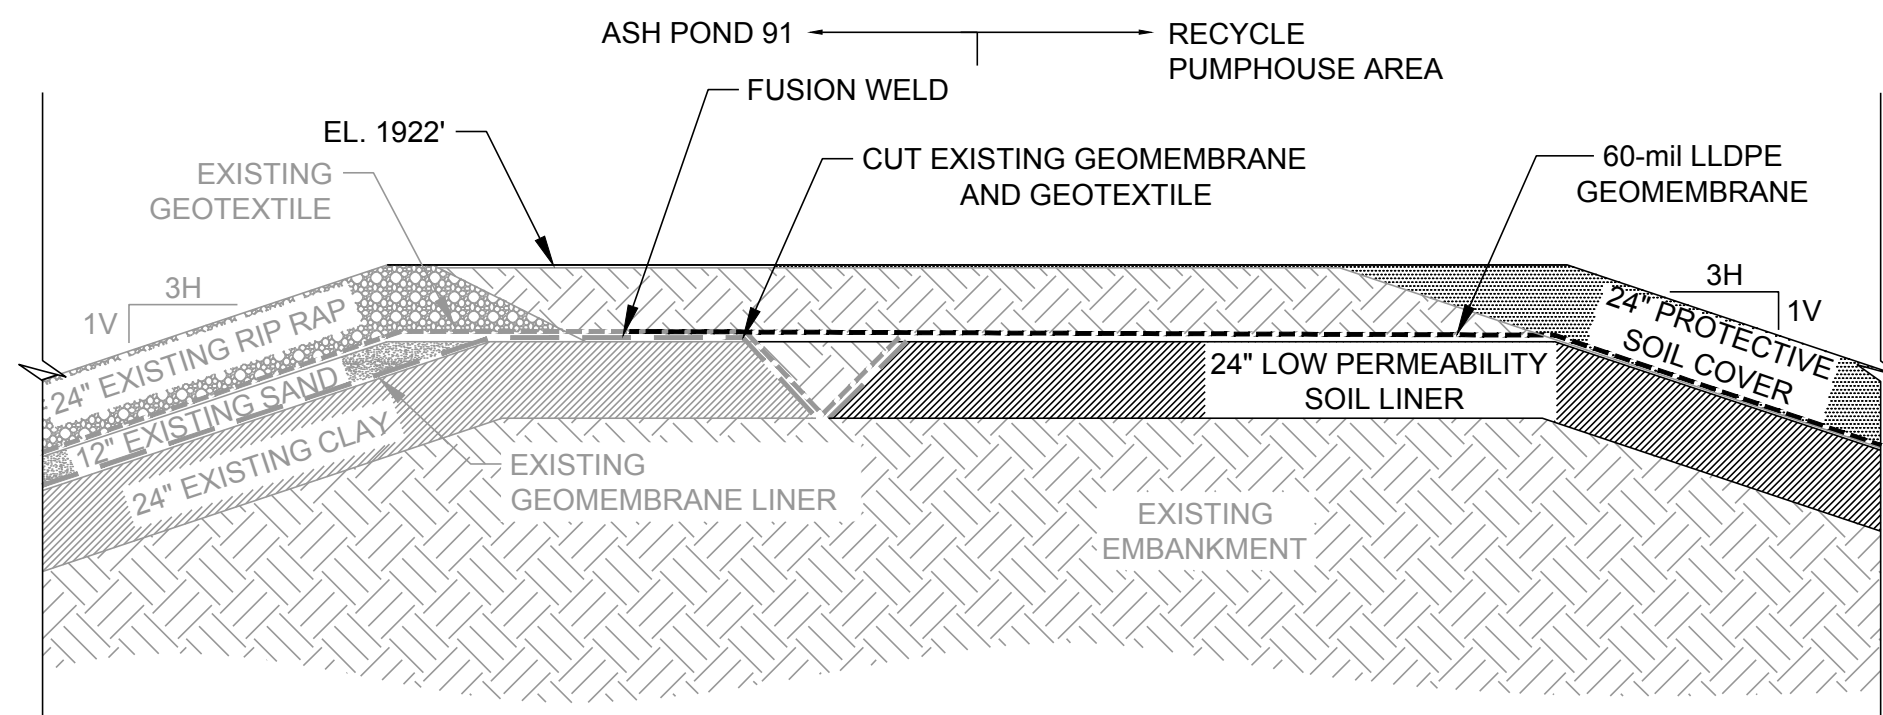

ASH POND 91 TO RECYCLE PUMPHOUSE AREA  
LINER CONNECTION DETAIL  
N.T.S. 4/8

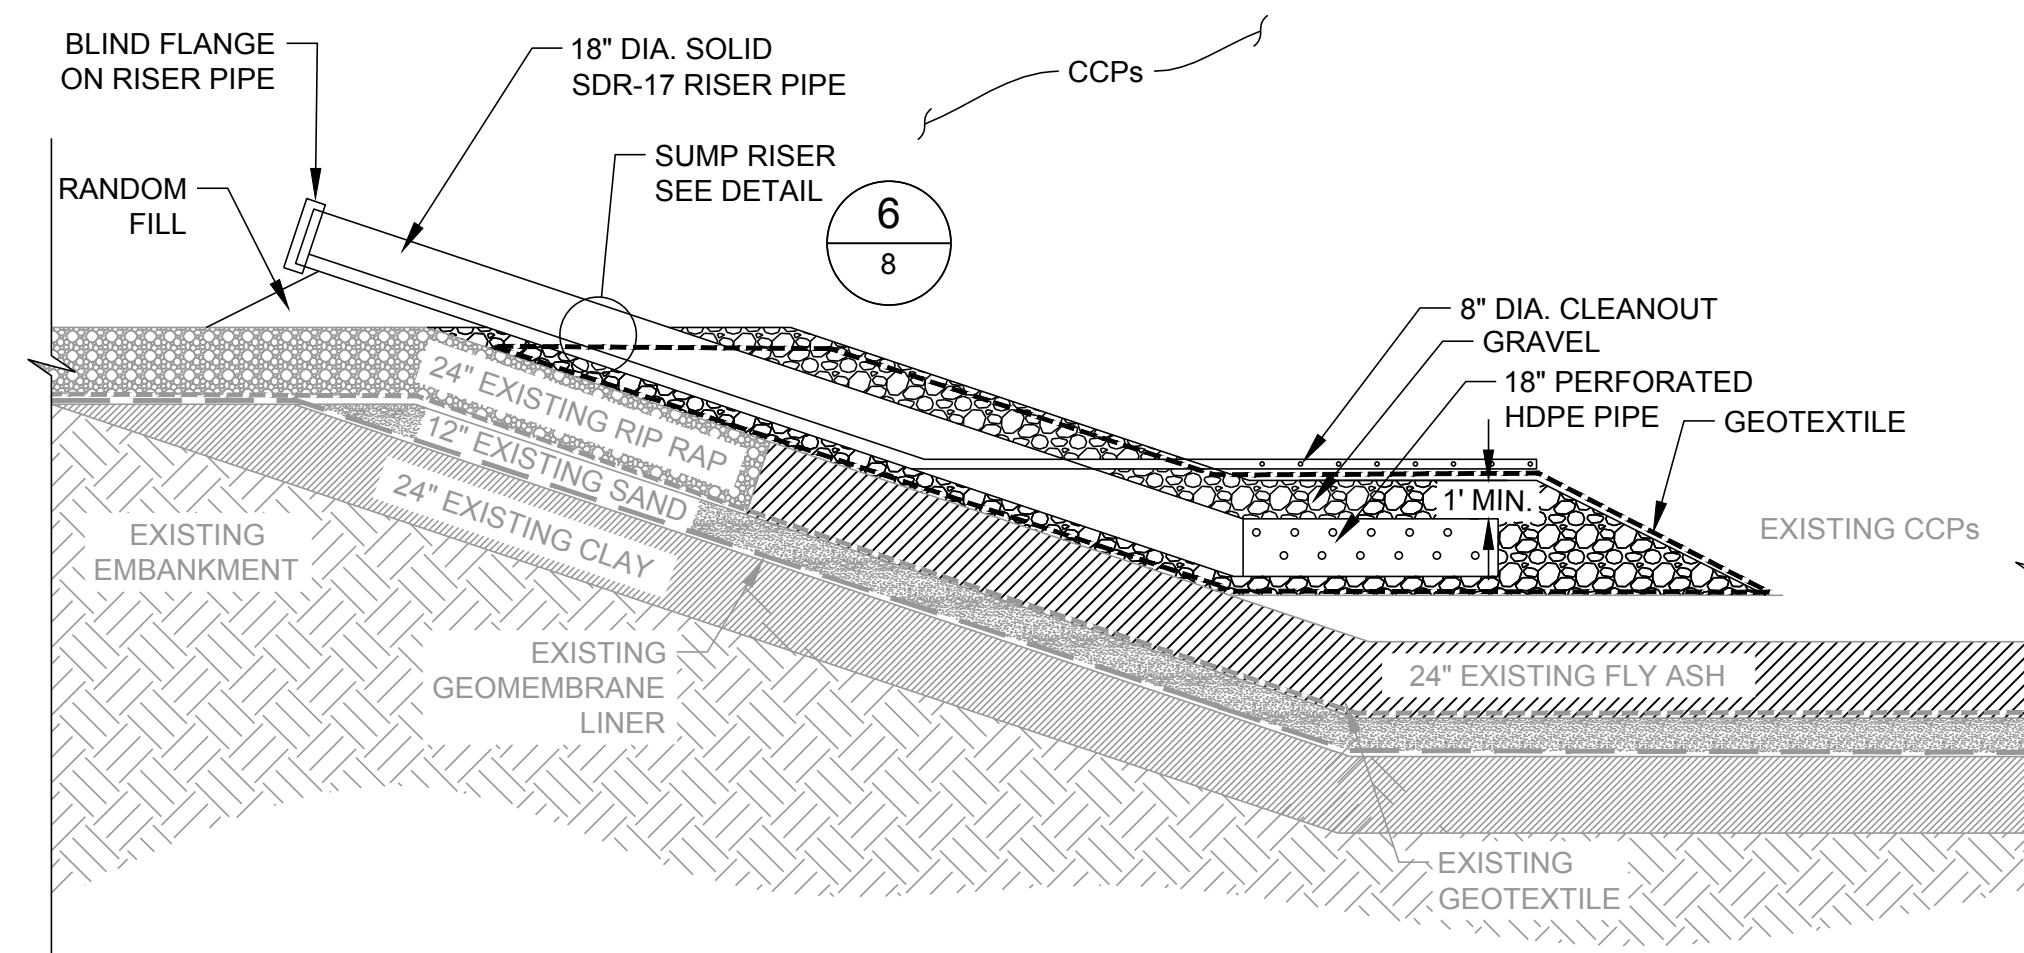

SUMP DETAIL  
N.T.S. 5/8

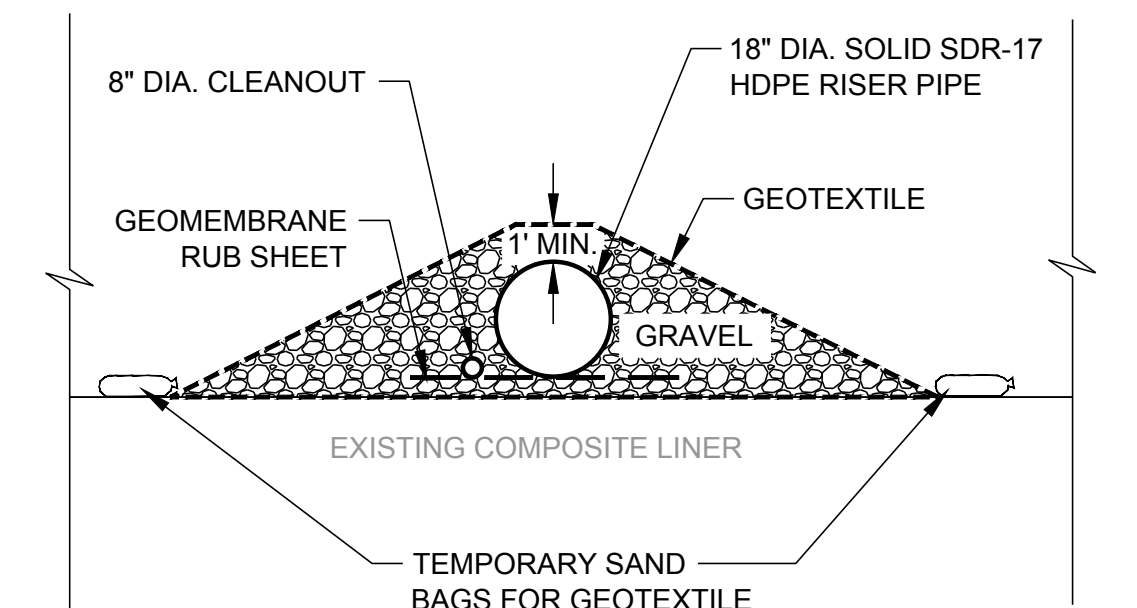


TYPICAL SUMP RISER DETAIL  
N.T.S. 6/8

Path: \\denver-golder\golder\1400644\AshPond91\Working\1400644\007.dwg  
1 in

B	2015-02-11	ISSUED FOR PERMIT MODIFICATION	RFS	RFS	TJS	RRJ
A	2014-11-10	ISSUED FOR CLIENT REVIEW	RFS	RFS	TJS	RRJ
Rev.	YYYY-MM-DD	DESCRIPTION	PREPARED	DESIGN	REVIEW	APPROVED

SEAL

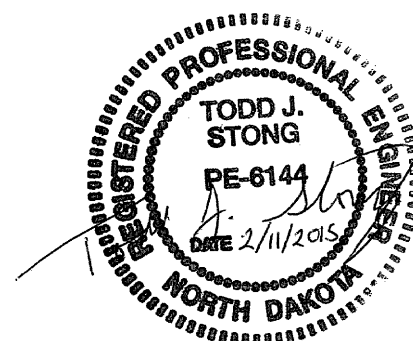

CLIENT



GREAT RIVER ENERGY  
COAL CREEK STATION  
UNDERWOOD, NORTH DAKOTA

CONSULTANT



GOLDER ASSOCIATES INC.  
44 UNION BLVD, SUITE 300  
LAKEWOOD, COLORADO  
USA  
(303) 980-0540  
www.golder.com

PROJECT  
ASH POND 91  
PERMIT NO. 0033 MODIFICATION

TITLE  
LINER DETAILS


PROJECT No.  
1400644

Rev. 8 of 10  
B


SHEET  
8

IF THIS MEASUREMENT DOES NOT MATCH WHAT IS SHOWN, THE SHEET SIZE HAS BEEN MODIFIED FROM ANSI D




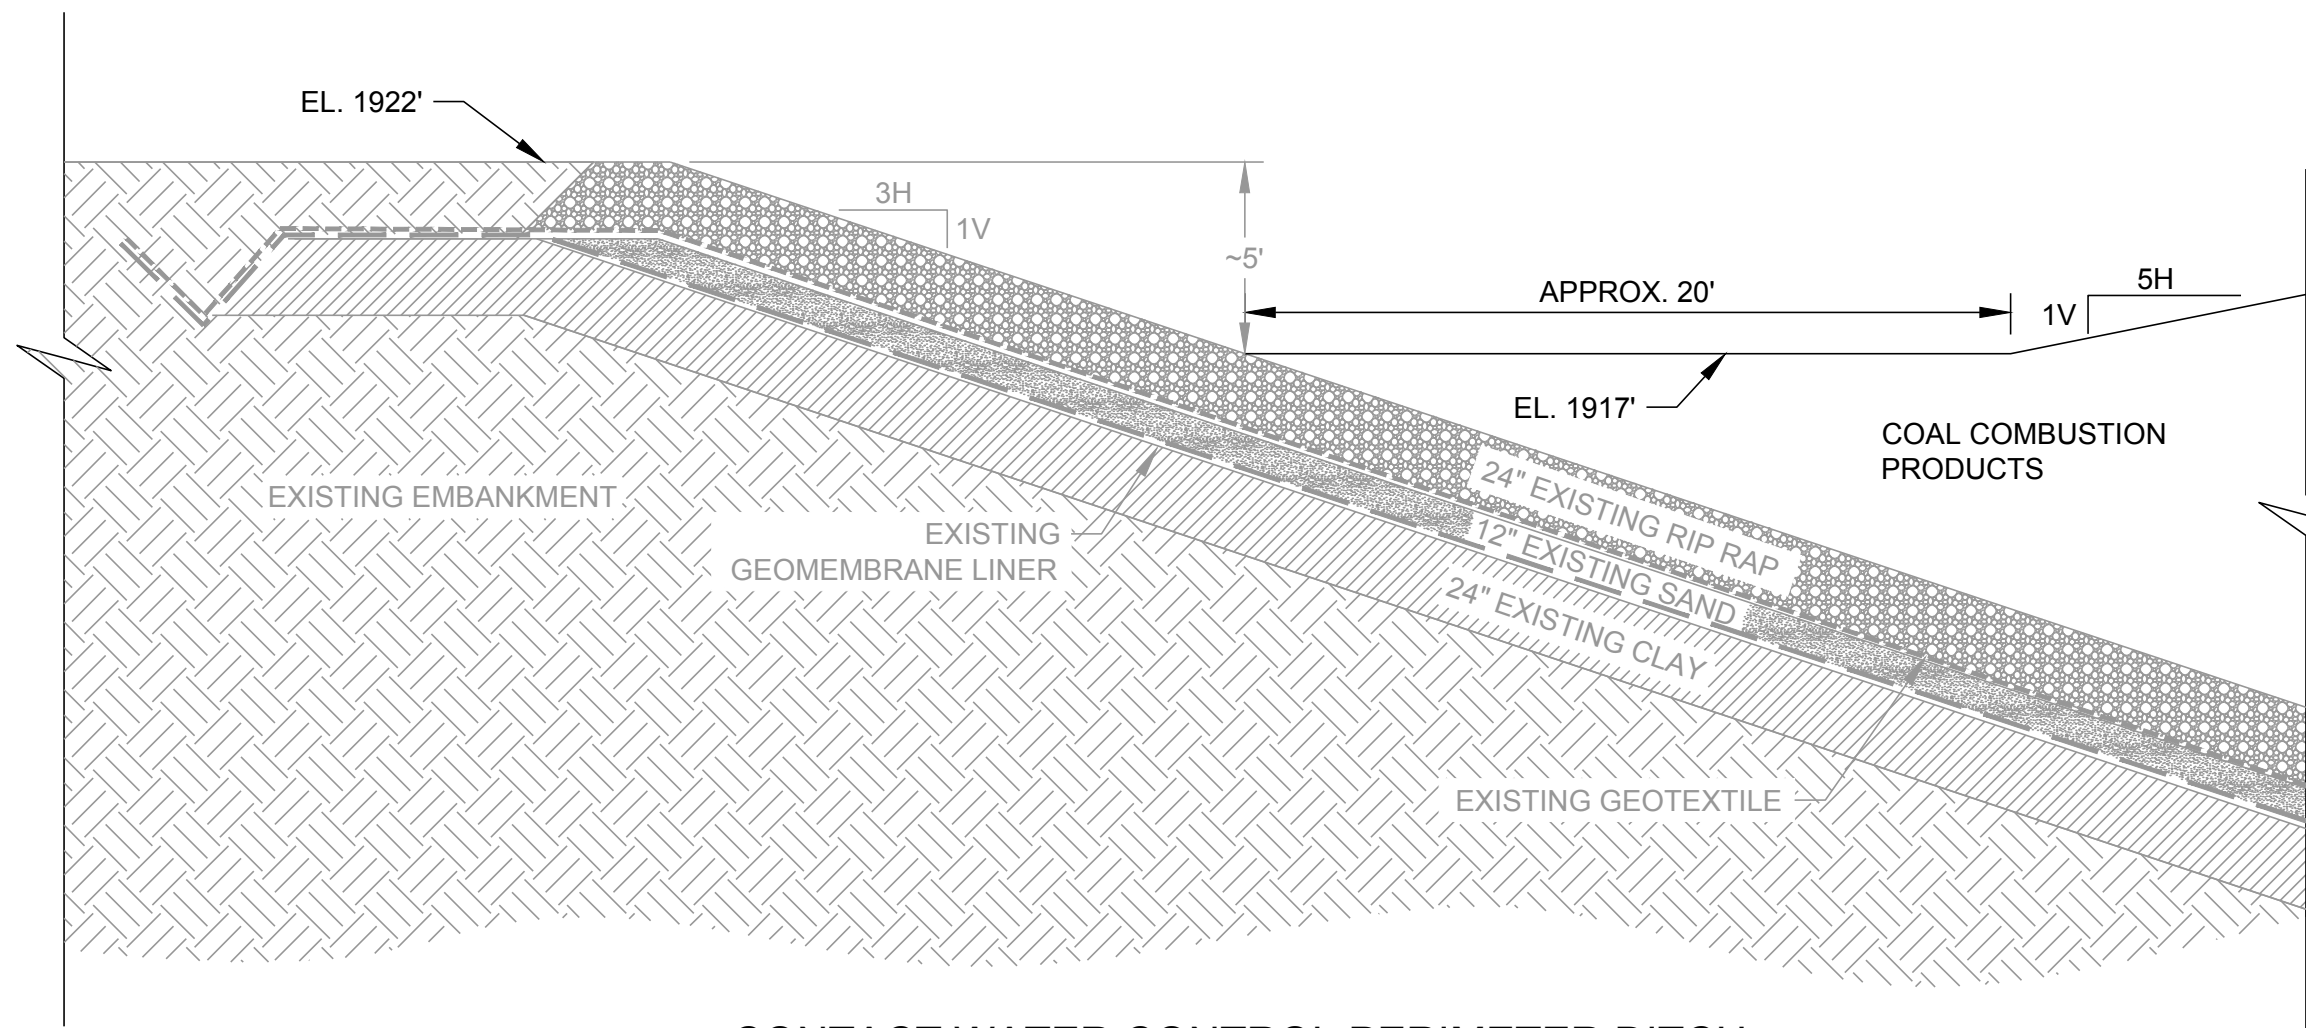


CONTACT WATER CONTROL PERIMETER DITCH  
DETAIL  
N.T.S. 1/9

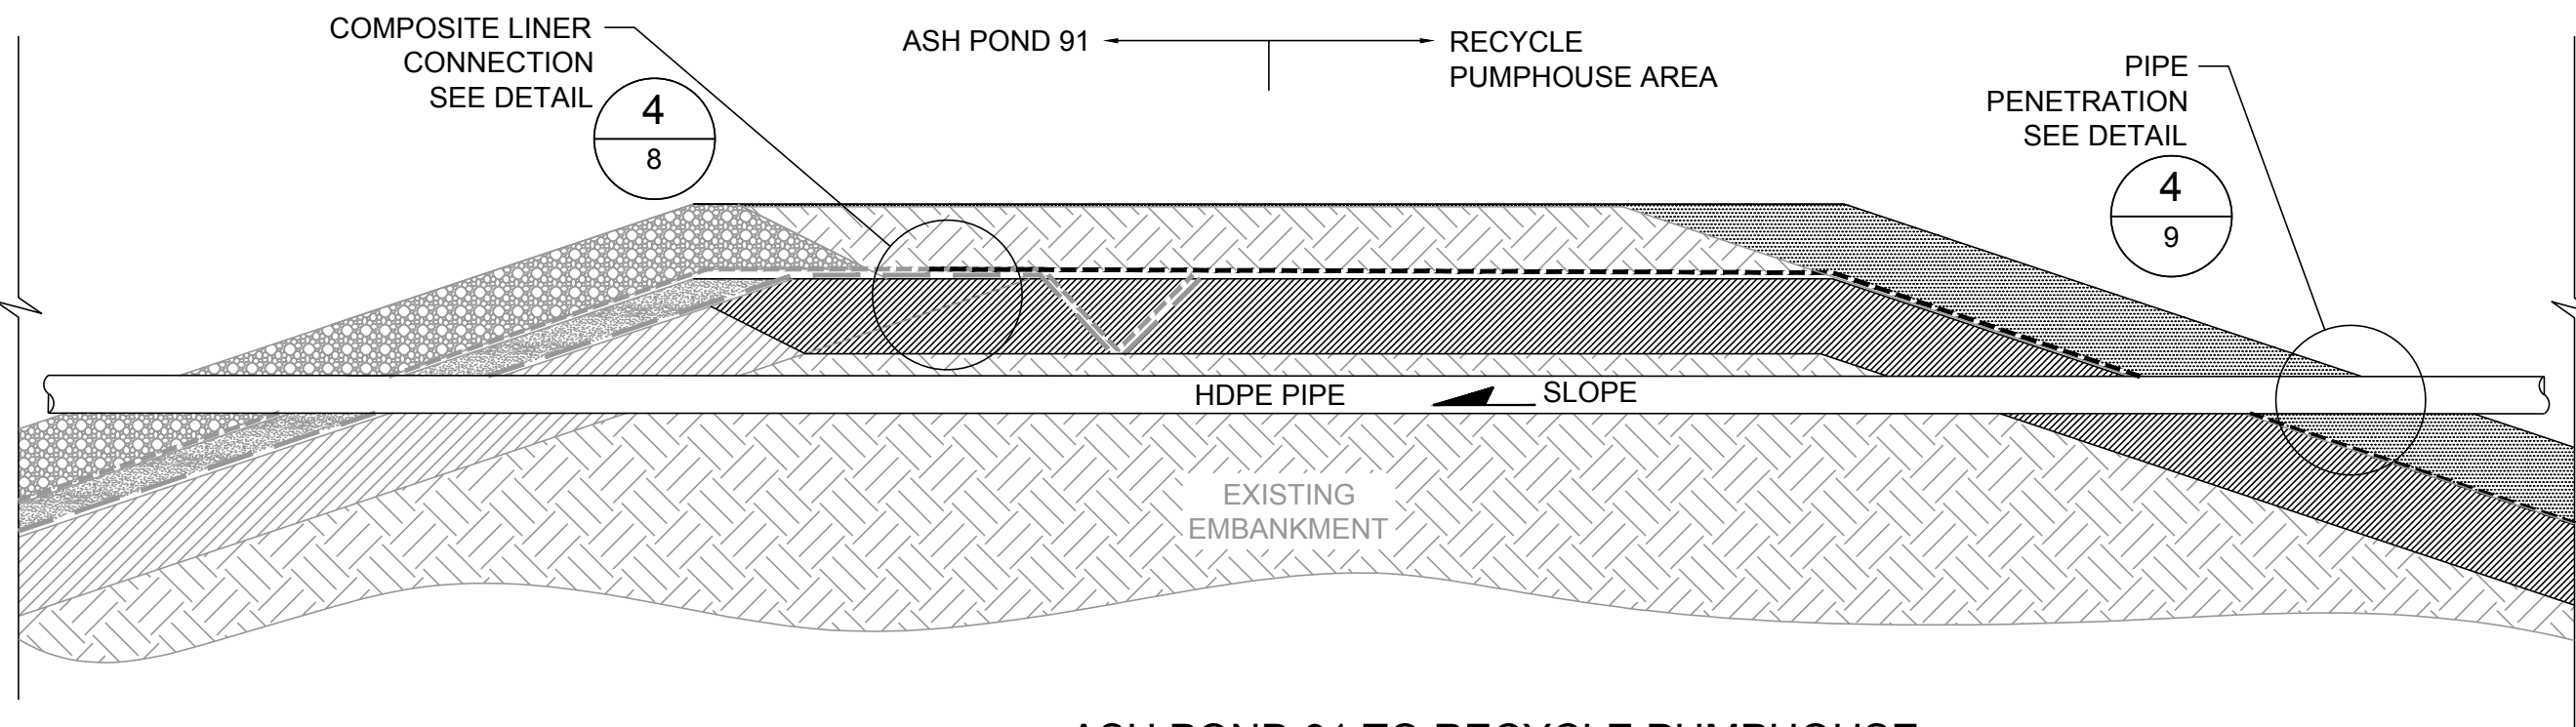


ASH POND 91 TO RECYCLE PUMPHOUSE  
HYDRAULIC CONNECTION DETAIL  
N.T.S. 2/9

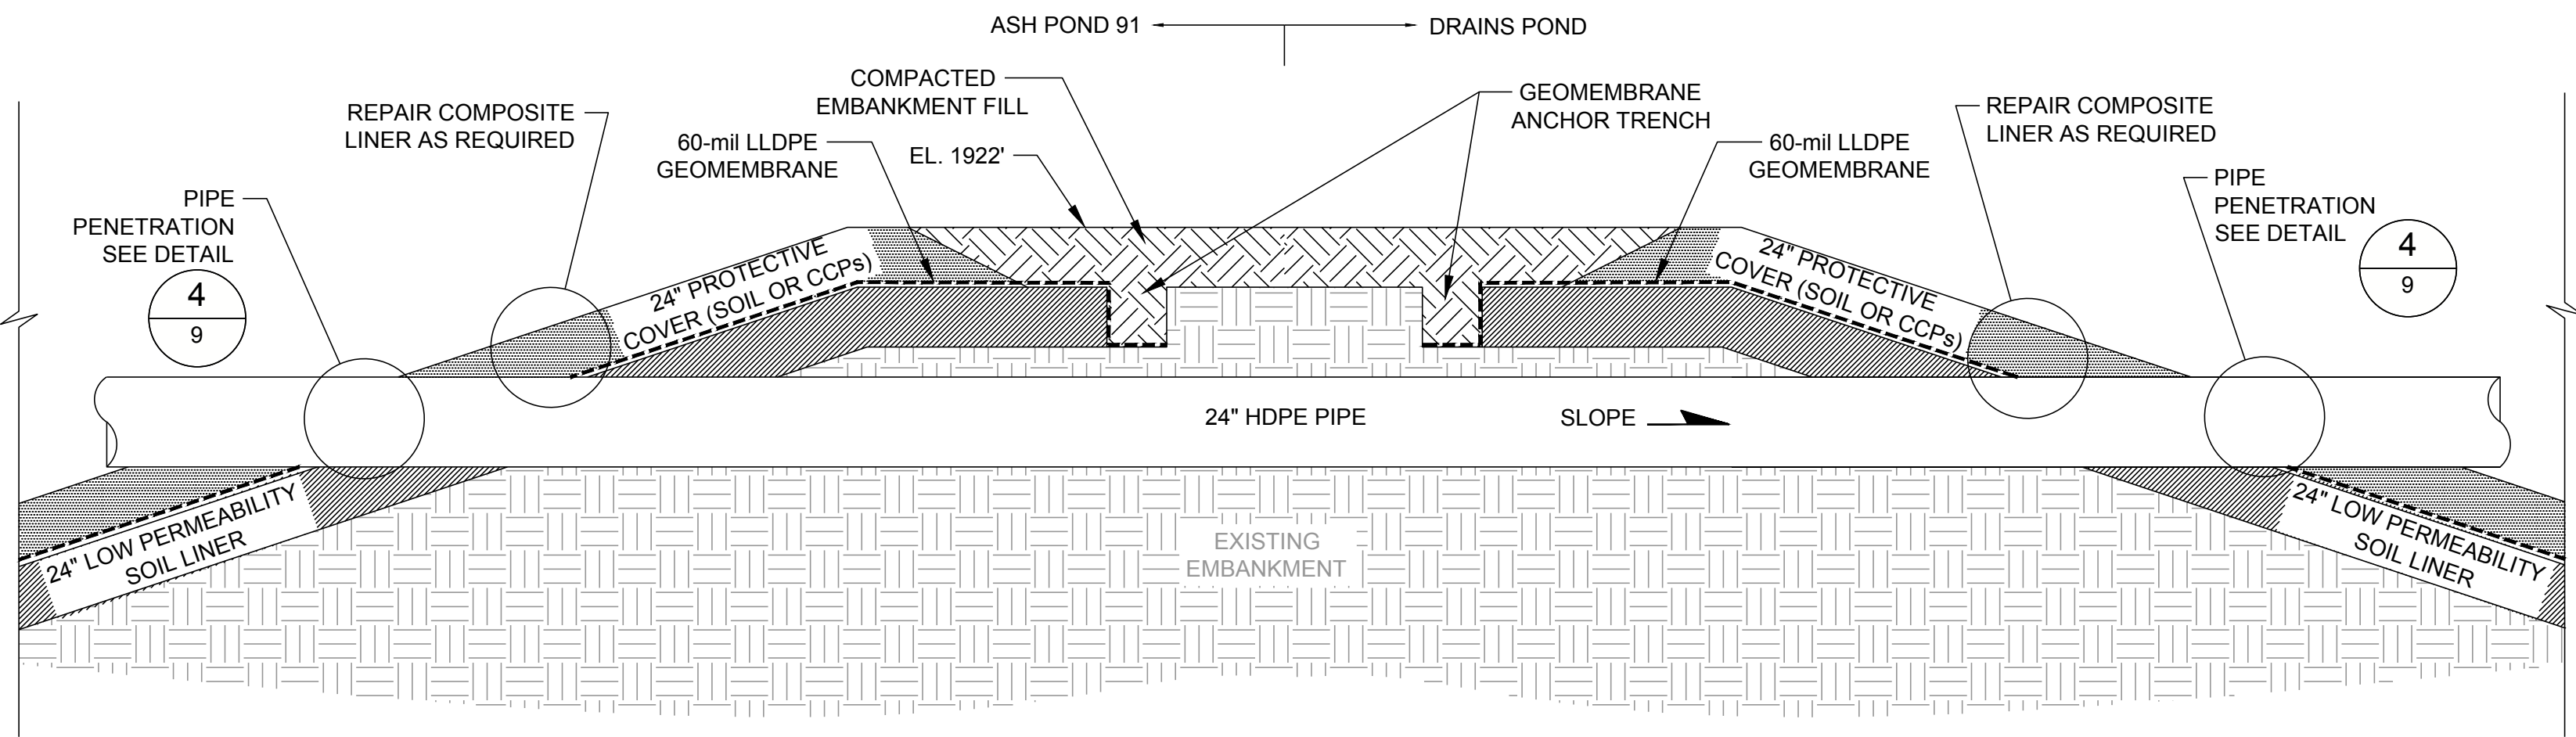

ASH POND 91 TO DRAINS POND HYDRAULIC  
CONNECTION DETAIL  
N.T.S. 3/9

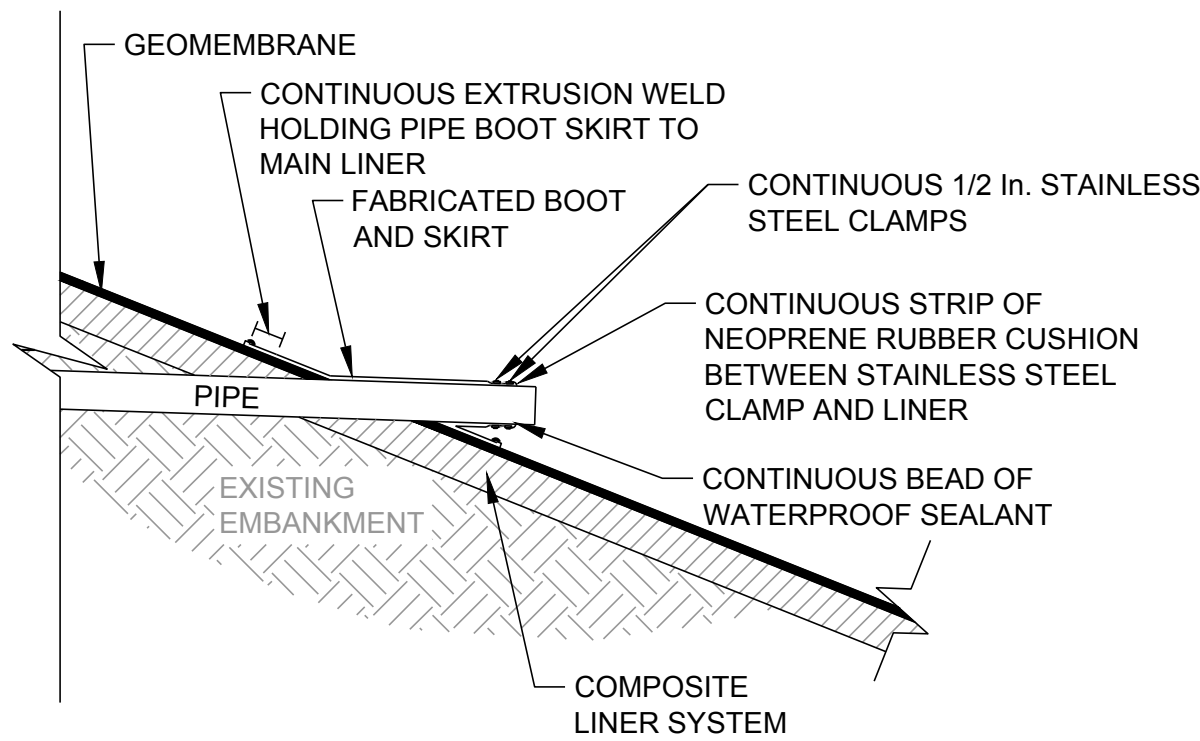


PIPE PENETRATION DETAIL  
N.T.S. 4/9

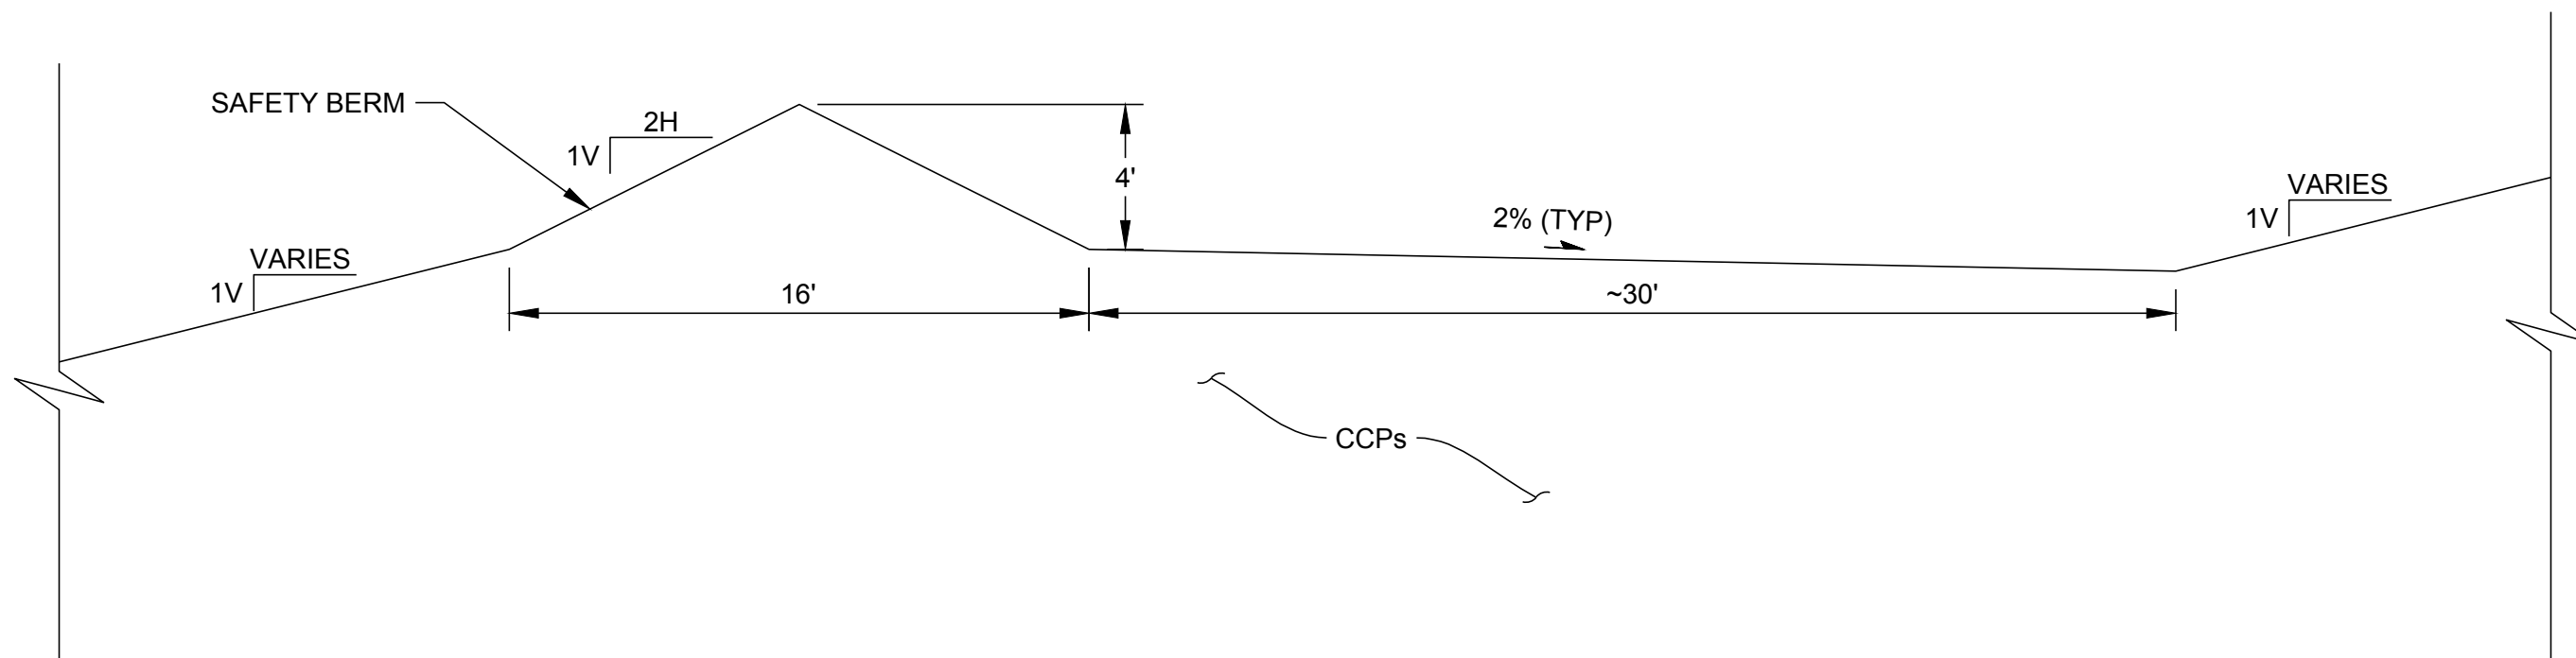

ACCESS HAUL ROAD DETAIL  
N.T.S. 5/9

SEAL

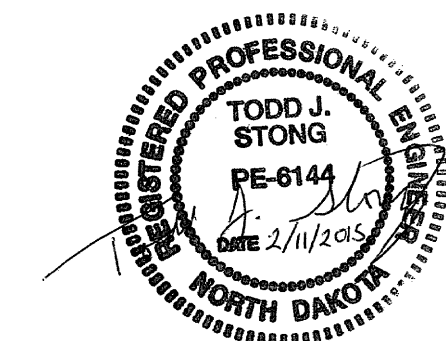

CLIENT



GREAT RIVER ENERGY  
COAL CREEK STATION  
UNDERWOOD, NORTH DAKOTA

CONSULTANT



GOLDER ASSOCIATES INC.  
44 UNION BLVD, SUITE 300  
LAKEWOOD, COLORADO  
USA  
(303) 980-0540  
www.golder.com

PROJECT  
ASH POND 91  
PERMIT NO. 0033 MODIFICATION

TITLE  
HYDRAULIC DETAILS


PROJECT No.  
1400644

Rev.  
B


9 of 10

SHEET


9

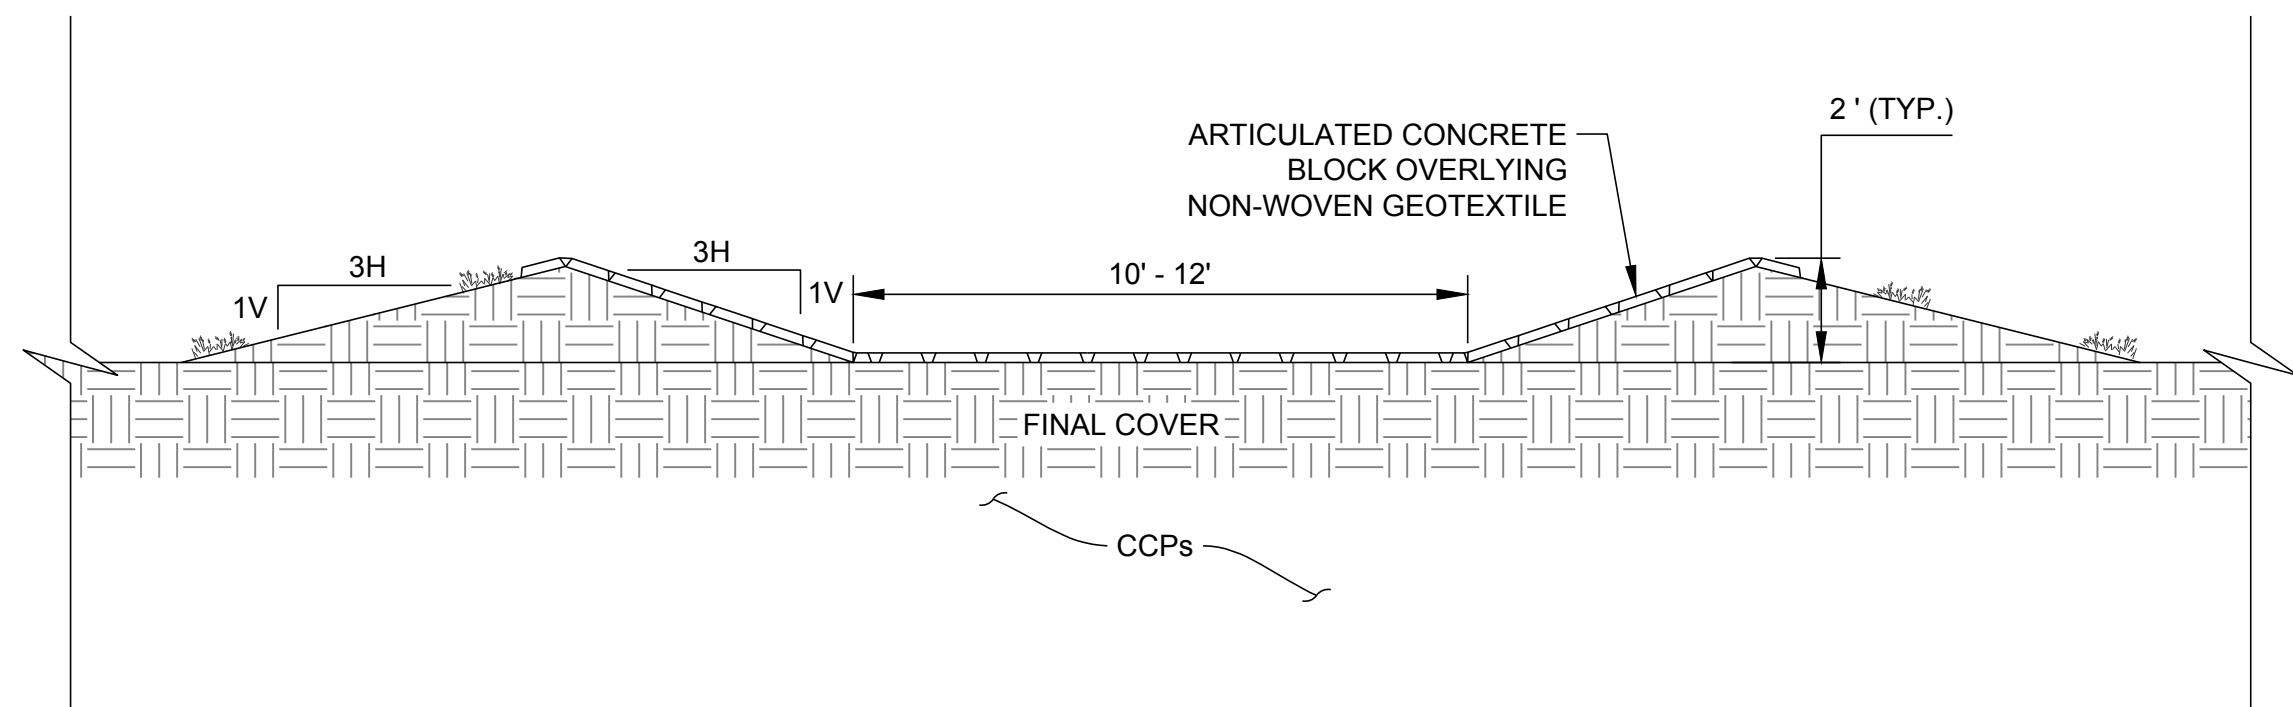


N.T.S. **1** DOWNCHUTE DETAIL  
10

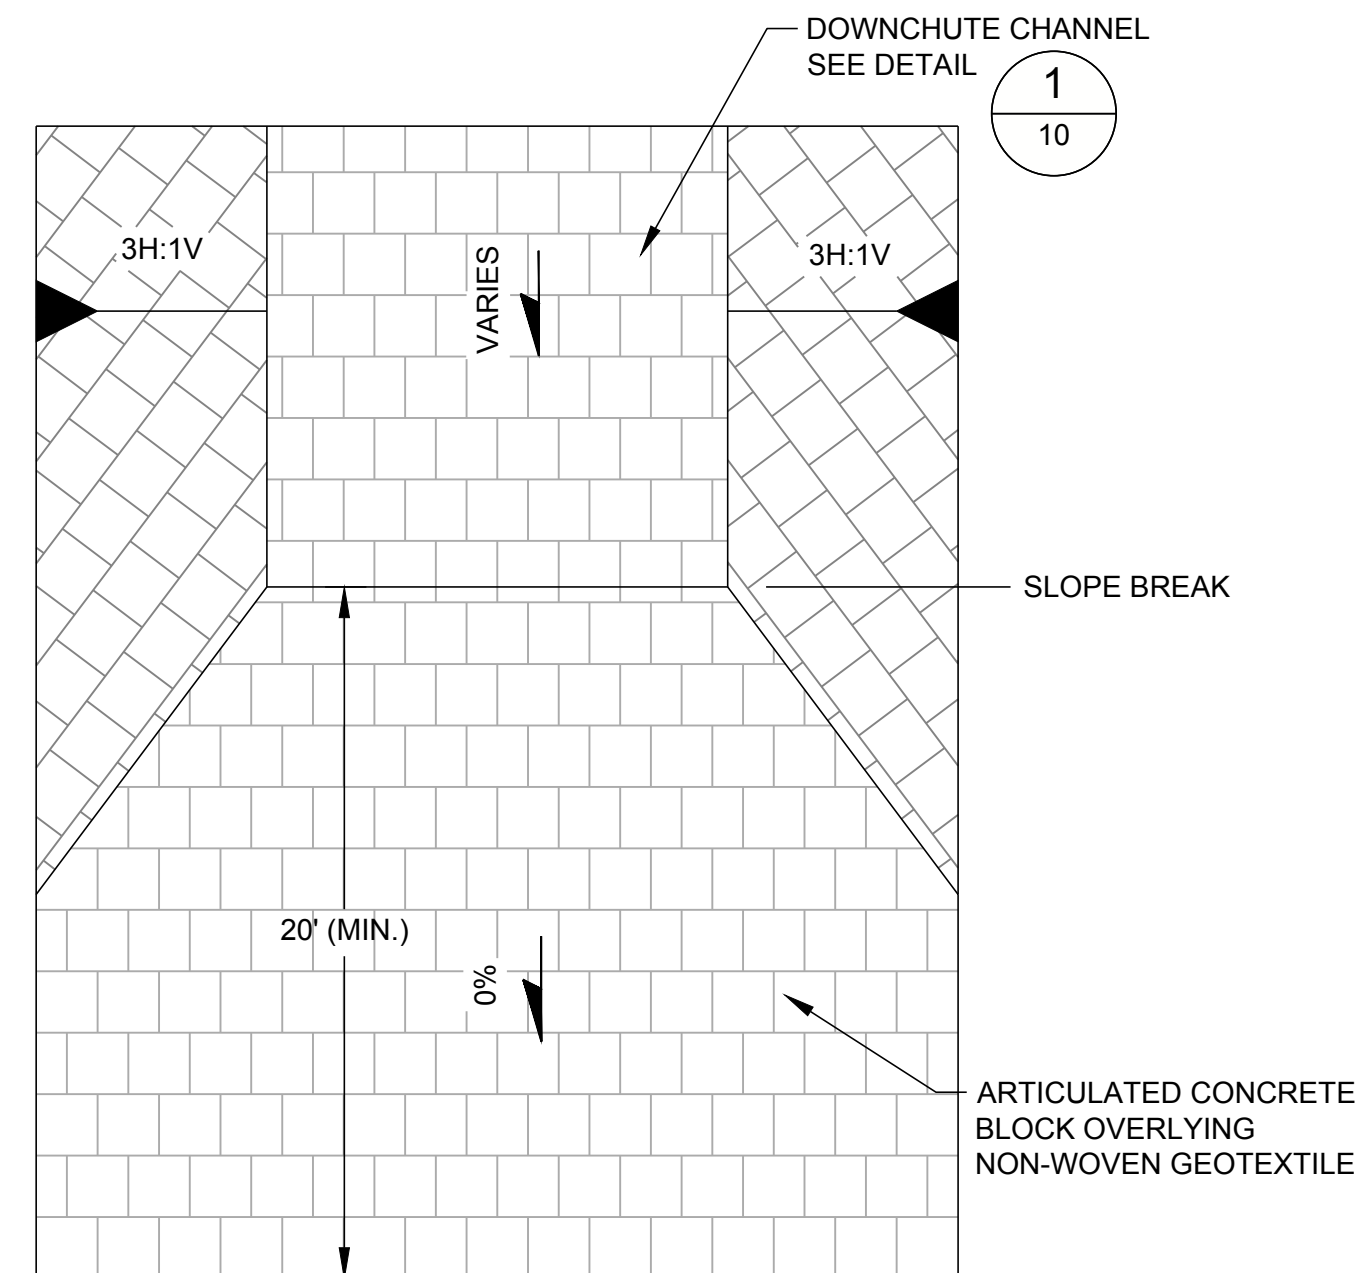


N.T.S. **2** HYDRAULIC JUMP BASIN DETAIL  
10

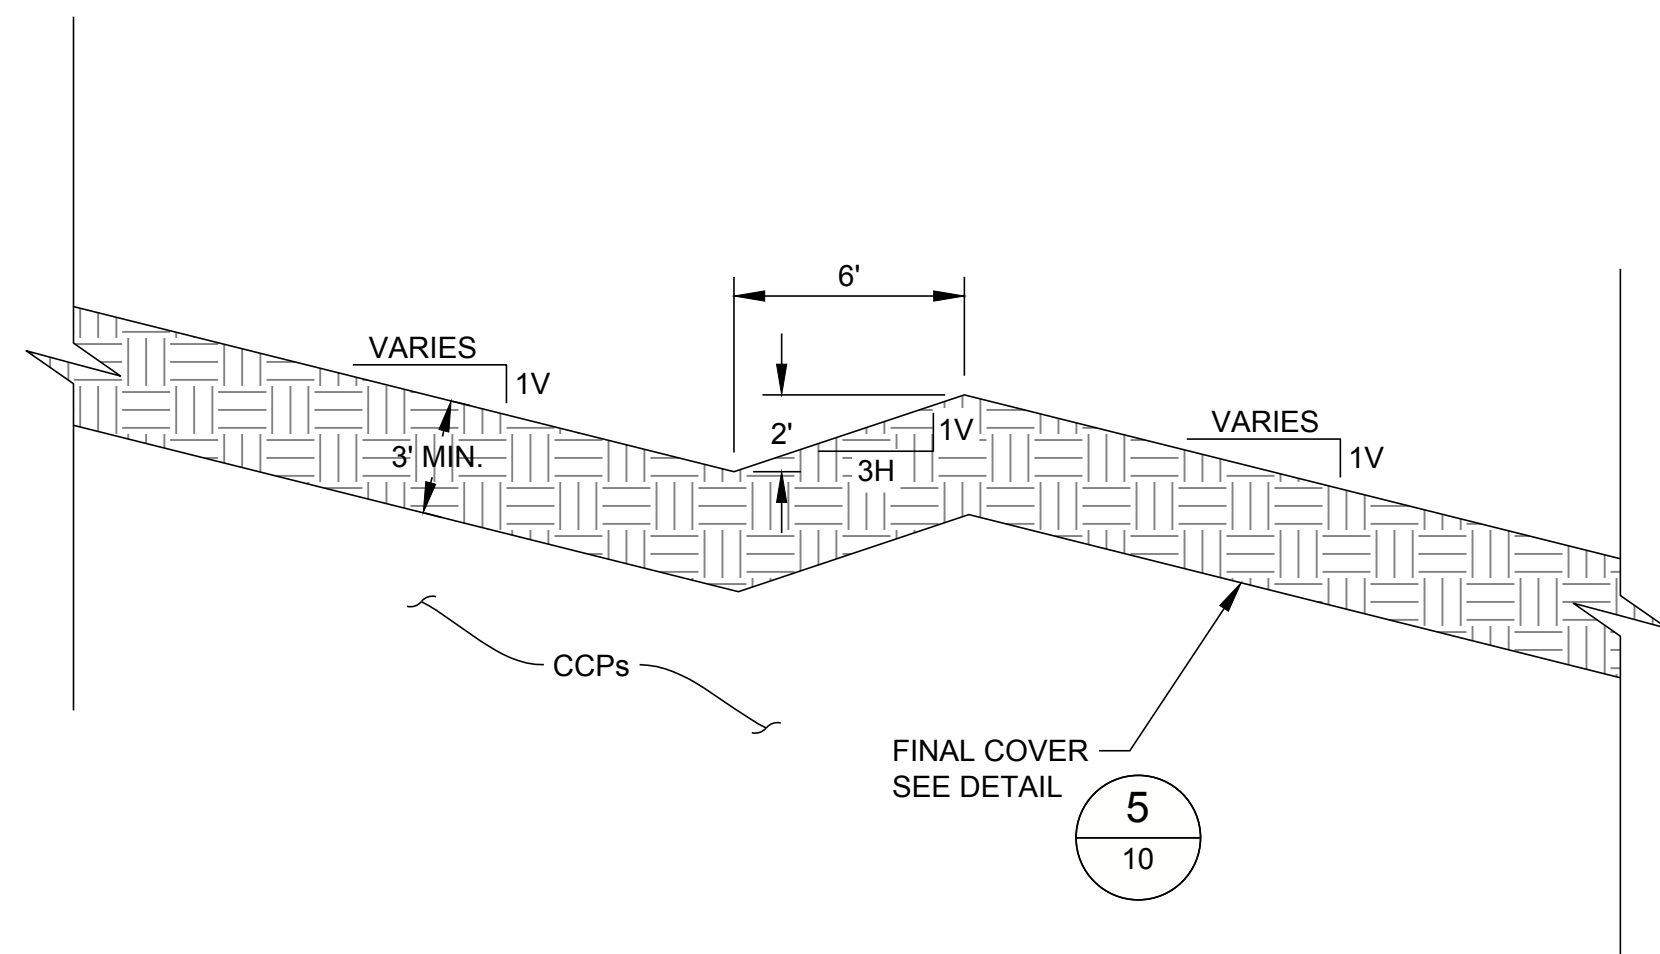

N.T.S. **3** TERRACE CHANNEL DETAIL  
10

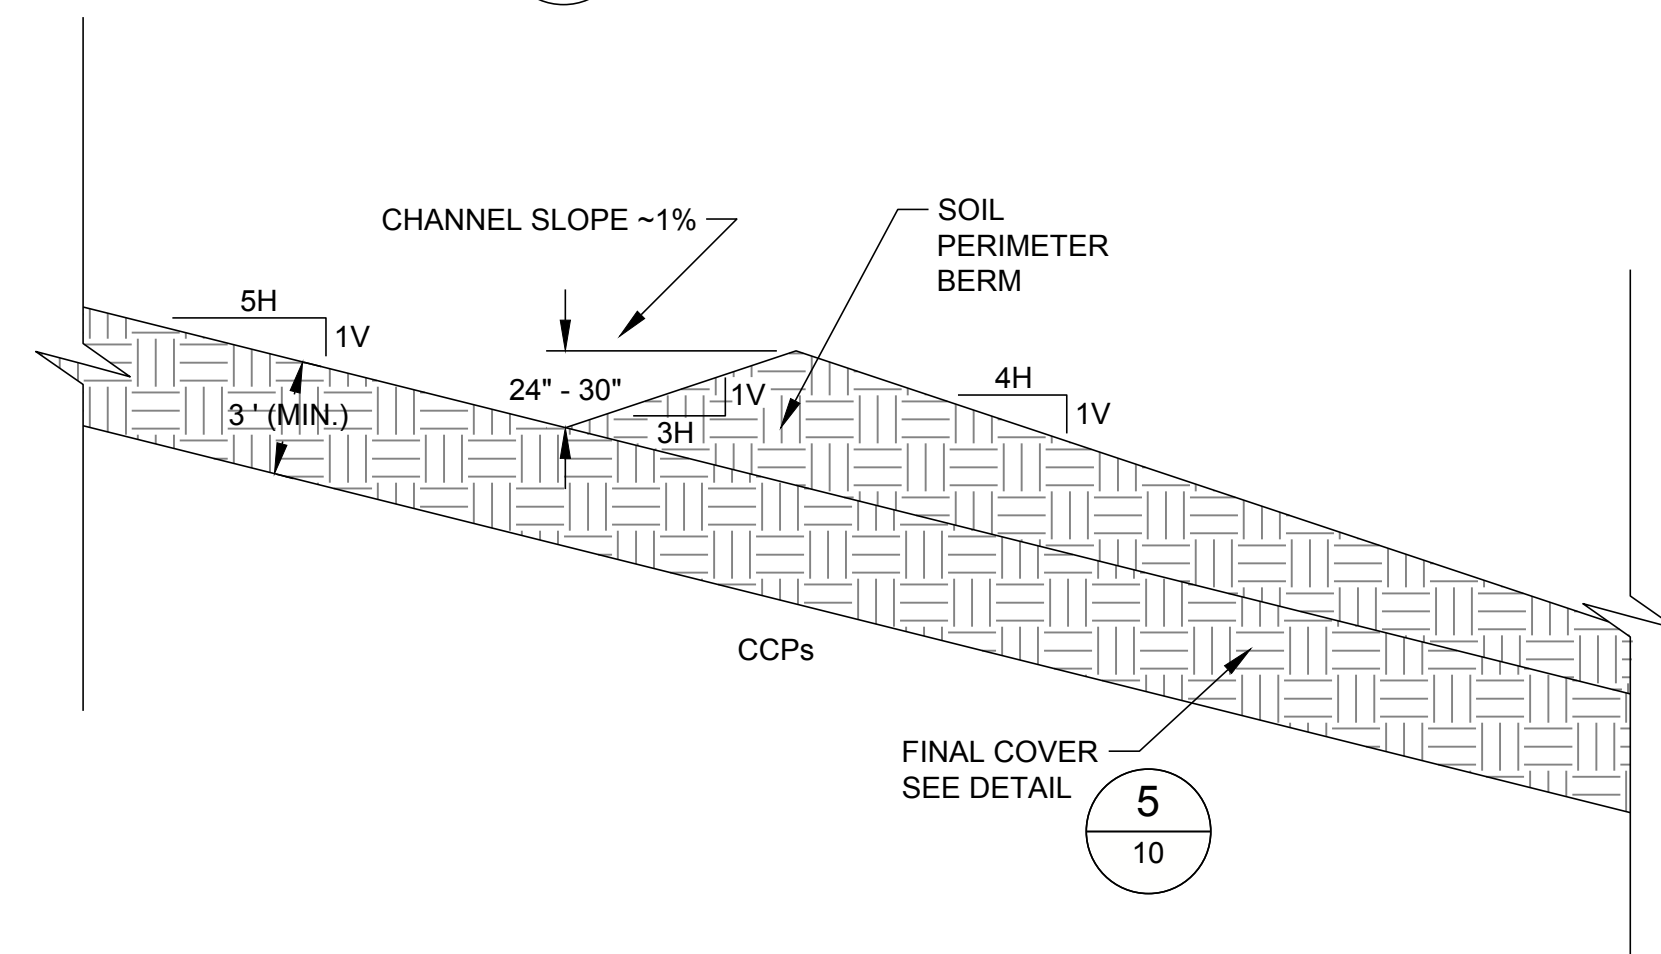

N.T.S. **4** PERIMETER CHANNEL DETAIL  
10

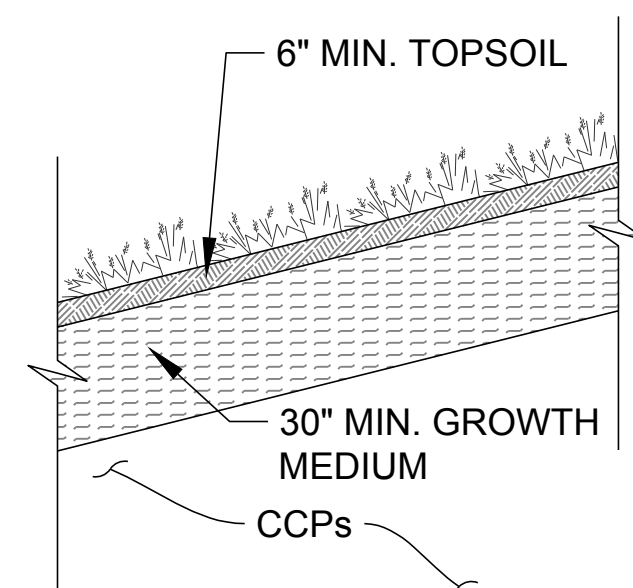

N.T.S. **5** FINAL COVER DETAIL  
10

C	2015-03-20	REVISED ISSUED FOR PERMIT MODIFICATION	RFS	RFS	TJS	RRJ
B	2015-02-11	ISSUED FOR PERMIT MODIFICATION	RFS	RFS	TJS	RRJ
A	2014-11-10	ISSUED FOR CLIENT REVIEW	RFS	RFS	TJS	RRJ
Rev.	YYYY-MM-DD	DESCRIPTION	PREPARED	DESIGN	REVIEW	APPROVED

SEAL

CLIENT



GREAT RIVER ENERGY  
COAL CREEK STATION  
UNDERWOOD, NORTH DAKOTA

CONSULTANT



GOLDER ASSOCIATES INC.  
44 UNION BLVD. SUITE 300  
LAKEWOOD, COLORADO  
USA  
(303) 980-0540  
www.golder.com

PROJECT  
ASH POND 91  
PERMIT NO. 0033 MODIFICATION

TITLE  
**COVER DETAILS**

PROJECT No.  
1400644

Rev.  
C

10 of 10

SHEET  
10



At Golder Associates we strive to be the most respected global group of companies specializing in ground engineering and environmental services. Employee owned since our formation in 1960, we have created a unique culture with pride in ownership, resulting in long-term organizational stability. Golder professionals take the time to build an understanding of client needs and of the specific environments in which they operate. We continue to expand our technical capabilities and have experienced steady growth with employees now operating from offices located throughout Africa, Asia, Australasia, Europe, North America and South America.

Africa	+ 27 11 254 4800
Asia	+ 852 2562 3658
Australasia	+ 61 3 8862 3500
Europe	+ 356 21 42 30 20
North America	+ 1 800 275 3281
South America	+ 55 21 3095 9500

[solutions@golder.com](mailto:solutions@golder.com)  
[www.golder.com](http://www.golder.com)

**Golder Associates Inc.**  
**44 Union Boulevard, Suite 300**  
**Lakewood, Colorado 80228 USA**  
**Tel: (303) 980-0540**  
**Fax: (303) 985-2080**

