



## REPORT

# Annual Inspection

## *Stanton Station - Bottom Ash CCR Landfill*

Submitted to:

### **Great River Energy**

2875 Third Street SW  
Underwood, North Dakota 58576

Submitted by:

### **Golder Associates Inc.**

7245 W Alaska Drive, Suite 200, Lakewood, Colorado 80226

+1 303 980-0540

1894194

January 2021



# Table of Contents

<b>1.0 INTRODUCTION .....</b>	<b>1</b>
<b>2.0 REVIEW OF EXISTING INFORMATION .....</b>	<b>1</b>
2.1 Geological Conditions .....	1
2.2 Site History and Subgrade .....	1
2.3 Site Closure and Restoration .....	2
2.4 Original Site Geometry .....	2
2.5 Changes in Geometry .....	2
2.6 Existing CCR Volume.....	2
2.7 Permits .....	3
2.8 Summary of 2020 Weekly Inspections.....	3
2.9 Summary of Previous Inspections.....	3
<b>3.0 2020 ANNUAL INSPECTION .....</b>	<b>3</b>
3.1 FINAL COVER .....	3
3.2 Perimeter Berm .....	3
3.2.1 Berm Upstream Slope.....	3
3.2.2 Berm Crest .....	4
3.2.3 Berm Downstream Slope .....	4
3.2.4 Toe .....	4
3.3 CCR Placement.....	4
3.4 Signs of Structural Weakness or Other Observations that Could Affect Stability .....	4
<b>4.0 SUMMARY AND CONCLUSIONS .....</b>	<b>5</b>
<b>5.0 REFERENCES .....</b>	<b>6</b>

## **FIGURES**

Figure 1      Stanton Station Site Overview

Figure 2      Bottom Ash Landfill Site Overview

## **APPENDICES**

### **APPENDIX A**

Selected Construction Drawings and Permit Drawings

### **APPENDIX B**

Visual Observations Checklist

### **APPENDIX C**

Photographs

## 1.0 INTRODUCTION

As part of 40 CFR Part 257 of the Subtitle D solid waste provisions under the Resource Conservation and Recovery Act (RCRA), utilities are required to complete annual inspections for surface impoundments and landfills containing Coal Combustion Residuals (CCR). This report has been prepared by Golder Associates Inc. (Golder) for Great River Energy (GRE) to satisfy the annual inspection requirements for CCR landfills under 40 CFR Part 257.84.

Stanton Station was a coal-fired electric generation facility located in Section 16 and 21, Township 144N and Range 84W of Mercer County, approximately three miles southeast of Stanton, North Dakota. There are two facilities located at Stanton Station that fall under the CCR rule requirements (Figure 1). These facilities include the Bottom Ash CCR Landfill (Bottom Ash Landfill) and the Bottom Ash CCR Surface Impoundment (Bottom Ash Impoundment). Stanton Station ceased operation in February 2017. Deconstruction and demolition of plant facilities was completed in 2019 and site restoration were completed in 2020. Ongoing maintenance of the site will be performed in accordance with the Closure and Post-Closure Plan (Golder 2019).

Both the Bottom Ash Landfill and the Bottom Ash Impoundment were closed in 2020 as part of the site closure and restoration activities. This report presents a review of available facility information and findings of the inspection of the Bottom Ash Landfill performed on July 21, 2020 (after closure was complete).

## 2.0 REVIEW OF EXISTING INFORMATION

### 2.1 Geological Conditions

Stanton Station is located in the Missouri Slope district of the glaciated Missouri Plateau of the Great Plains physiographic province (NDDH 2017). The Bottom Ash Landfill is constructed in Missouri River alluvial deposits. The alluvial deposits have two distinct subunits: upper and lower. The upper subunit consists of a silty sand and clay and the lower subunit is an outwash sand and gravel (Barr 2010).

### 2.2 Site History and Subgrade

The Bottom Ash Landfill (see Figure 1 and Figure 2) is located adjacent to the Bottom Ash Impoundment south of the historic plant. The north and south cells of the Bottom Ash Impoundment were active cells used for dewatering bottom ash and the center cell functioned as a retention cell, until the plant ceased operation in 2017. Bottom ash was historically excavated and hauled from the north and south cells of the Bottom Ash Impoundment to the eastern half of the Bottom Ash Landfill as needed (see Figure 2).

Stanton Station originally burned North Dakota lignite before being converted in November 2004 to use fuel from the Powder River Basin in Wyoming. All ash was originally wet sluiced into a series of ash ponds (Ponds A, B, and C) (Stone & Webster 1994b). In the mid-1990s, Stanton Station converted to a dry fly ash handling system, and the historic CCR management units were removed and new facilities constructed.

CCRs from the 1970s ash disposal area and Pond A were excavated and hauled to Ponds B and C for disposal. Ponds B and C were further consolidated and closed. Pond A was reconstructed to include a composite-lined surface impoundment with three cells on the east side and the Bottom Ash Landfill on the west side. Prior to the placement of bottom ash, the Bottom Ash Landfill was re-graded to promote drainage of contact water to the east. Soil and/or ash fill was placed over the area to bring the floor above groundwater. The historic Pond A perimeter soil berms were used as the perimeter berms for the Bottom Ash Landfill. Additional information regarding the

design of the Bottom Ash Impoundment and Bottom Ash Landfill is included in the original design report (Stone & Webster 1994a). Select construction and permit drawings are included in Appendix A.

## 2.3 Site Closure and Restoration

Between 2017 and 2019, the remaining bottom ash and economizer ash from the plant and Bottom Ash Impoundment (north and center cells) was placed in the south cell of the Bottom Ash Impoundment. Construction and demolition (C&D) material from plant demolition activities as well as coal and coal yard soil, and clayey soils underlying the geomembrane of the north and center cells excavated during site restoration were placed in the Bottom Ash Landfill or the south cell of the Bottom Ash Impoundment (as approved through the North Dakota Department of Environmental Quality (NDDEQ) state permit program). Site restoration activities began in the summer of 2019 and were completed in the summer of 2020. These activities primarily included consolidating waste materials into the Bottom Ash Impoundment south cell and Bottom Ash Landfill, re-grading the site to promote drainage and vegetative growth, and closing remaining portions of the active surface impoundment and landfill.

## 2.4 Original Site Geometry

The original perimeter berms surrounding the Bottom Ash Landfill on the north, west, and south sides consist of the historic Pond A soil embankments and have top elevations of approximately 1708 feet above mean sea level (amsl). The east berm is a shared berm with the Bottom Ash Impoundment and was constructed out of embankment fill in 1994 and 1995 to a top elevation of approximately 1720 feet amsl and the west berm was constructed to an elevation of 1703 feet amsl during site restoration activities and consolidation of the Bottom Ash Landfill footprint. The crest of the east berm is a gravel surfaced roadway that supports both light passenger vehicles and some heavy construction equipment. The original bottom elevation of the Bottom Ash Landfill varies between approximately 1698 feet amsl and 1701 feet amsl based on as-built surveyed grades (see Appendix A). The berm upstream and berm downstream slopes are three horizontal units to one vertical unit (3:1). Current top of waste elevations range between approximately 1700 feet amsl and 1725 feet amsl based on as-built surveyed grades (see Appendix A).

## 2.5 Changes in Geometry

Perimeter berms on the west portion of the Bottom Ash Landfill were re-graded to tie in with site restoration grades and a new containment berm was constructed in the Bottom Ash Landfill area after consolidation of the Bottom Ash Landfill footprint. This new west containment berm has a crest elevation of 1703 feet amsl. The facility's Closure and Post-Closure Plan (Golder 2019) discusses the closure of the Bottom Ash Landfill, but in general, remaining permitted waste (as approved through the state permit program) from site restoration activities was disposed of in the south cell of the Bottom Ash Impoundment or the Bottom Ash Landfill. The landfill was closed with the permitted wastes remaining in-place and in accordance with the final cover design outlined in the Closure and Post-Closure Plan. Select site restoration drawings and final construction grades are included in Appendix A.

## 2.6 Existing CCR Volume

Bottom ash was last placed in the Bottom Ash Landfill in 2014. Based on a survey of final waste grades performed during 2020 site restoration activities, approximately 160,000 CY of material is contained in the Bottom Ash Landfill.

## 2.7 Permits

The Bottom Ash Landfill is currently permitted with the NDDEQ under Permit Number 0043.

## 2.8 Summary of 2020 Weekly Inspections

GRE performed weekly inspections of the Bottom Ash Landfill throughout 2020. Based on a review of the available inspection forms, the following items were noted:

- Generally good site maintenance.
- No signs of significant seepage, settlement, or cracking of the berm downstream slopes.

## 2.9 Summary of Previous Inspections

The previous annual professional engineer inspection of the Bottom Ash Landfill was performed by Golder in September of 2019 (Golder 2020) and a summary of the observations of that inspection are as follows:

- The Bottom Ash Landfill was actively undergoing construction during the 2019 inspection as part of the site restoration
- Generally good vegetation and site maintenance were applicable.
- Animal burrows were noted on berm downstream slopes.
- Stormwater and/or contact water control features to control run-on and runoff were not well-established.
- Isolated and minor woody vegetation was growing on berm downstream slopes and near the toe of slopes.

## 3.0 2020 ANNUAL INSPECTION

On July 21, 2020, Craig Schuettepelz of Golder performed an inspection of the Bottom Ash Landfill per United States Environmental Protection Agency (USEPA) Regulation 40 CFR Part 257.84(b) requirements. The inspection consisted of visual observations while walking around the facility traversing up and down the perimeter berm and CCR placement areas. An annual inspection checklist used during the inspection is presented in Appendix B. Photographs were taken and are presented in Appendix C. The following presents a summary of the observations made during the 2020 annual inspection.

### 3.1 FINAL COVER

Construction of the final cover system was completed in 2020 and the area was seeded and mulched prior to performing the annual inspection. At the time of inspection, vegetation had not yet started growing in recently seeded areas. The final cover will be monitored for vegetative success during future inspections in accordance with the Closure and Post-Closure Plan (Golder 2019).

### 3.2 Perimeter Berm

#### 3.2.1 Berm Upstream Slope

Due to site closure and restoration activities, the berm upstream slopes of the Bottom Ash Landfill were not visible during the inspection.

### 3.2.2 Berm Crest

The remaining berm crests east and north of the landfill are surfaced with soil and/or gravel at elevations between approximately 1715 feet amsl and 1720 feet amsl. The crest roadway is primarily used for light vehicle traffic but was exposed to heavy construction equipment when the north and south cells were cleaned out and during site restoration activities. Some surficial gravel has been removed as a part of site restoration activities. The berm crest appears to be in good condition with minimal weedy vegetation, no animal burrows, and no settlement.

### 3.2.3 Berm Downstream Slope

Part of the berm downstream slope east of the landfill was regraded during site closure and restoration activities (associated with closure by removal of CCR within the north and center cells of the Bottom Ash Impoundment). The berm is approximately 20-feet high and graded at approximate 5:1 slopes. The berm was recently seeded and mulched as part of site closure and restoration activities.

The berm downstream slopes on the north and south sides are between approximately 5 feet and 10 feet high and have slopes of approximately 3:1. Slopes that were not impacted by site restoration grading are well vegetated with grass but do contain numerous, but mostly small, animal burrows.

As part of closure, a new three-foot high soil berm was constructed on the west end of the consolidated landfill footprint. The downstream slopes for this new west berm were recently seeded and mulched as part of site closure and restoration activities. At the time of inspection, this berm appeared to be experiencing minor erosion as noted by several erosion rills along the slope.

The berm downstream slopes of the Bottom Ash Landfill appear to be in fair condition. Recently seeded and mulched slopes will be monitored for erosion and vegetative success during future inspections in accordance with the Closure and Post-Closure Plan (Golder 2019). Additional soil will be added and the area re-seeded as required during the post-closure period.

### 3.2.4 Toe

The toe of the south perimeter berm is in a surface water drainage ditch that has some marshy vegetation and standing water. Some small animal burrows were noted near the toe of the slope, but there were no observed indications of seepage, settlement, or excessive vegetation at the toe of these slopes. The toe of the east, north, and west perimeter berms were recently seeded and mulched as part of site closure and restoration activities. The toes of the berm downstream slopes are in good condition. Recently seeded and mulched areas will be monitored for erosion and vegetative success during future inspections in accordance with the Closure and Post-Closure Plan (Golder 2019).

## 3.3 CCR Placement

The Bottom Ash Landfill was closed with CCR and other permitted waste in place and covered in 2020. No active placement was occurring and no exposed CCR or other permitted waste was observed.

## 3.4 Signs of Structural Weakness or Other Observations that Could Affect Stability

No signs of structural weakness or other observations that could affect the stability of the Bottom Ash Landfill were observed during the site inspection in July 2020.

## 4.0 SUMMARY AND CONCLUSIONS

An annual inspection was performed for the Bottom Ash Landfill at Stanton Station on July 21, 2020. The inspection met the requirements for CCR landfills under 40 CFR Part 257.84.

The Bottom Ash Landfill was closed in 2020 with permitted wastes remaining in-place and in accordance with the final cover design outlined in the Closure and Post-Closure Plan (Golder 2019).

As applicable for areas not affected by site restoration and/or closure activities, Golder observed good vegetation and site maintenance and did not identify significant deficiencies such as seepage, excessive erosion or settlement, or cracking during visual observations. Significant portions of the facility were recently seeded and mulched prior to the annual inspection and will be monitored for erosion and vegetative success moving forward.

In addition to annual inspections of applicable portions of the Bottom Ash Landfill by a Professional Engineer, trained and qualified site personnel will perform semi-annual facility inspections, typically in the spring and fall, for the first five years of the post-closure period. These inspections will focus on erosion of soil on the perimeter berms and the final cover as well as vegetative success. Minor maintenance items that may need to be continually addressed include repairing larger animal burrows as they appear, repairing erosion caused by stormwater, monitoring vegetative success of berm downstream slopes and slopes that have received final cover, and removal of any woody vegetation growing on the berm downstream slopes or final cover areas.


### Golder Associates Inc.



Brendan Purcell  
Staff Engineer



Craig Schuettpelez, PE  
Senior Engineer

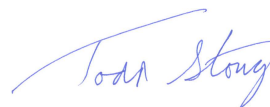

Todd Stong, PE  
Associate and Senior Consultant

BJP/CCS/mp

## 5.0 REFERENCES

- Barr, 2010. 2010 Annual Groundwater Monitoring Report, Stanton Station Ash Disposal Facility, NDDH Solid Waste Permit # SP043. Prepared for Great River Energy, February 2011.
- Golder Associates Inc. Golder 2020. 2019 Annual Inspection Report – Great River Energy – Stanton Station – Bottom Ash CCR Landfill. January 2020.
- Golder Associates Inc. Golder 2019. Closure and Post-Closure Plan, Revision 1 – Bottom Ash CCR Landfill – Stanton Station. September 2019.
- Great River Energy – Coal Creek Station. GRE 2015. Permit Renewal Document, Permit No. SP-043. Original Permit Renewal dated February 2, 2015.
- North Dakota Department of Health, 2017. Permit for a Solid Waste Management Facility, North Dakota Department of Health – Division of Waste Management Permit No. 0043. November 29, 2017.
- Stone & Webster, 1994a. *Design Report Stanton Station Ash Pond Modifications*. Prepared for United Power Association, Project No. 4177. April 25, 1994.
- Stone & Webster, 1994b. *Stanton Station Ash Pond Modifications, Project No. 4177 Design Drawings Rev. 2*. Prepared for United Power Association, June 1994.

Golder and the G logo are trademarks of Golder Associates Corporation


[https://golderassociates.sharepoint.com/sites/23291g/deliverables/reports/ss\\_2020\\_annual\\_inspection\\_ccr\\_landfill\\_fnl\\_26jan21/1894194\\_landfill\\_annual\\_inspection\\_fnl\\_29jan21.docx](https://golderassociates.sharepoint.com/sites/23291g/deliverables/reports/ss_2020_annual_inspection_ccr_landfill_fnl_26jan21/1894194_landfill_annual_inspection_fnl_29jan21.docx)

## Figures



#### REFERENCE(S)

1. AERIAL IMAGE FROM UNITED STATES DEPARTMENT OF AGRICULTURE NATIONAL AGRICULTURE IMAGERY PROGRAM, 2020.

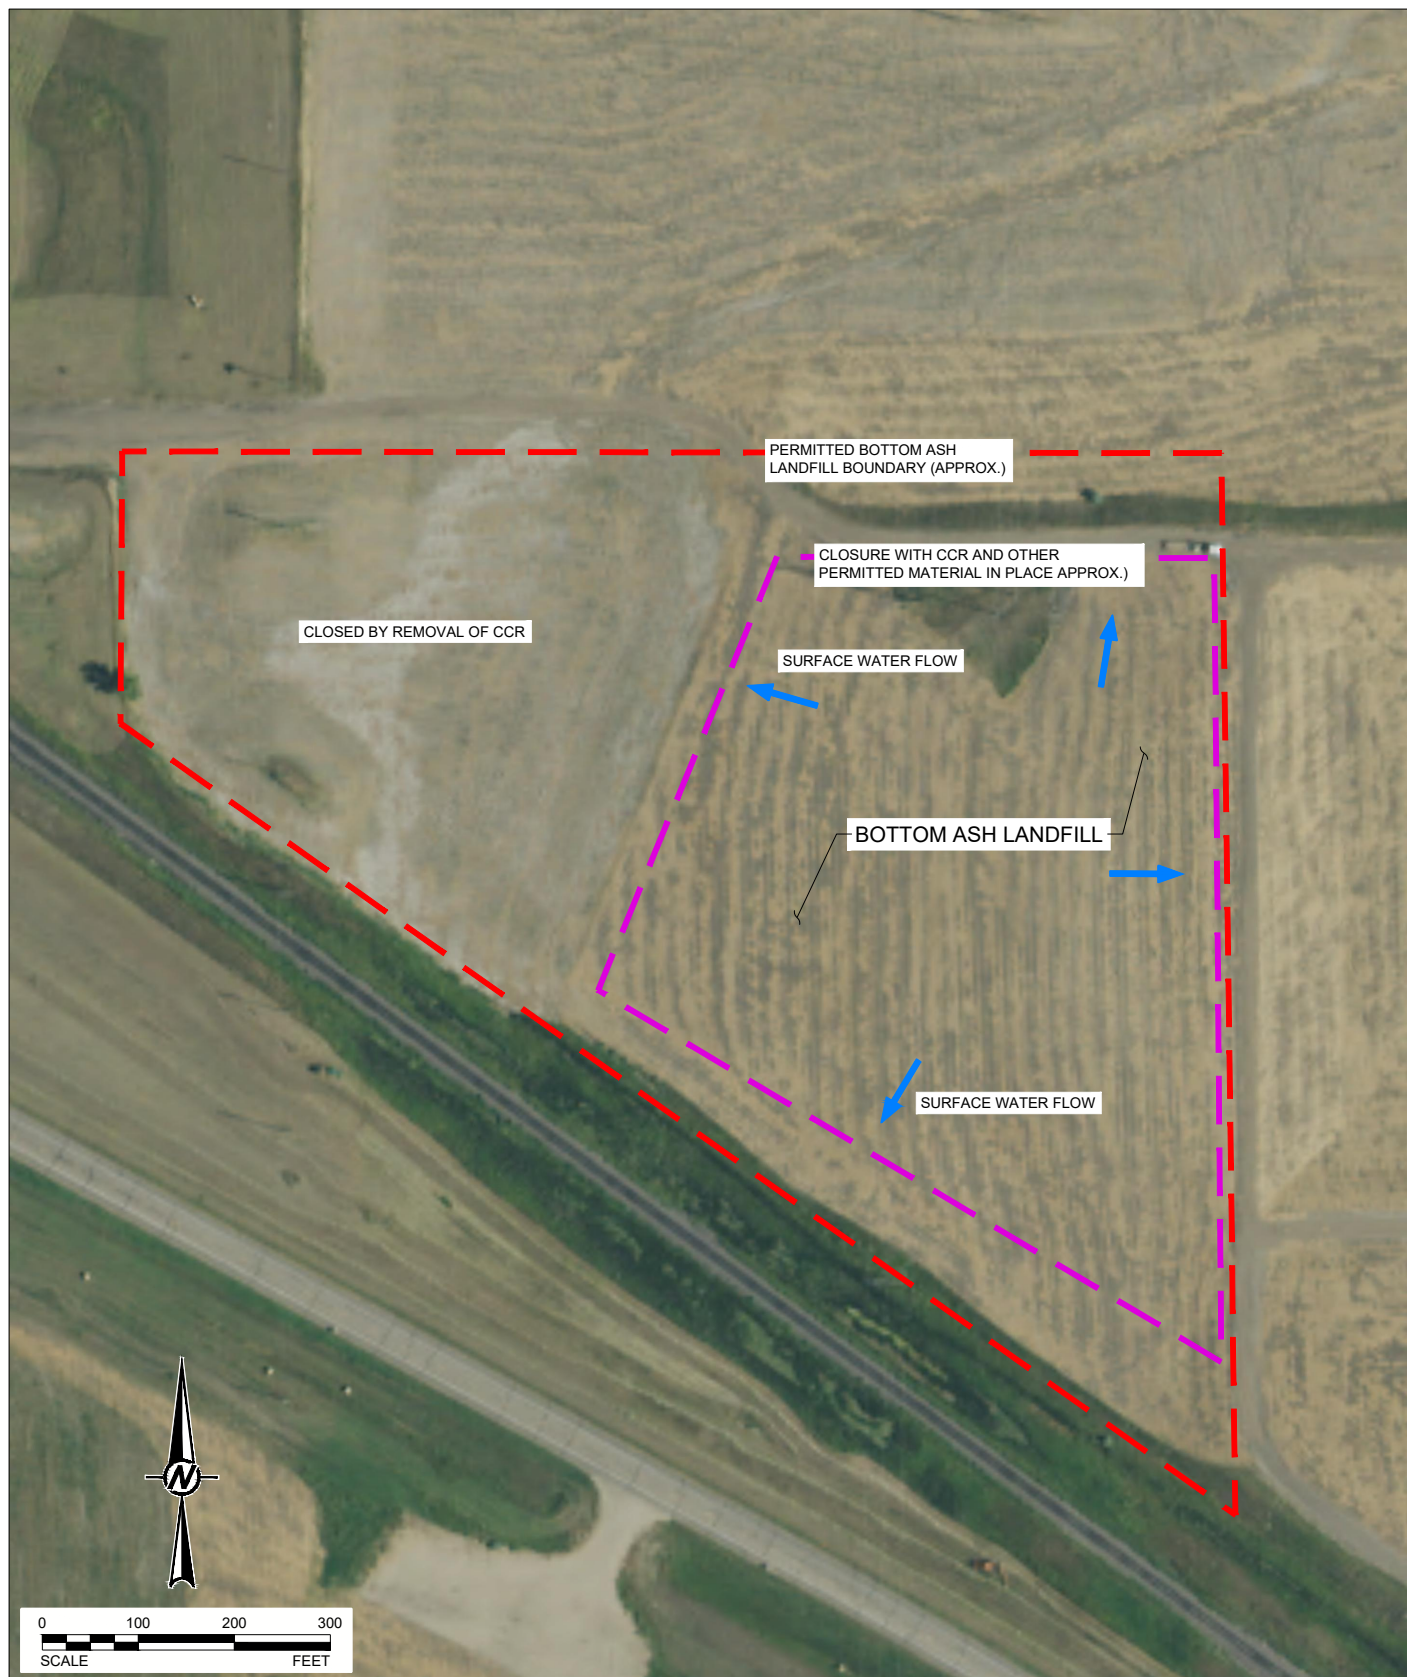










**REFERENCE(S)**

1. AERIAL IMAGE FROM UNITED STATES DEPARTMENT OF AGRICULTURE NATIONAL AGRICULTURE IMAGERY PROGRAM, 2020.

## **APPENDIX A**

# **Selected Construction Drawings and Permit Drawings**



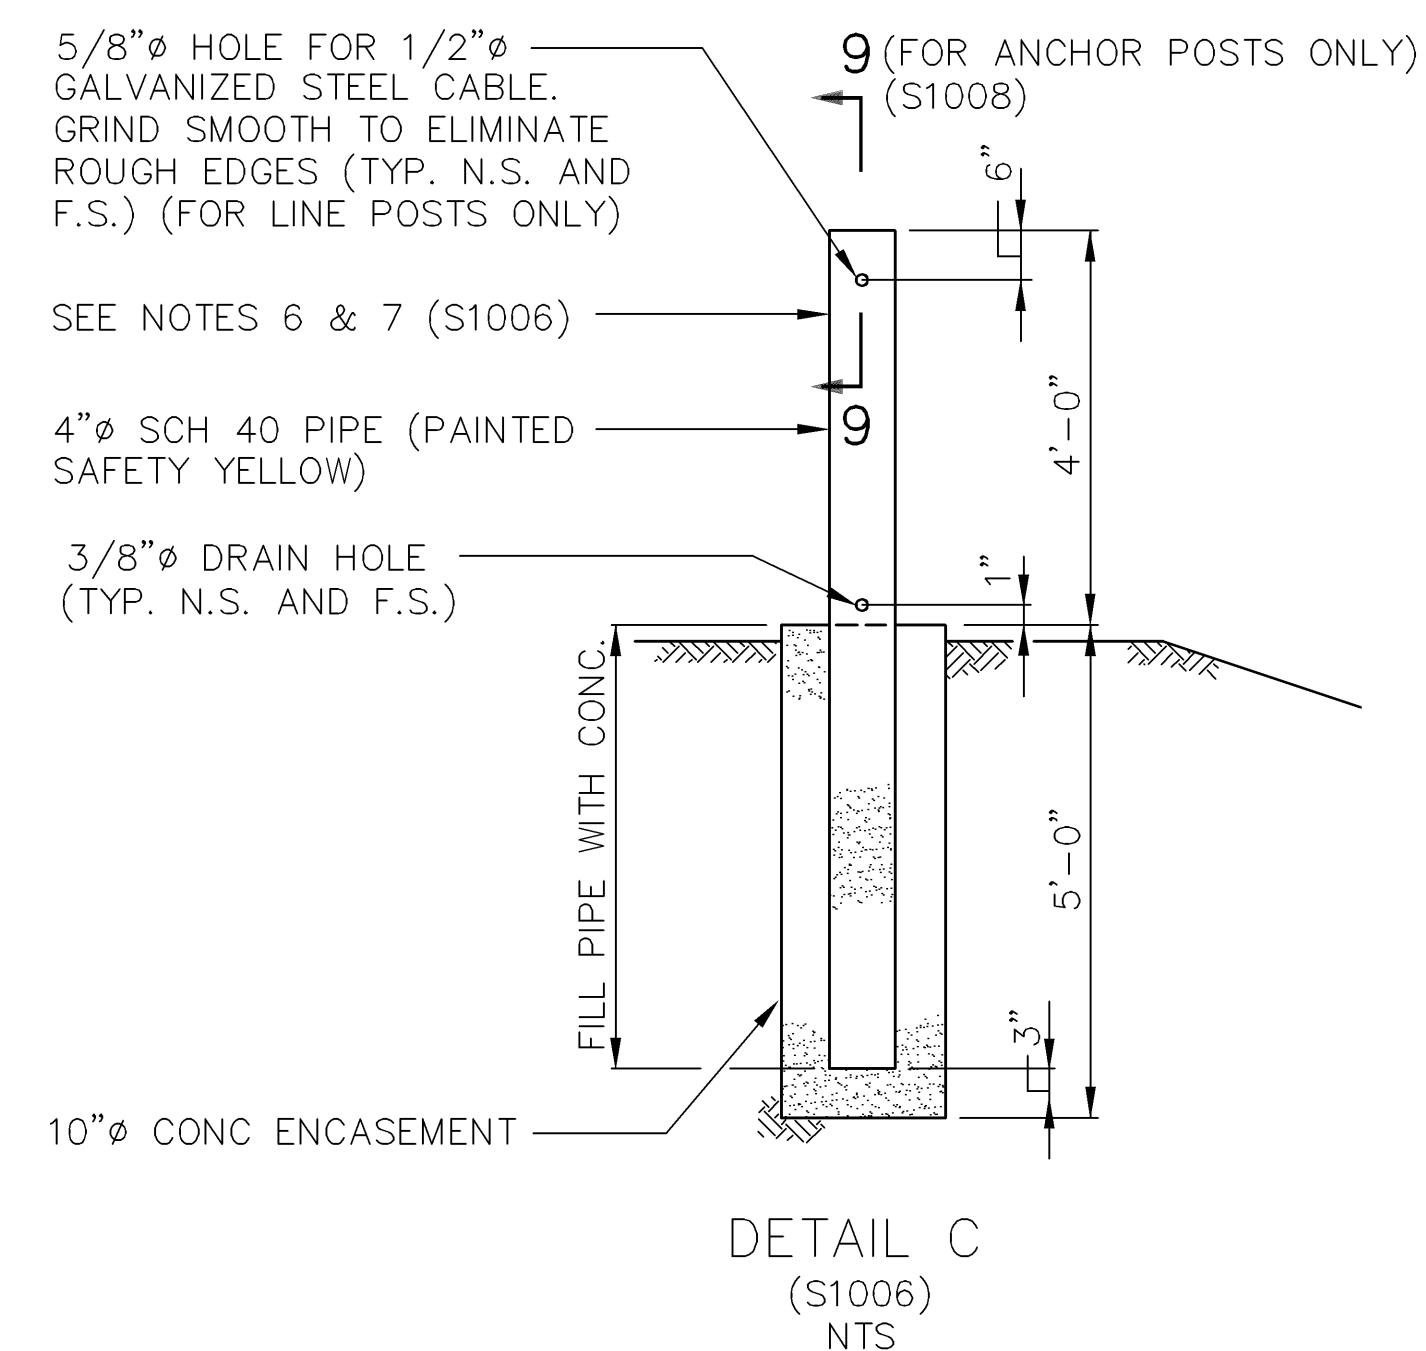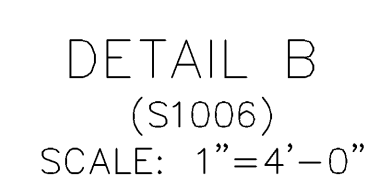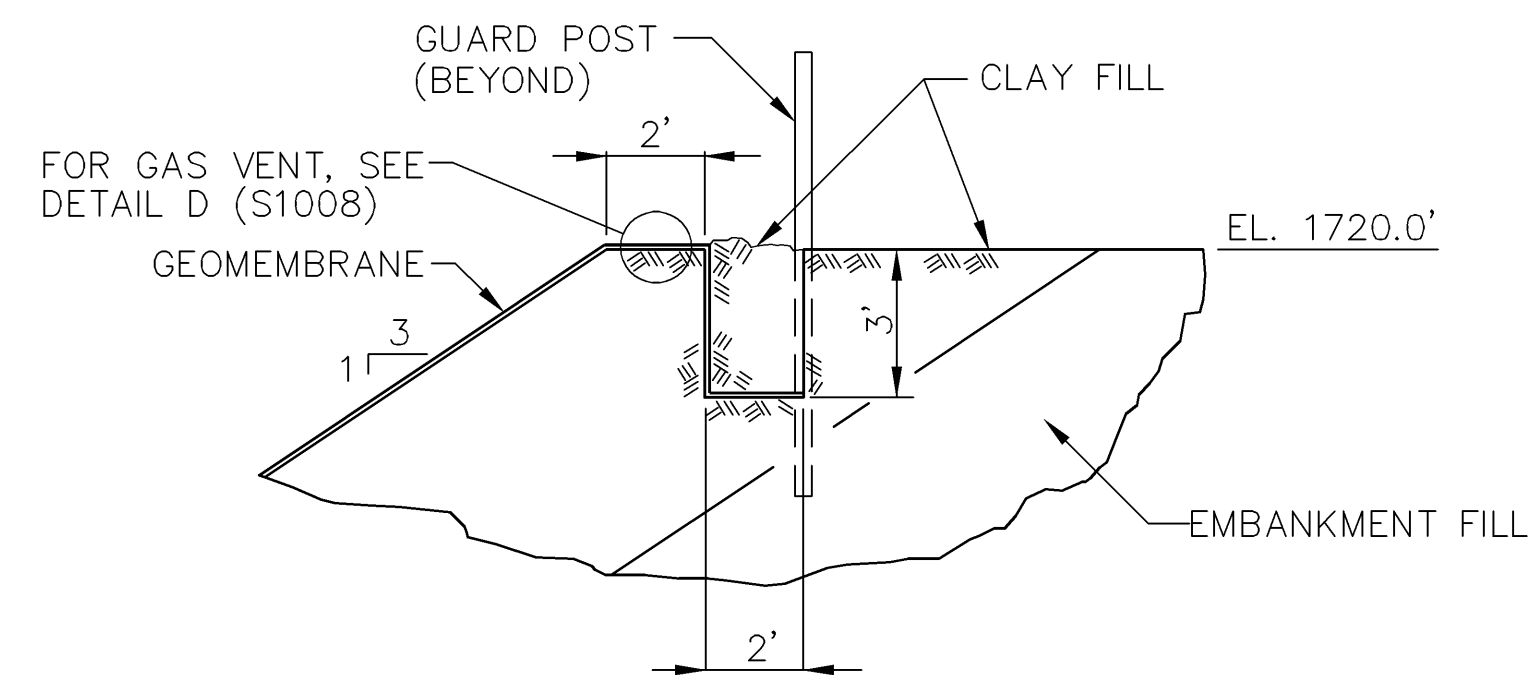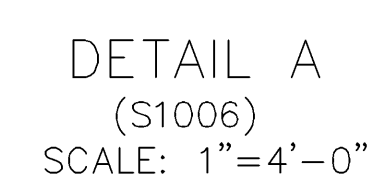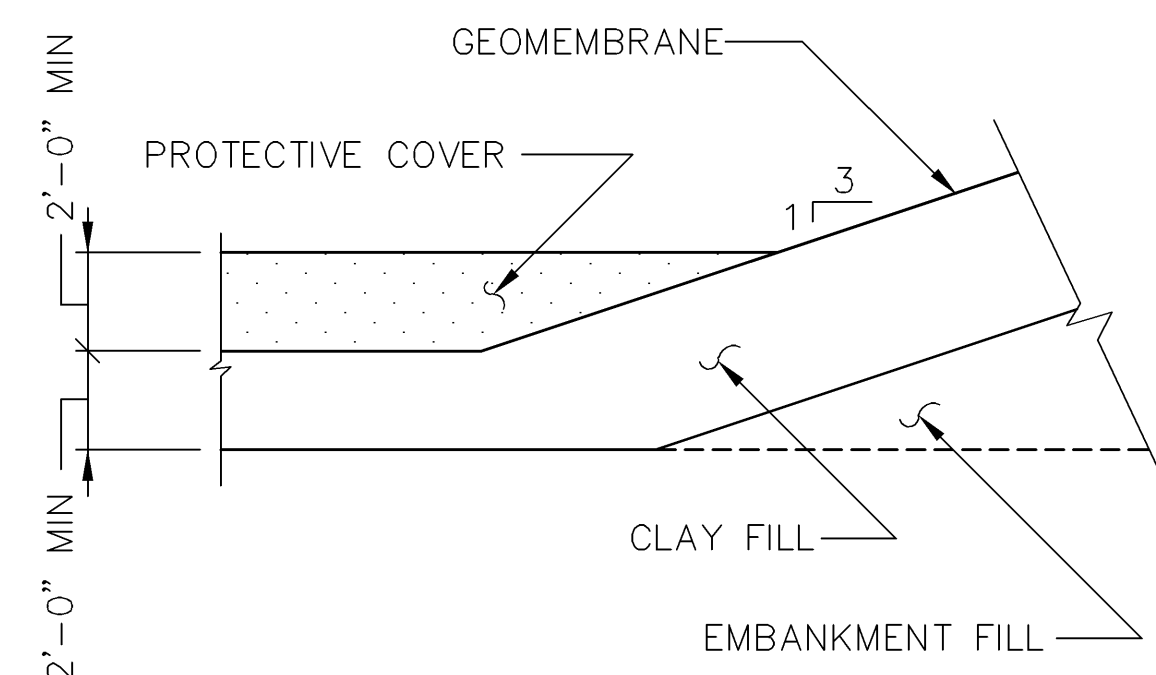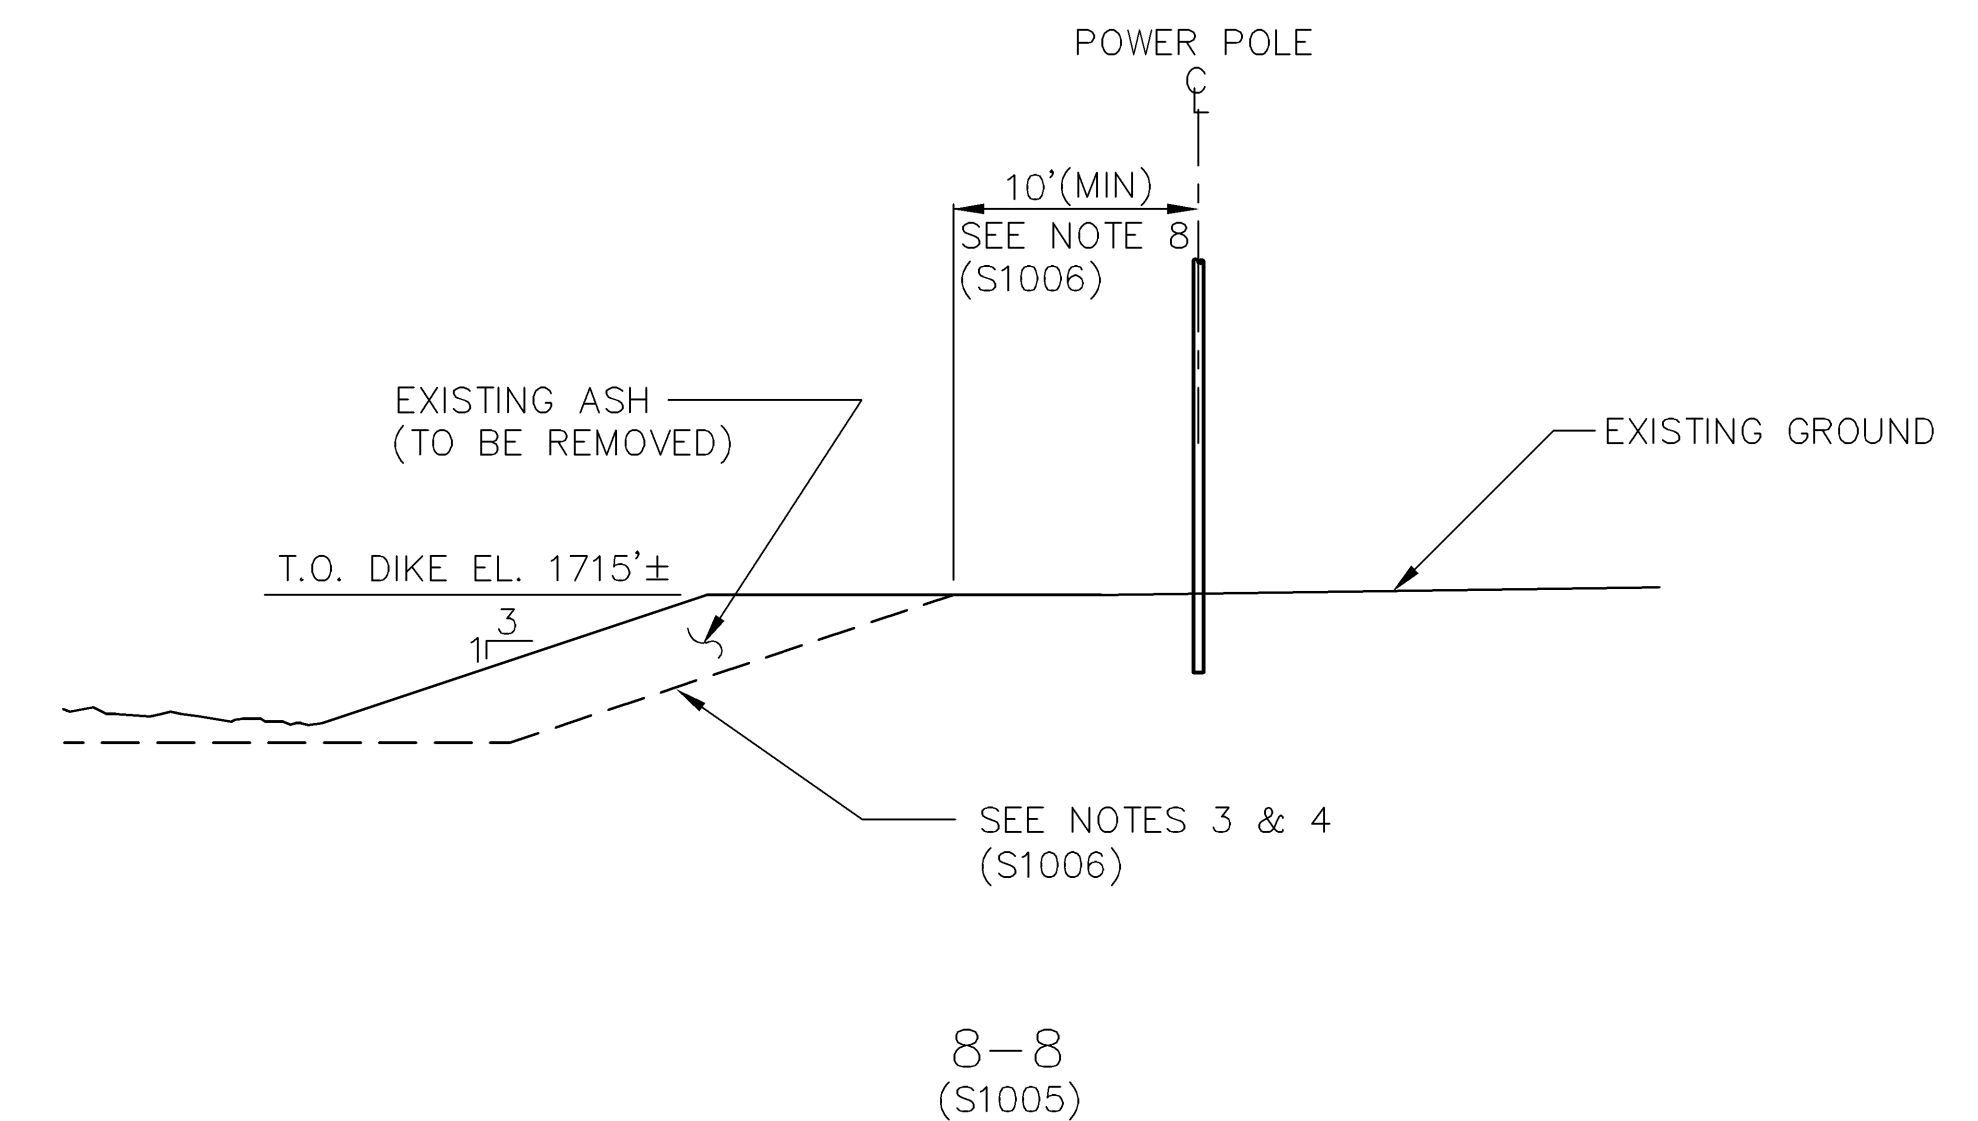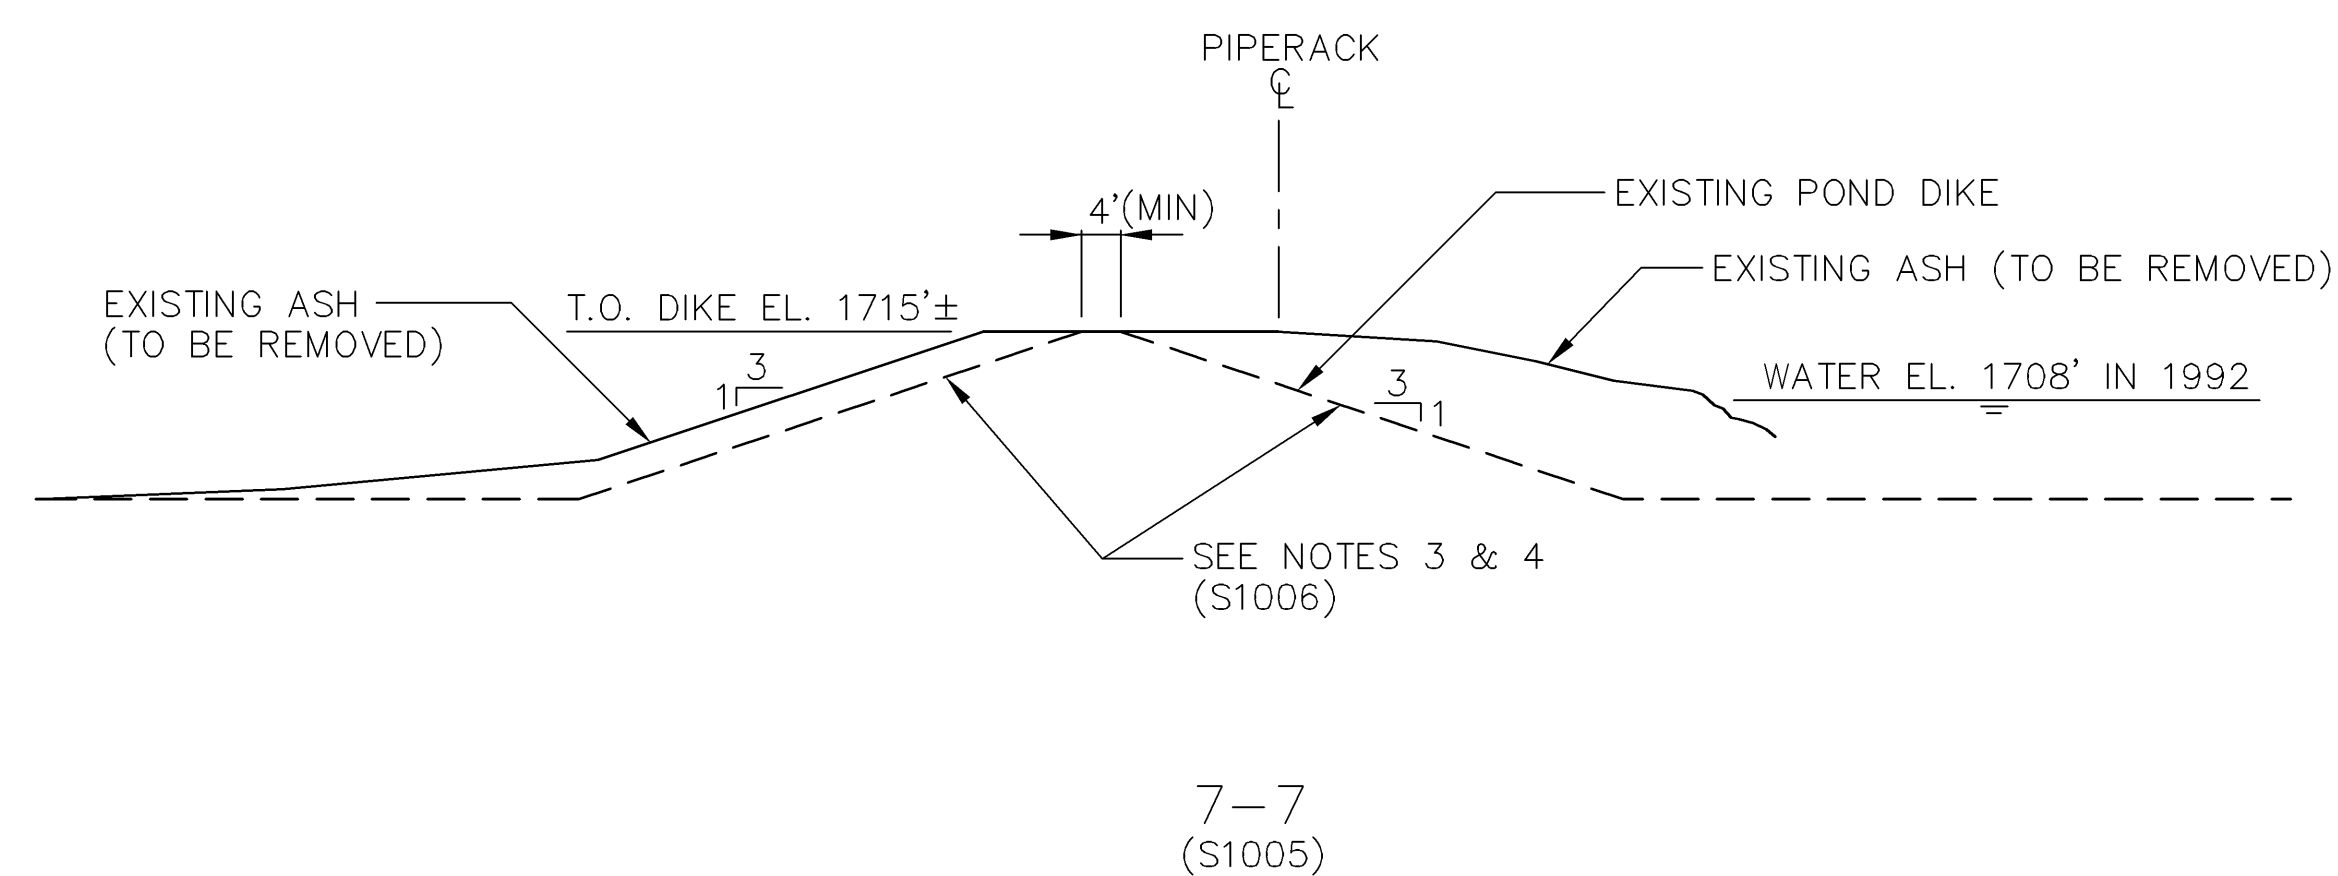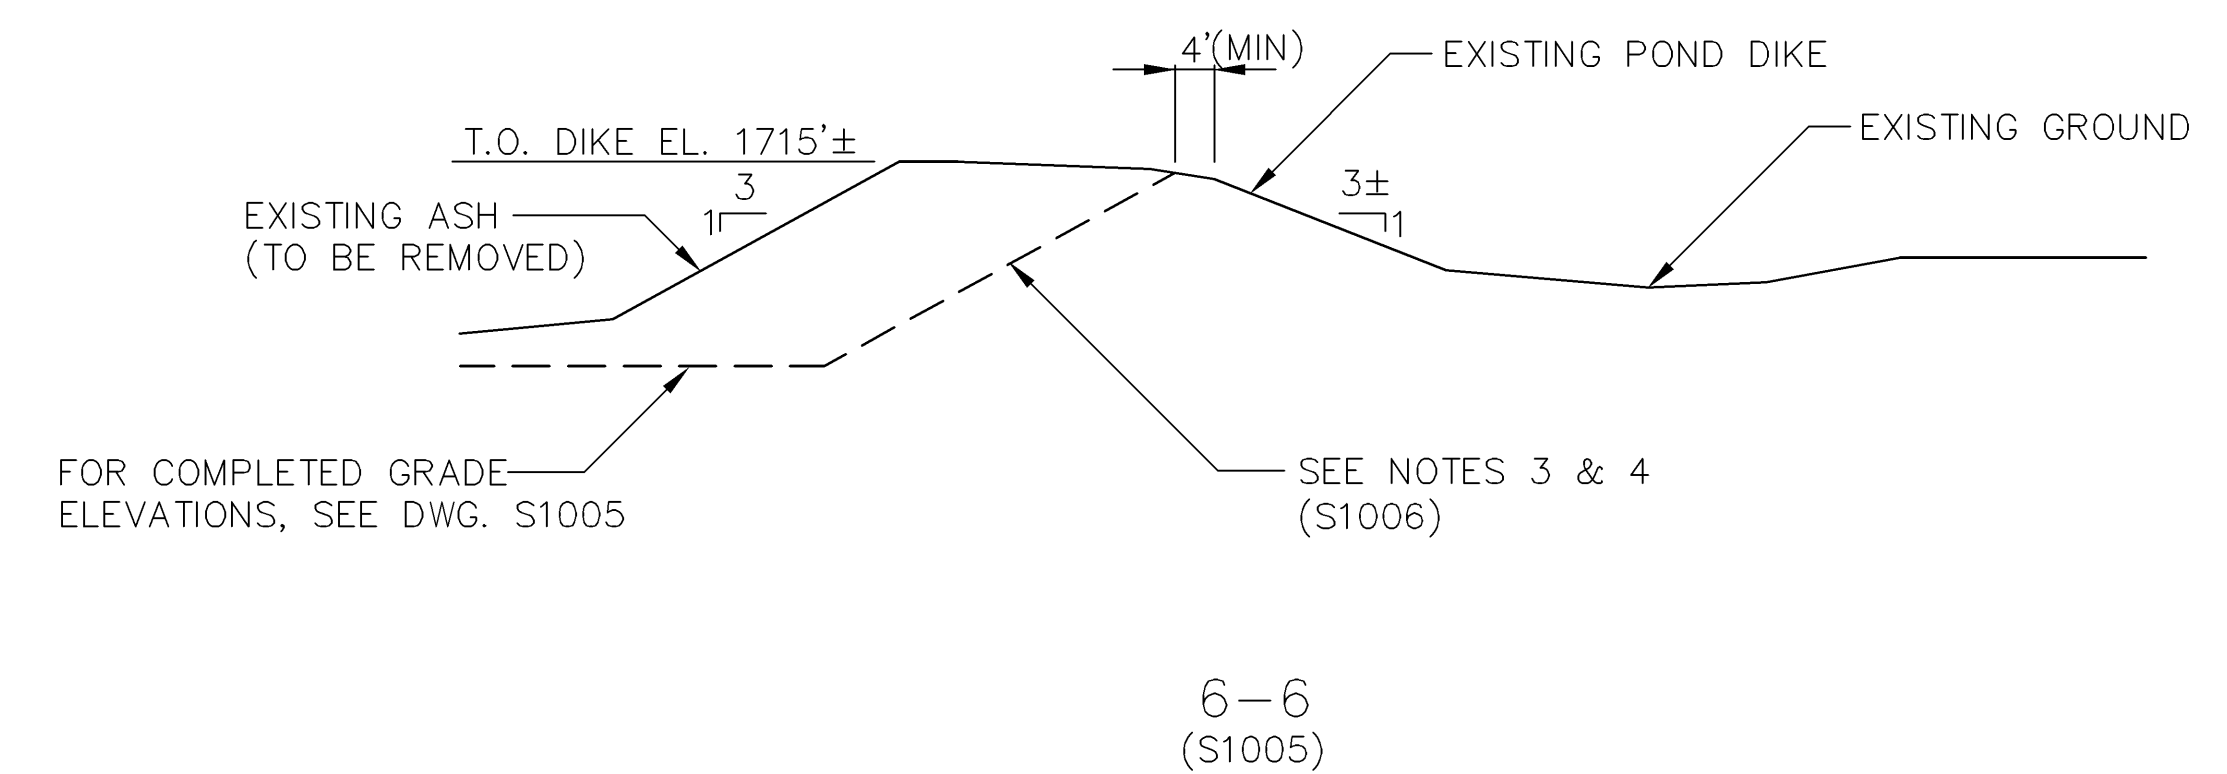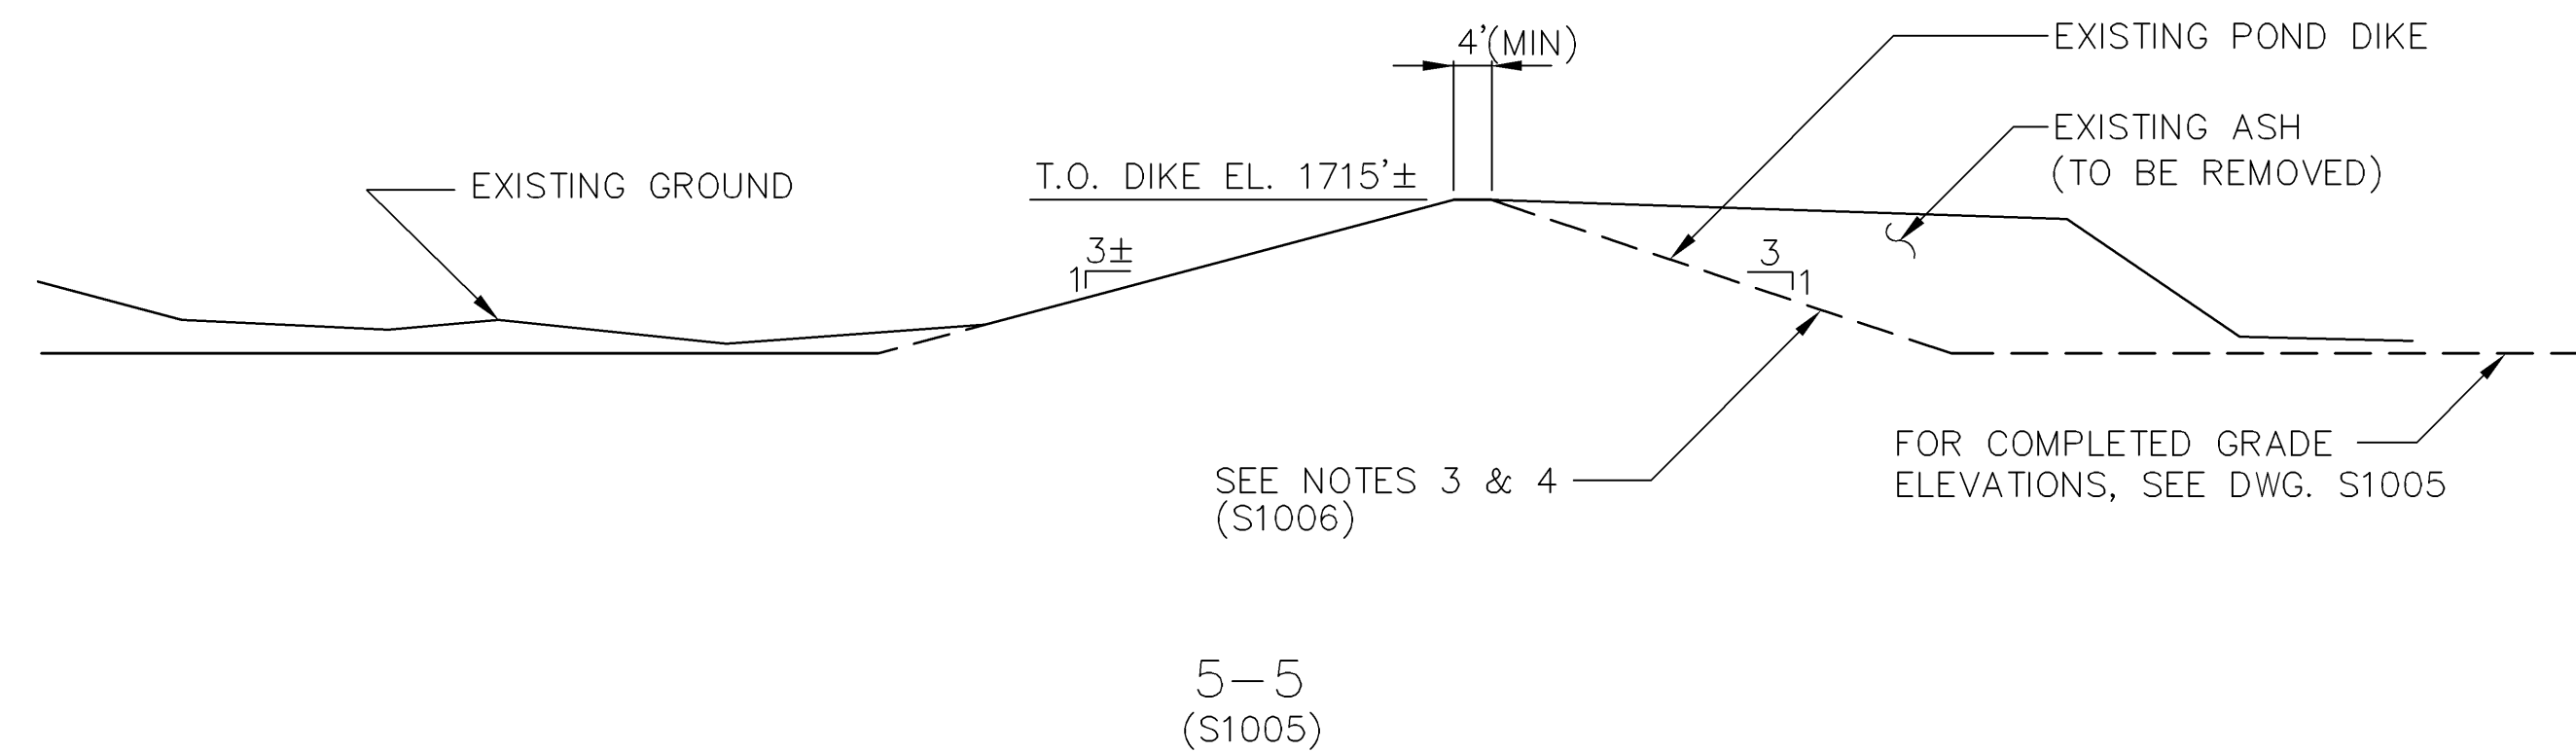

NOTES:


1. SCALE: 1" = 20' UNLESS NOTED.
2. SEE GENERAL NOTES, DRAWING S1002.
3. FOR ADDITIONAL NOTES, SEE DRAWING S1006.

REFERENCE DRAWINGS:

S1002	FACILITIES SITE PLAN
S1005	POND A CONVERSION PLAN
S1006	POND A SECTIONS & DETAILS - SH. 1
S1008	POND A SECTIONS & DETAILS - SH. 3

3																																	2																																	1	FOR CONSTRUCTION																																0	ORIGINAL ISSUE FOR UPDA REVIEW																WZ																SGG																KWC 4-13-9															
ISSUE		DESCRIPTION																CHKD		CORRECT				APPR DATE		ISSUE		DESCRIPTION																CHKD		CORRECT				APPR DATE		ISSUE		DESCRIPTION																CHKD		CORRECT				APPR DATE		ISSUE		DESCRIPTION																CHKD		CORRECT				APPR DATE																																																													
PC	ARCH	CIVIL	CONC	STL	L&P	INST	MD	P.S.	S.A.	FAC	ELEC	LTO	MATL	PC	ARCH	CIVIL	CONC	STL	L&P	INST	MD	P.S.	S.A.	FAC	ELEC	LTO	MATL	PC	ARCH	CIVIL	CONC	STL	L&P	INST	MD	P.S.	S.A.	FAC	ELEC	LTO	MATL	PC	ARCH	CIVIL	CONC	STL	L&P	INST	MD	P.S.	S.A.	FAC	ELEC	LTO	MATL	PC	ARCH	CIVIL	CONC	STL	L&P	INST	MD	P.S.	S.A.	FAC	ELEC	LTO	MATL																																																																																														


UPA PROJECT	UNITED POWER ASSOCIATION STANTON STATION ASH POND MODIFICATIONS	DRAWING NO.	REV 1
	4177	S1007	
POND A SECTIONS & DETAILS – SH. 2			
 <b>STONE &amp; WEBSTER ENGINEERING CORPORATION</b> DENVER, CO.			

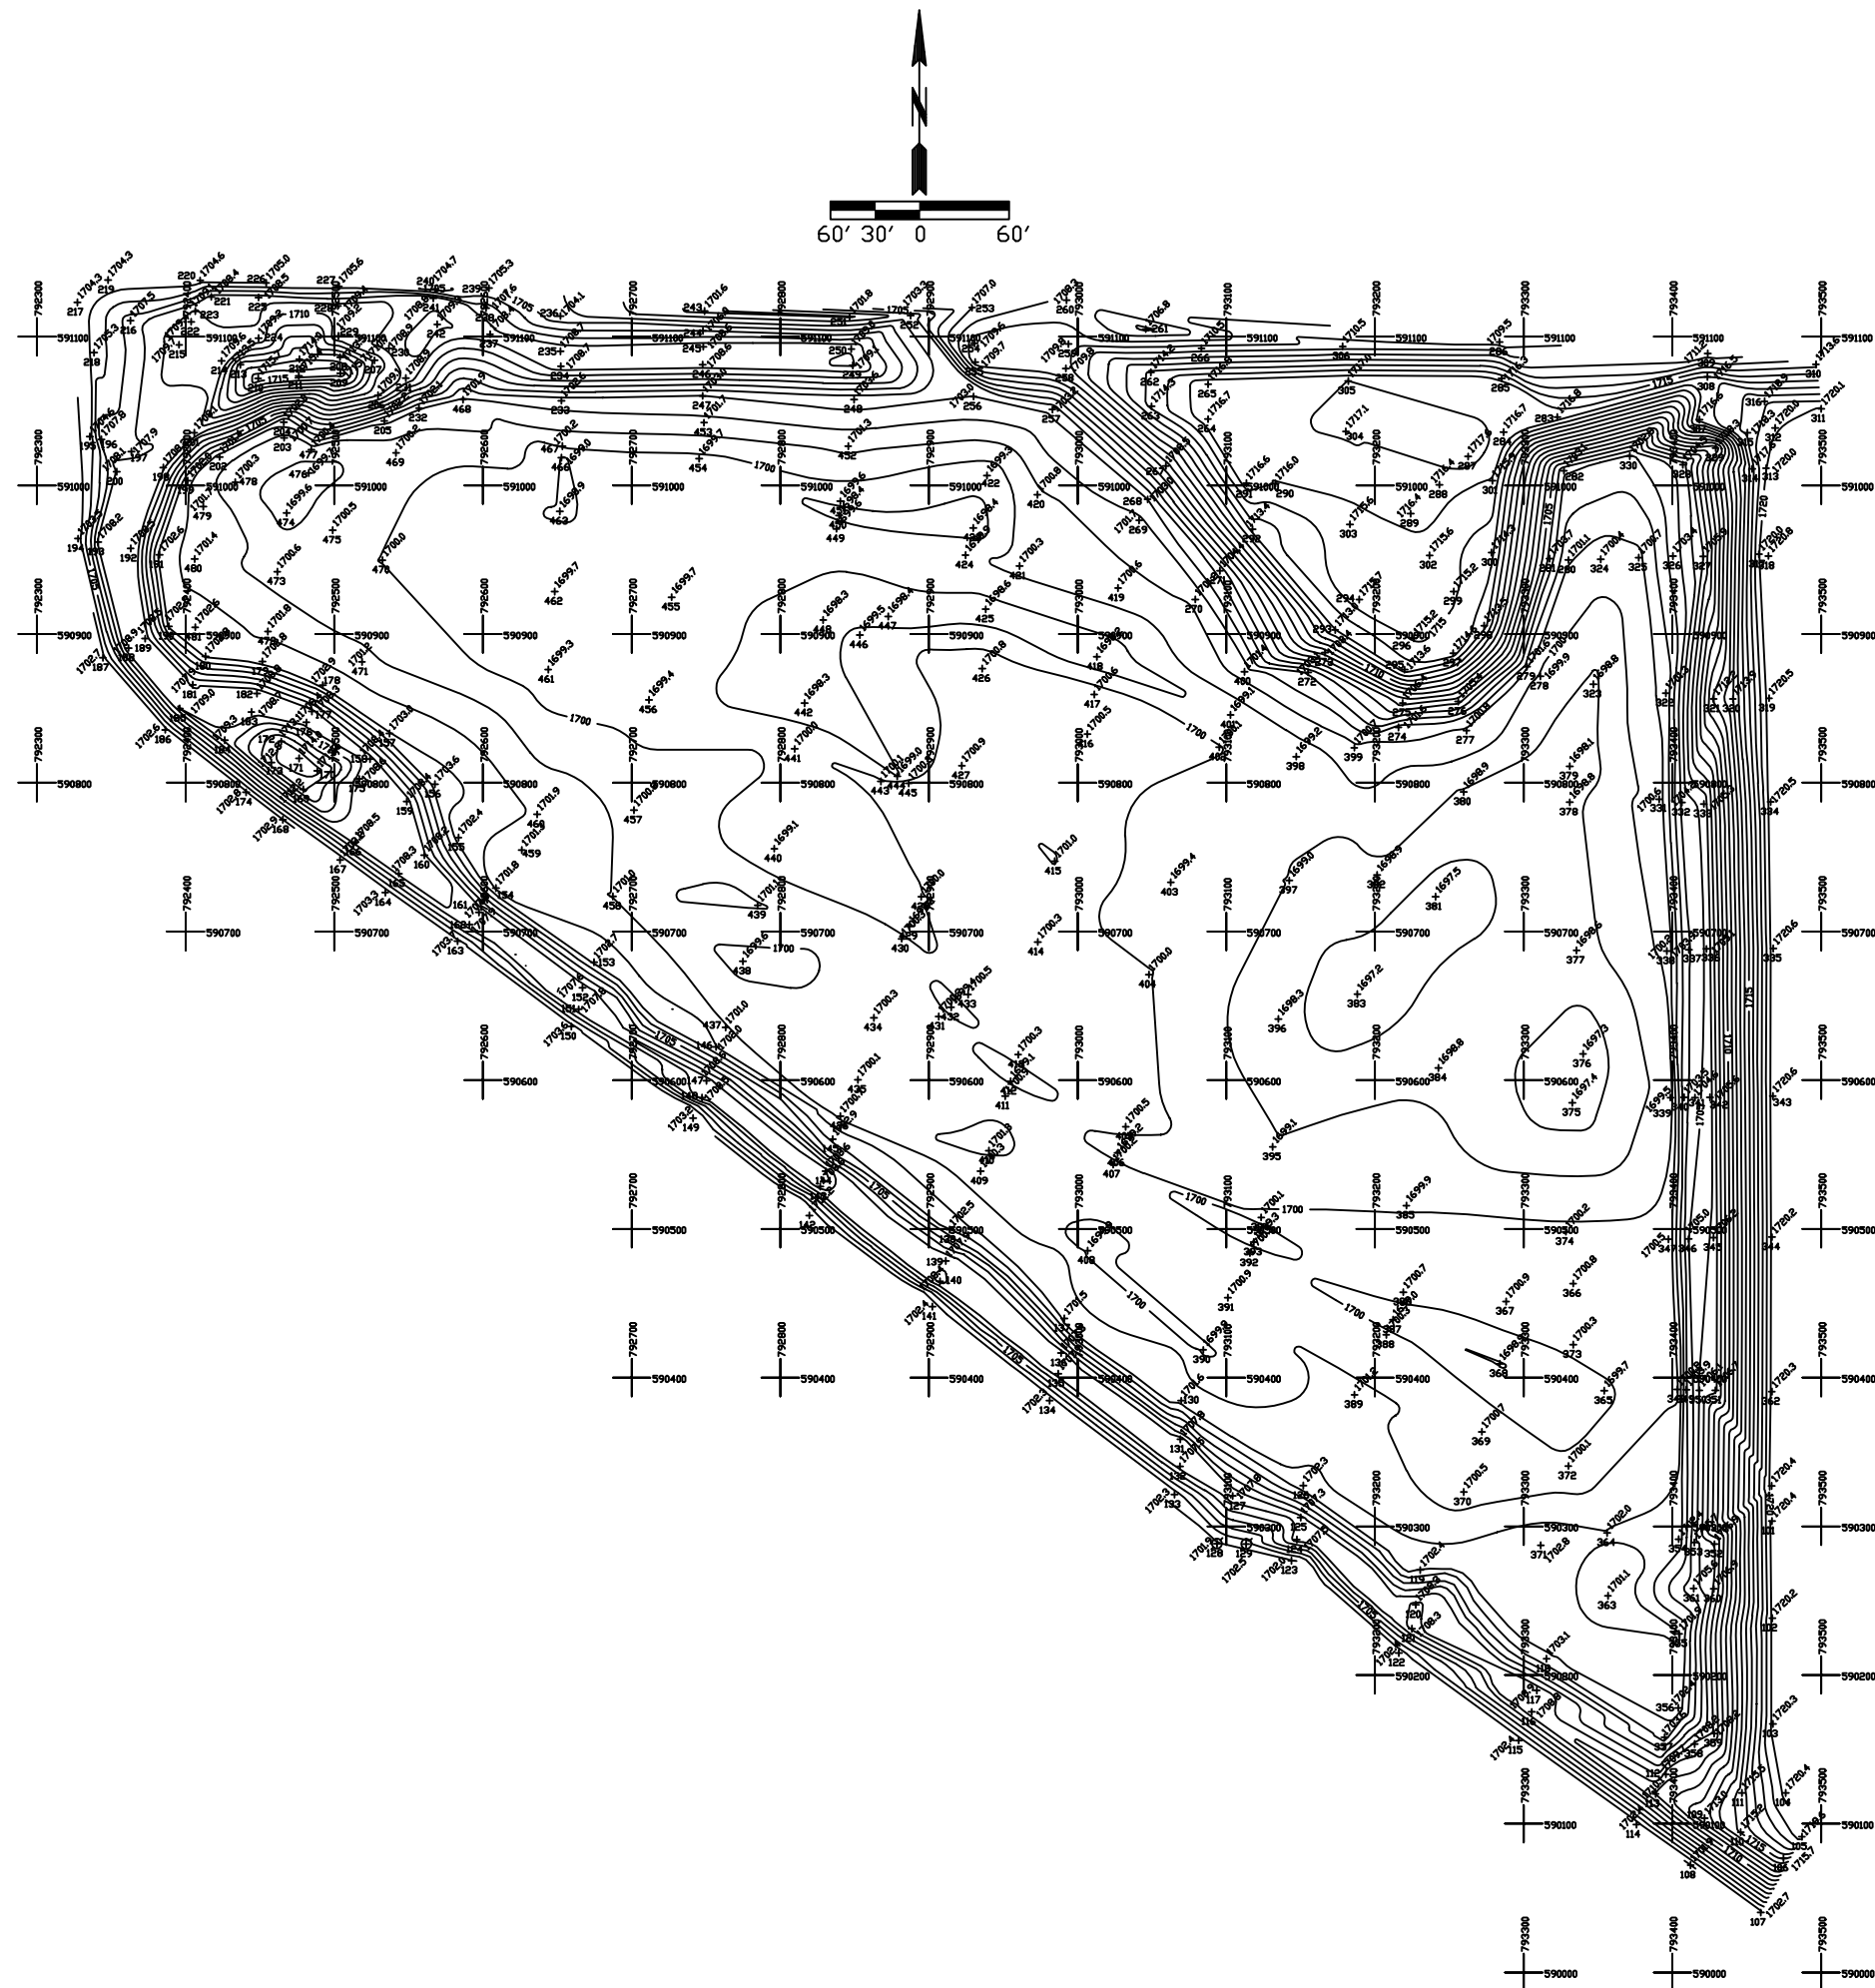


AS CONSTRUCTED POND A

DATE: 10/27/97			
PROJECT: UPA ASH POND MODIFICATIONS			
LOCATION: STANTON, NORTH DAKOTA			
DRAWN BY: A.W.E.			
SCALE: AS SHOWN			
PROJECT NO. 97866			
CHECKED BY:			
DATE: 13 NOV. 1997			
APPROVED BY:			
SHEET 1 of 1			


ULTEIG ENGINEERS, INC. CONSULTING ENGINEERS  
FARGO • BISMARCK • MINNEAPOLIS



FIELD SURVEYED 27 OCT. 1997

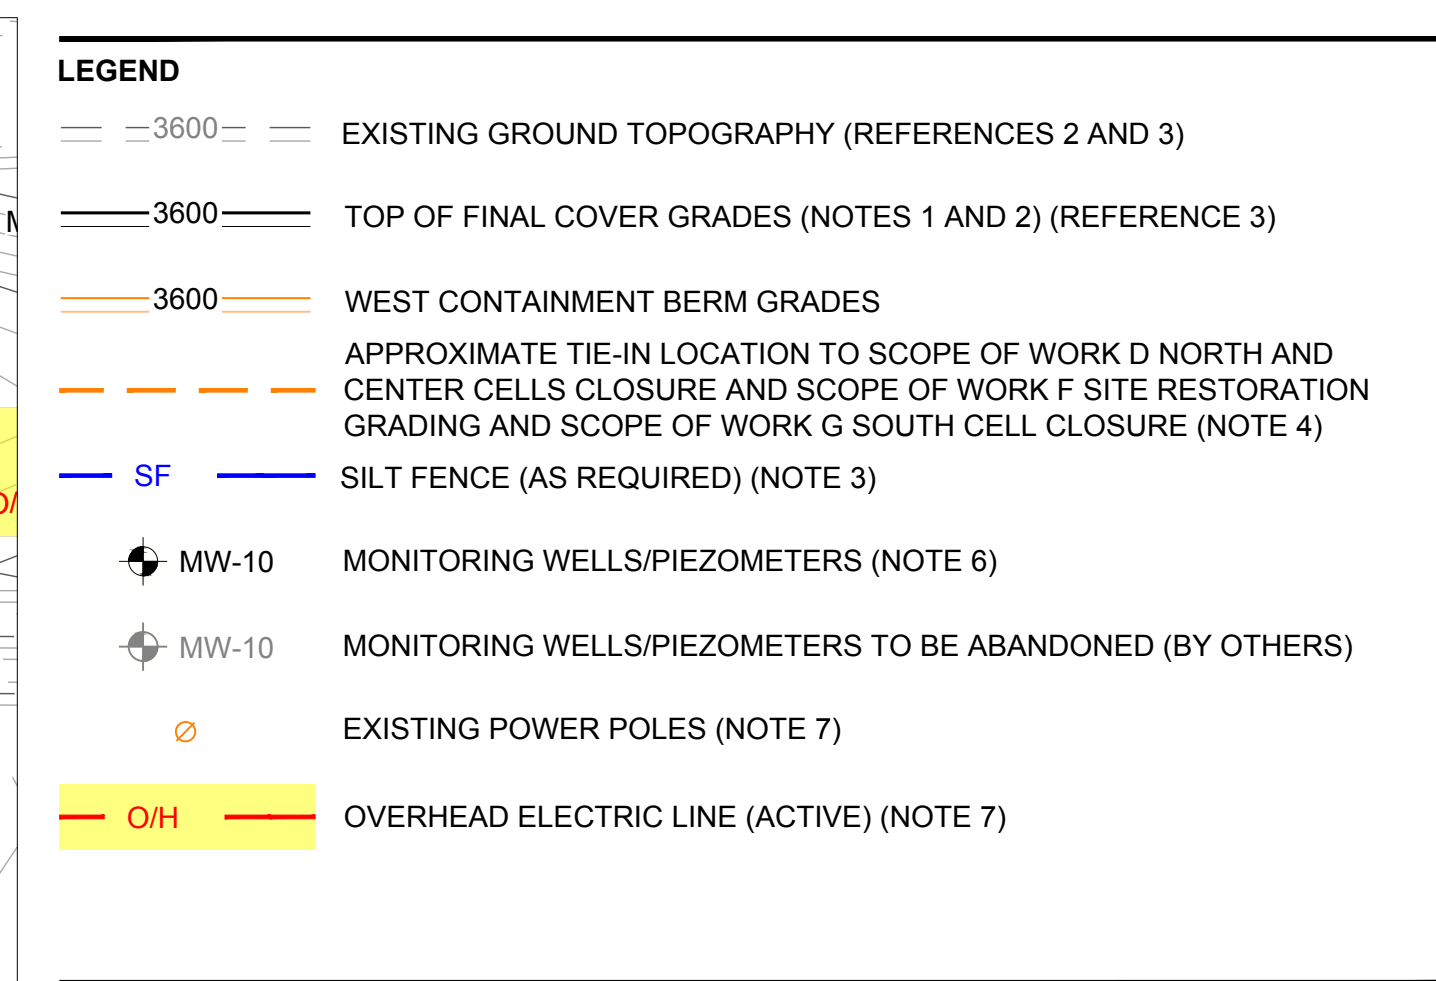

- REFERENCE(S)**
1. SITE LOCATION: T144N, R84W, MERCER COUNTY, NORTH DAKOTA.
  2. EXISTING GROUND TOPOGRAPHY IS FROM AN AERIAL SURVEY PERFORMED BY KBM, INC. ON APRIL 27, 2001 (SITE WIDE), A GROUND SURVEY PERFORMED BY INTERSTATE ENGINEERING IN 2014 (BOTTOM ASH IMPOUNDMENT AND LANDFILL AREA), A GROUND SURVEY PERFORMED BY INTERSTATE ENGINEERING IN 2017 (COAL PILE AREA), AND A GROUND SURVEY PERFORMED BY INTERSTATE ENGINEERING IN 2018.
  3. EXISTING GROUND TOPOGRAPHY AND TOP OF FINAL COVER CONTOUR INTERVAL IS ONE (1) FOOT.

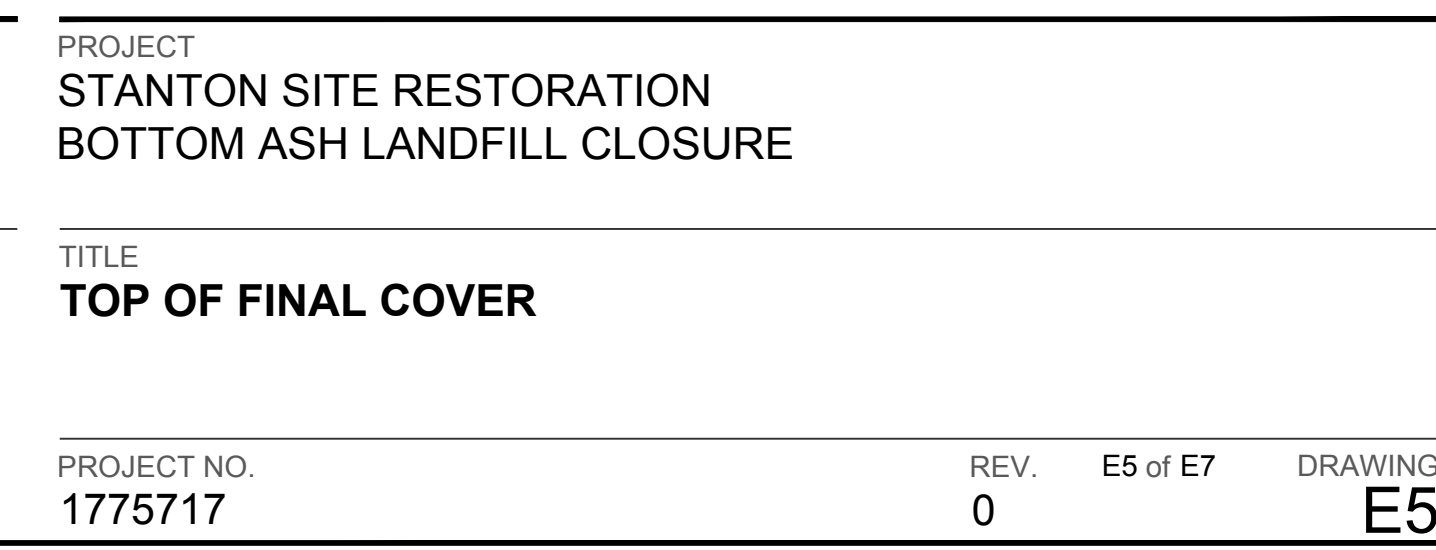


0	2019-07-19	ISSUED FOR CONSTRUCTION	CCS	CCS	RFS	TJS
REV.	YYYY-MM-DD	DESCRIPTION	DESIGNED	PREPARED	REVIEWED	APPROVED

CLIENT

**GREAT RIVER ENERGY**  
**STANTON STATION**  
**STANTON, NORTH DAKOTA**

---

CONSULTANT

 **GOLDER**

**GOLDER ASSOCIATES INC.**  
**7245 W ALASKA DR., SUITE 200**  
**LAKEWOOD, COLORADO**  
**USA**  
**(303) 980-0540**  
**[www.golder.com](http://www.golder.com)**

PROJECT  
**STANTON SITE RESTORATION  
 BOTTOM ASH LANDFILL CLOSURE**


---

TITLE  
**TOP OF FINAL COVER**


---

PROJECT NO.	REV.	E5 of E7	DRAWING
1775717	0		<b>E5</b>



Path: U:\power\greatRIVER ENERGY\STANTON\99\_PROJECTS\177517\SITE RESTORATION\1\_E - Bottom Ash Landfill Closure\02\_PRODUCTION\DWG3 | File Name: 1694164406.dwg | Last Edited By: bpuccell Date: 2019-07-16 Time: 10:53:13 AM | Printed By: bpuccell Date: 2019-07-16 Time: 11:51:53 AM

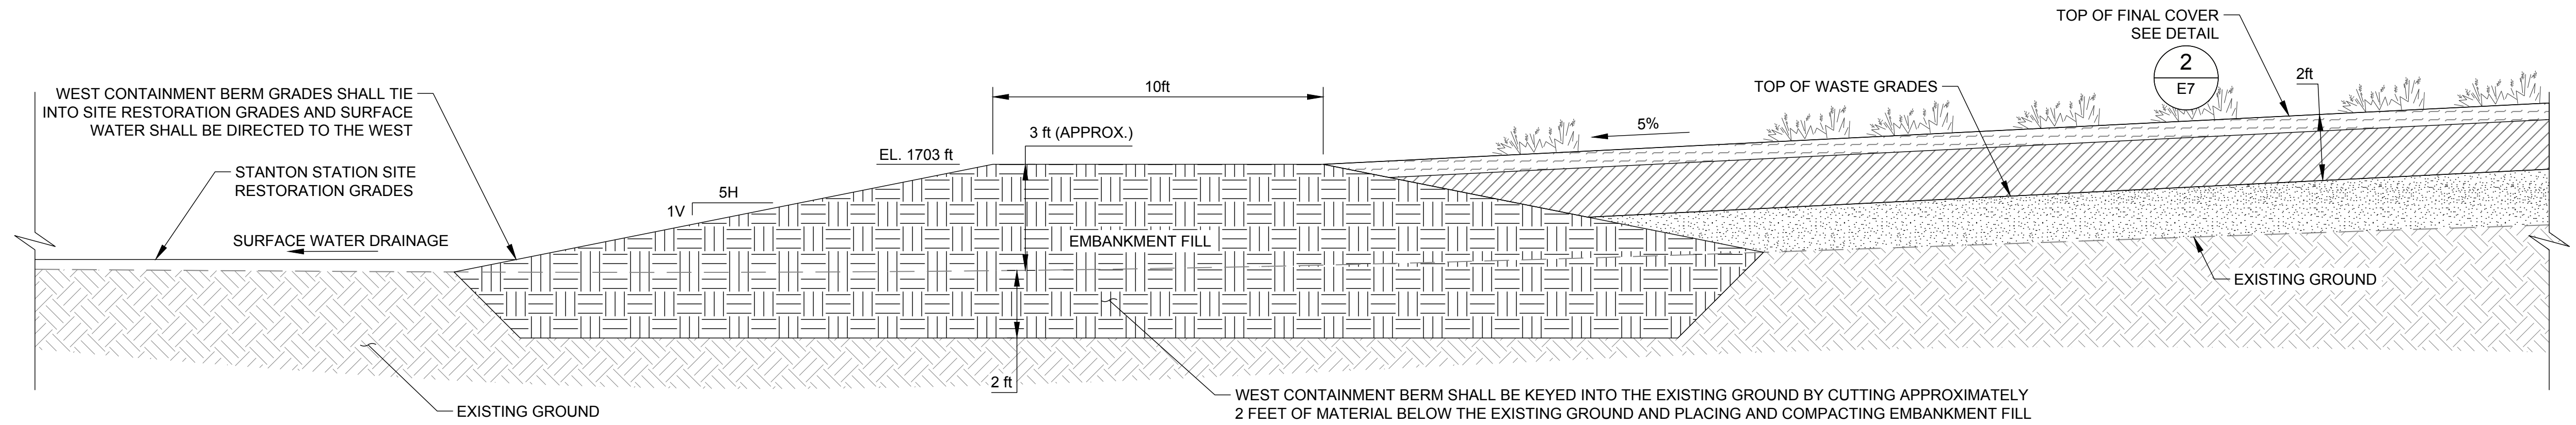

NTS **1**  
E7 **WEST CONTAINMENT BERM DETAIL**

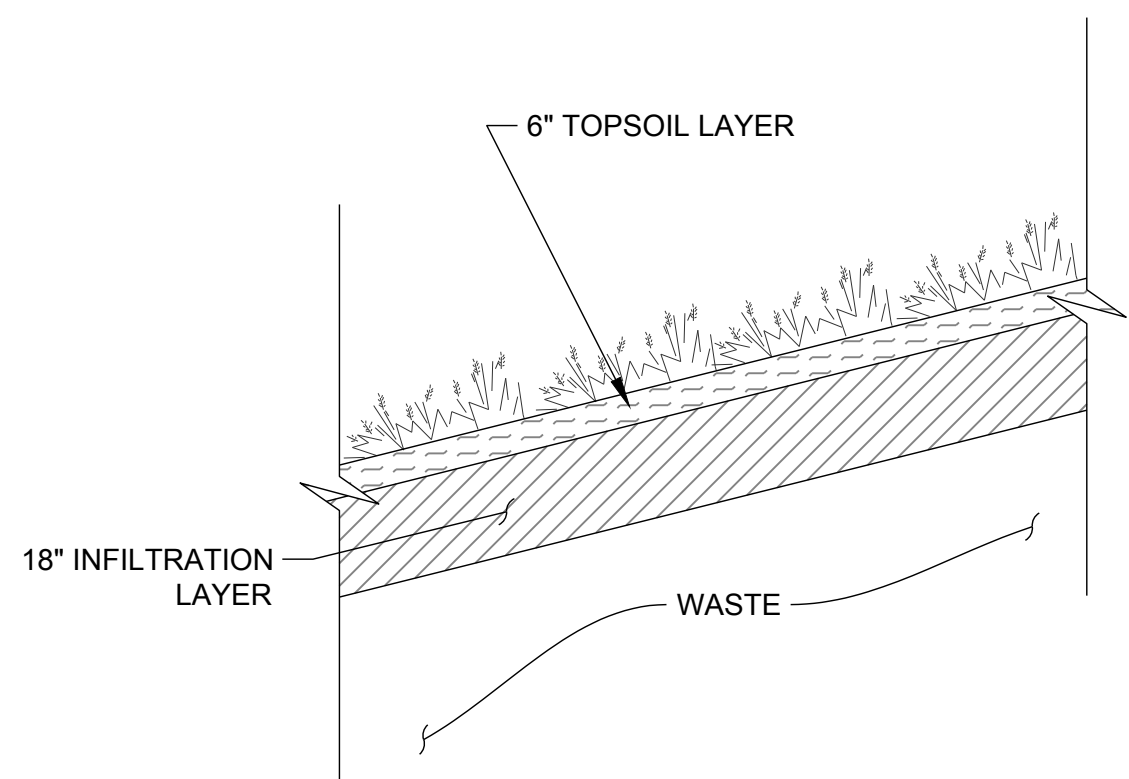


NTS **2**  
E7 **FINAL COVER DETAIL**

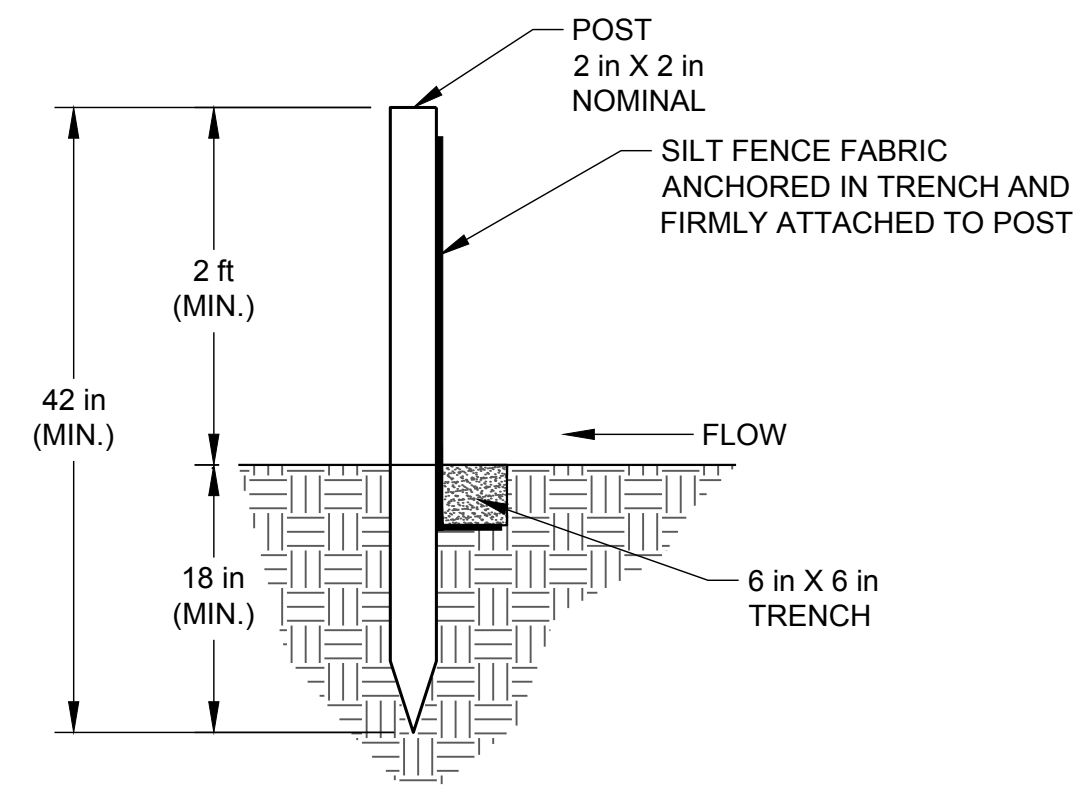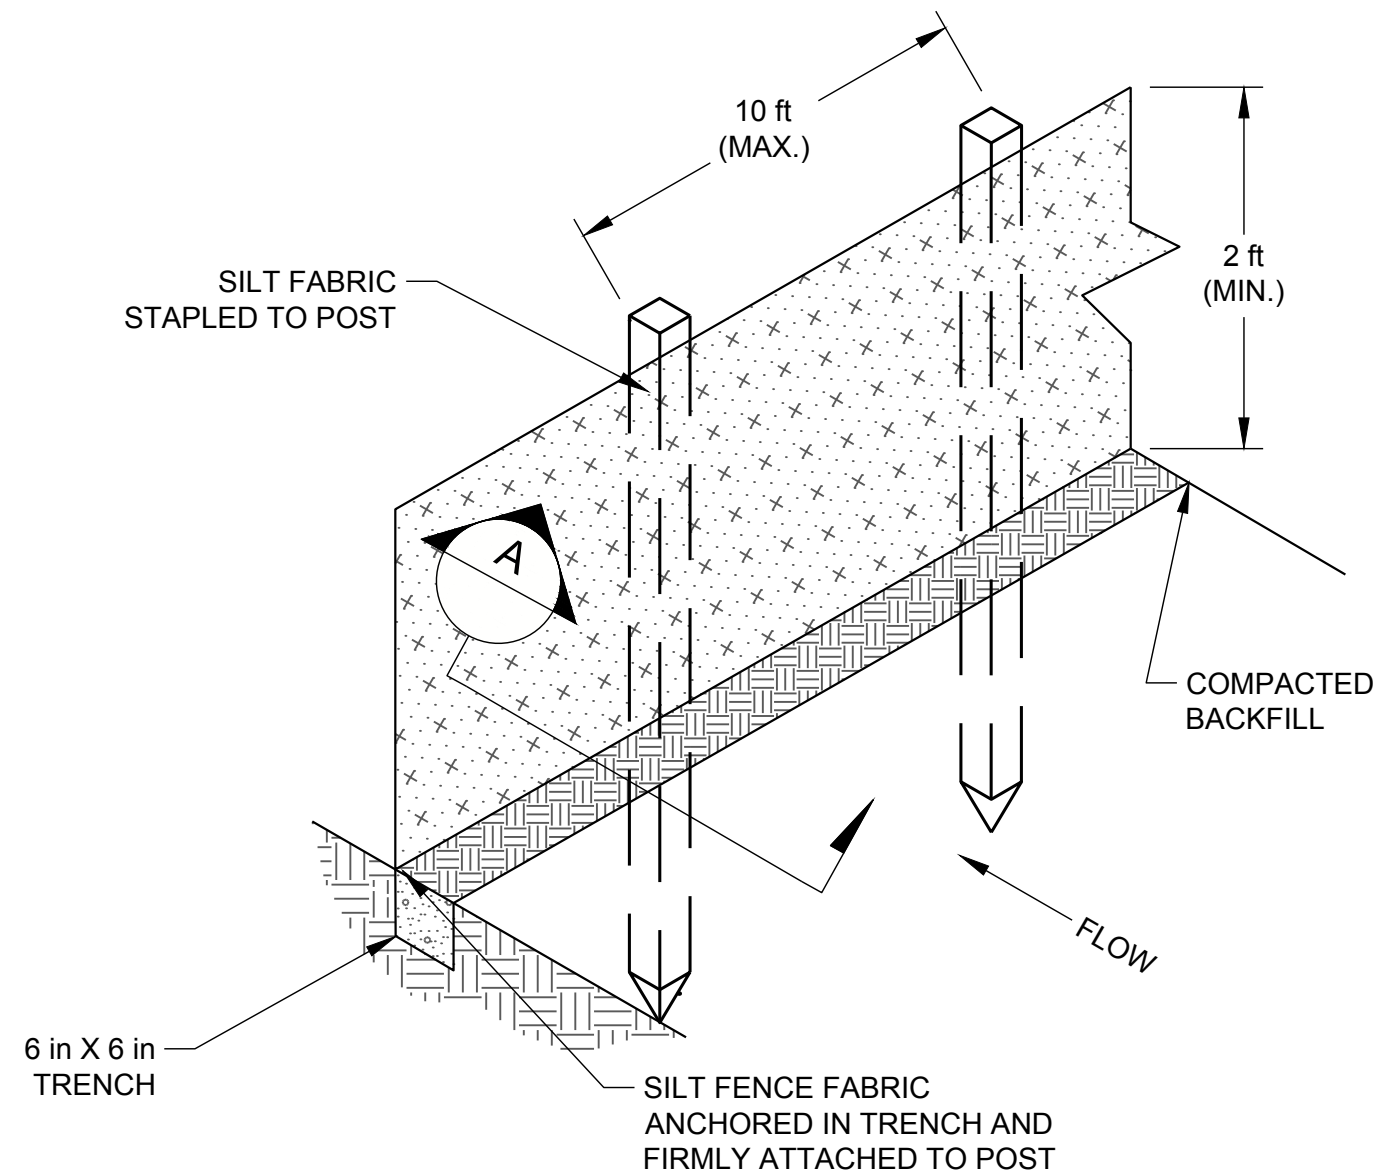


**SECTION A**

NTS **3**  
E7 **SILT FENCE DETAIL**

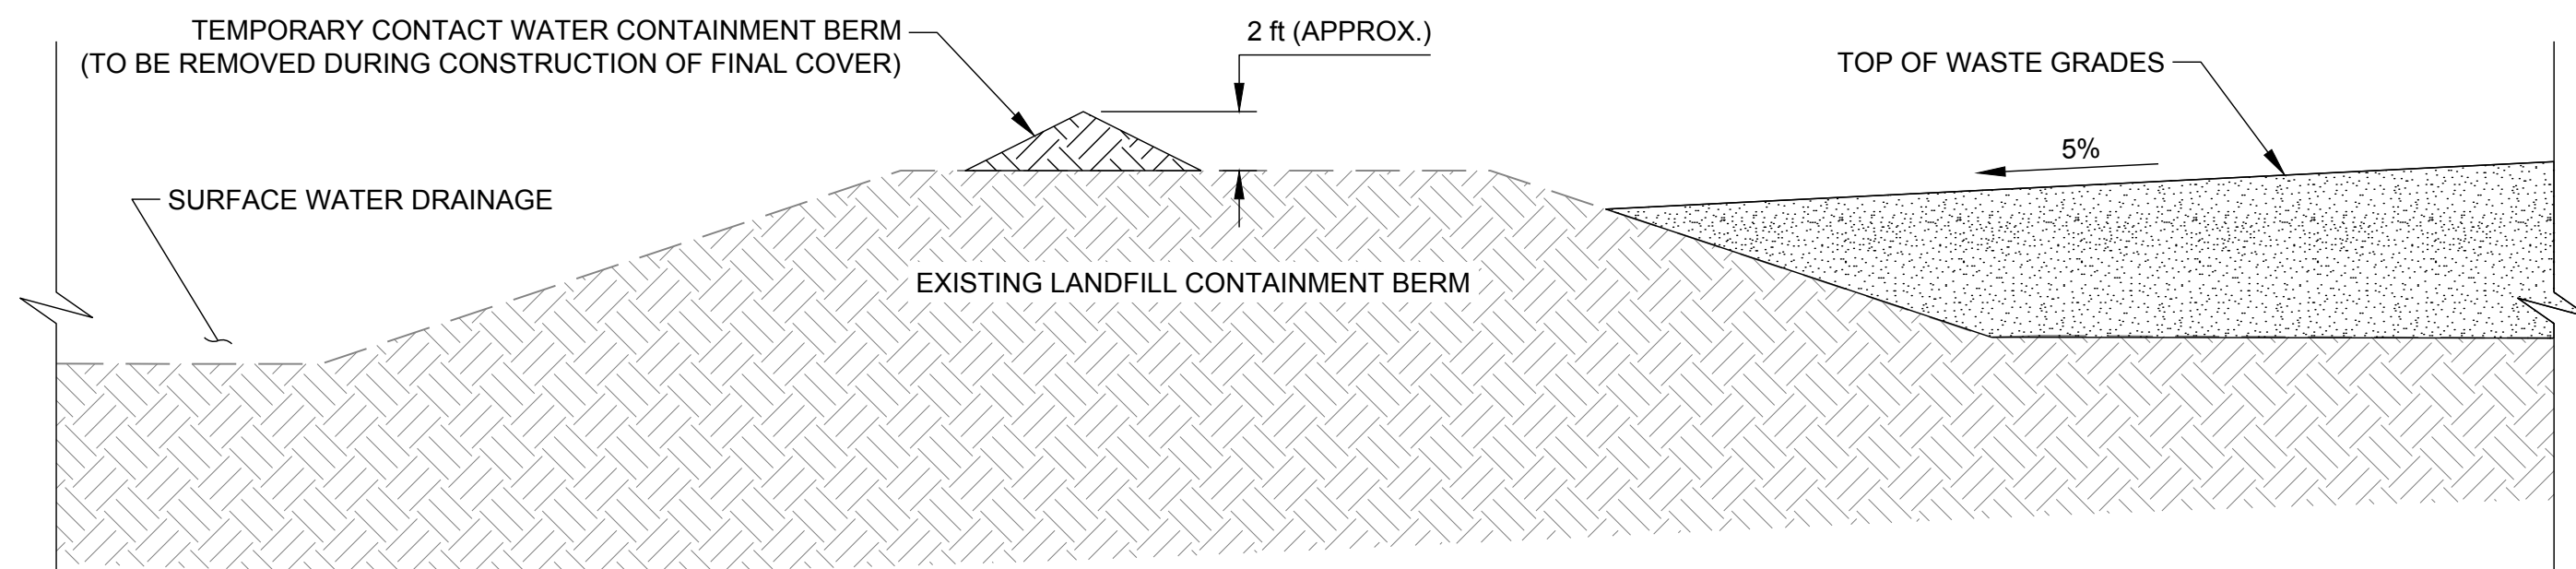

NTS **4**  
E7 **TEMPORARY CONTACT WATER BERM**

SEAL

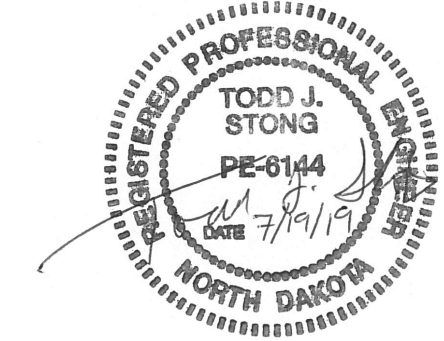

CLIENT  
GREAT RIVER ENERGY  
STANTON STATION  
STANTON, NORTH DAKOTA  
CONSULTANT



GOLDER ASSOCIATES INC.  
7245 W ALASKA DR., SUITE 200  
LAKEWOOD, COLORADO  
USA  
(303) 980-0540  
www.golder.com

PROJECT  
STANTON SITE RESTORATION  
BOTTOM ASH LANDFILL CLOSURE

TITLE  
**DETAILS**

PROJECT NO.  
**1775717**

REV. **0** E7 of E7

DRAWING  
**E7**

0 2019-07-19 ISSUED FOR CONSTRUCTION

MRS MRS RFS TJS


REV. YYYY-MM-DD DESCRIPTION

DESIGNED PREPARED REVIEWED APPROVED

1 in IF THIS MEASUREMENT DOES NOT MATCH WHAT IS SHOWN, THE SHEET SIZE HAS BEEN MODIFIED FROM: ANSI D



Infiltration layer thickness was verified to be a minimum of 18 inches.

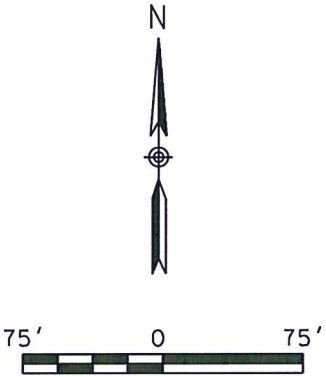


Revision No.		Date	By	Description
Great River Energy - Stanton Station Stanton Site Restoration Stanton, North Dakota				
SOW E - Bottom Ash Landfill - Infiltration Layer As-Built				
Drawn By: Daren Peterka				
Checked By: Daren Peterka				
Project No.: 19-08-027				
Date: September 28, 2020				

Interstate Engineering, Inc.  
P.O. Box 2035  
1903 12th Ave. S.W.  
Jamestown, N.D., 58402-2035  
Ph (701) 252-0234  
Fax (701) 252-0203  
www.interstateeng.com  
Other offices in Minnesota, Montana and South Dakota


**INTERSTATE ENGINEERING**  
Professionals you need, people you trust

1  
SHEET NO.



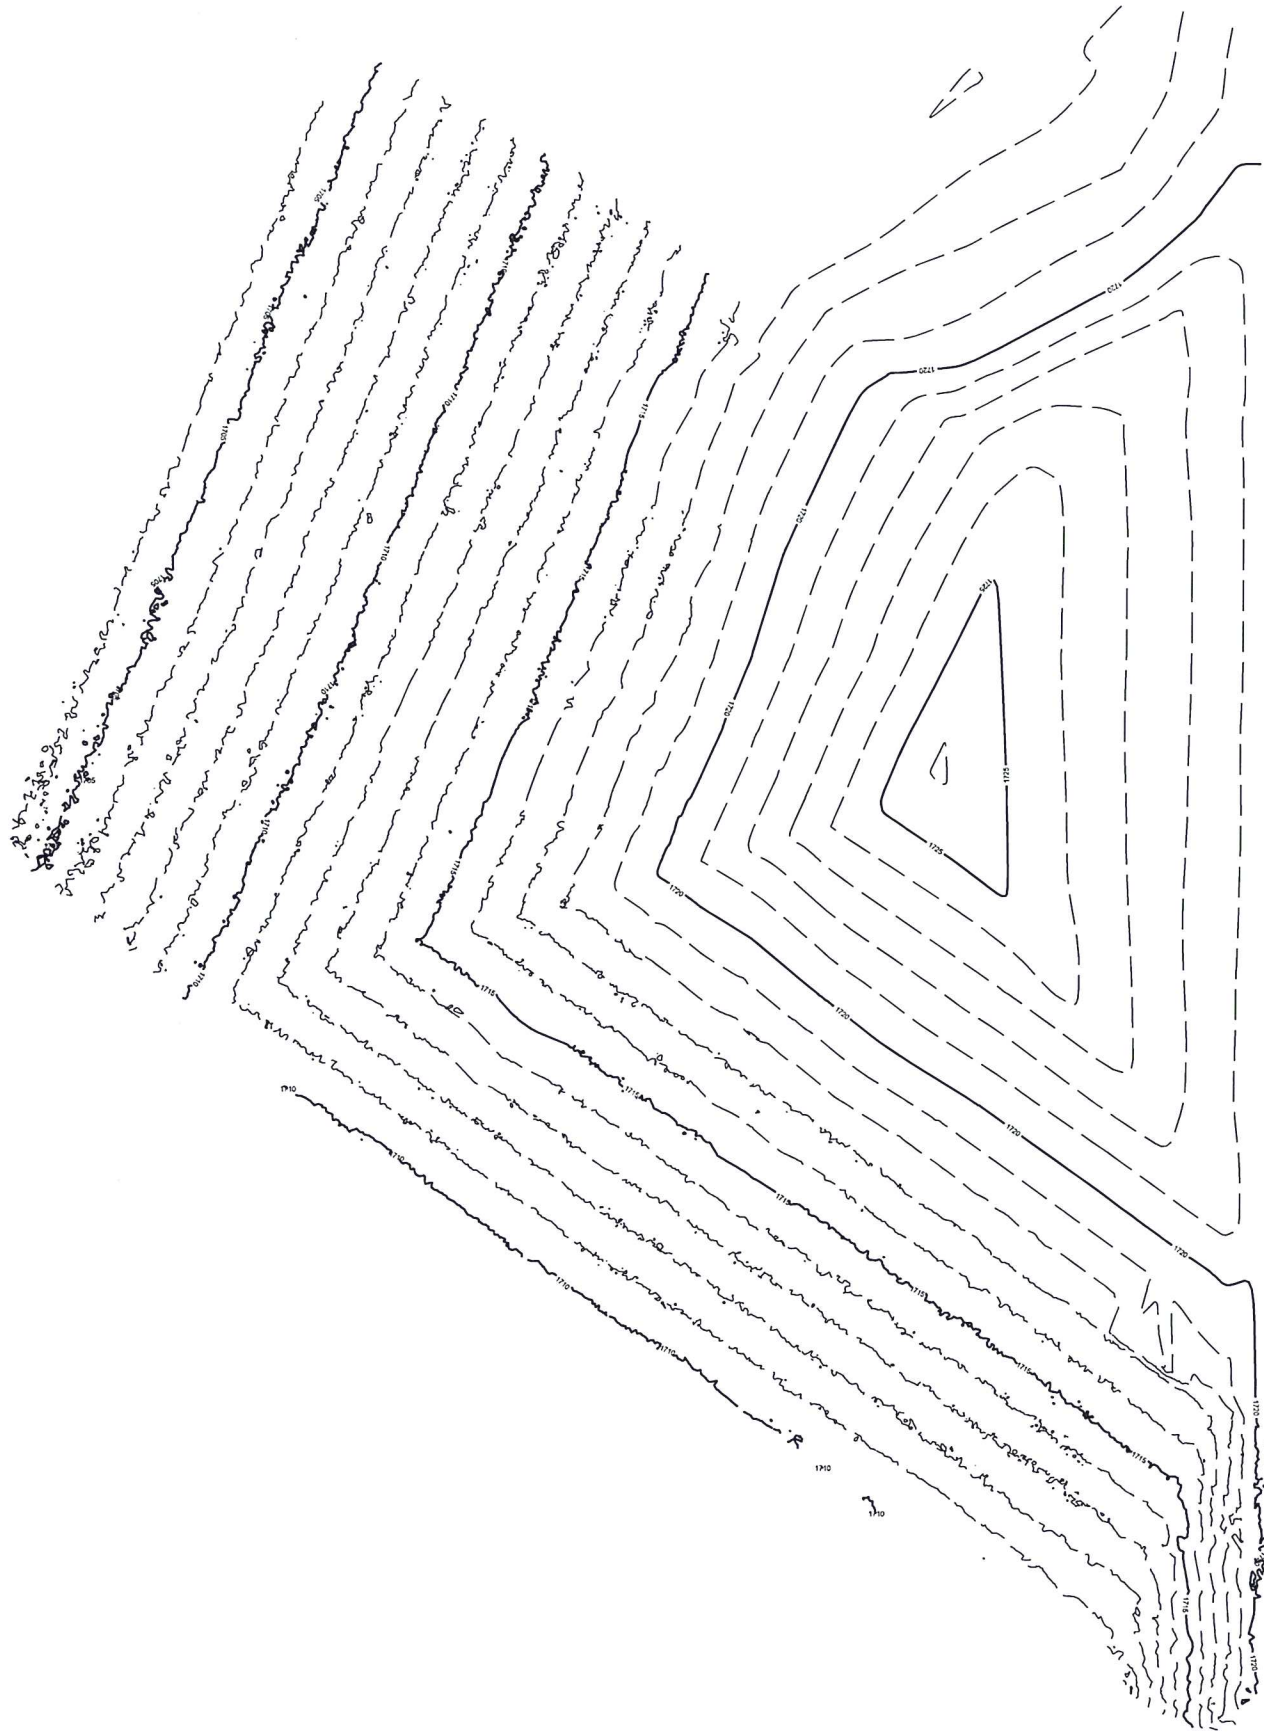


Topsoil thickness was verified  
to be a minimum of 6 inches.

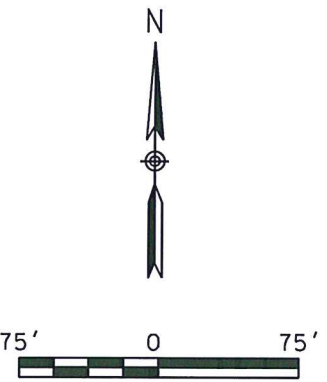

Revision No.	Date	By	Description



Great River Energy - Stanton Station Stanton Site Restoration Stanton, North Dakota	Project No.: 19-08-027
SOW E - Bottom Ash Landfill - Topsoil As-Built	Date: September 28, 2020
Drawn By: Daren Peterka	Checked By: Daren Peterka

Interstate Engineering, Inc.  
P.O. Box 2035  
1903 12th Ave. S.W.  
Jamestown, N.D., 58402-2035  
Ph (701) 252-0234  
Fax (701) 252-0203  
www.interstateeng.com  
Other offices in Minnesota, Montana and South Dakota



**INTERSTATE  
ENGINEERING**

Professionals you need, people you trust

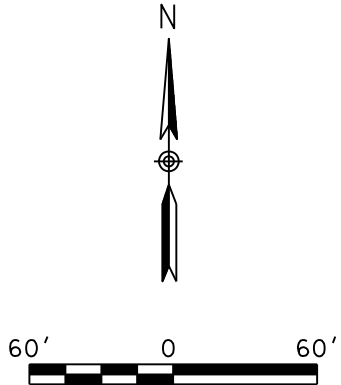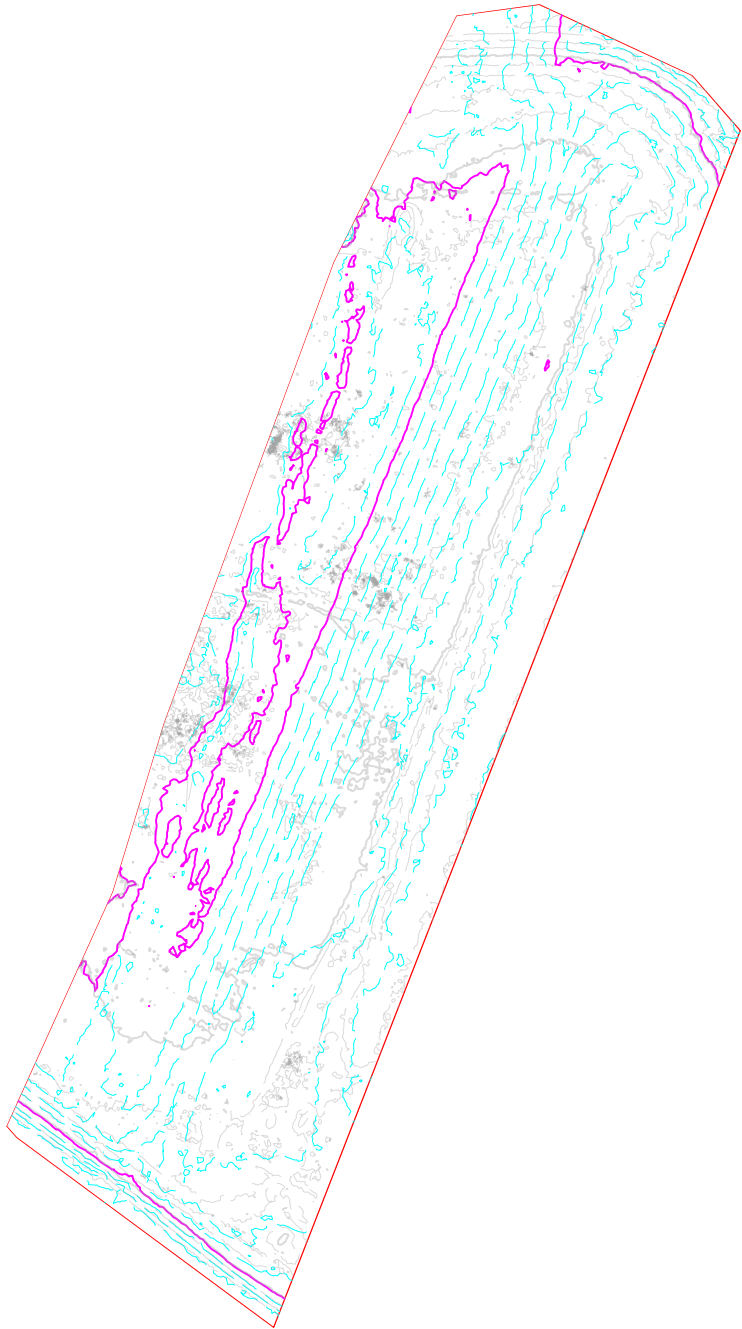


\*\*\*\*\*  
\*\*  
\*\* TIN to TIN Volume Report -- Tue Jul 07 16:53:19 2020  
\*\* From TIN <Berm Orig 2019-10-09.tin> to TIN <Berm Top 2020-05-06.tin>  
\*\* Prismatic Volume  
\*\*  
\*\*  
\*\*\*\*\*  
\*\*  
\*\* Total Cut = 438.423 Cubic Yards  
\*\* Total Fill = 2441.375 Cubic Yards  
\*\* Area = 7886.392 Sq Yards  
\*\* Balance = -2002.952 Cubic Yards  
\*\*  
\*\* Boundary Polygon Used  
\*\*\*\*\*

Revision No.	Date	By	Description

Great River Energy - Stanton Station	
Stanton Site Restoration	
Stanton, North Dakota	
SOW E - Berm Quantity	
Drawn By: Daren Peterka	Project No.: 19-08-027
Checked By: Daren Peterka	Date: July 8, 2020

Interstate Engineering, Inc.  
P.O. Box 2035  
1903 12th Ave. S.W.  
Jamestown, N.D. 58402-2035  
Ph (701) 252-0234  
Fax (701) 252-0203  
www.interstateeng.com  
Other offices in Minnesota, Montana and South Dakota



INTERSTATE  
ENGINEERING

Professionals you need, people you trust

**APPENDIX B**

## Visual Observations Checklist

## INSPECTION CHECKLIST

<b>Facility Name:</b> Bottom Ash Landfill		
<b>Owner and Address:</b> Great River Energy – Stanton Station		
<b>Purpose of Facility:</b> CCR Storage and Disposal		
<b>Legal:</b> Section 21	<b>Township:</b> 144N	<b>Range:</b> 84W
<b>County:</b> Mercer		
<b>Inspected By:</b> Craig Schuettpelez, PE		<b>Inspection Date:</b> July 21, 2020
<b>Weather:</b> Sunny, 70-80°F, low wind, no precipitation		

ITEM	Y	N	N/A	REMARKS
<b>1. CCR Placement</b> ( <i>Landfill closed, no CCR placement or exposed CCR</i> )				
a. Significant erosion			X	
b. Cracking/settlement			X	
c. Seepage			X	
<b>2. Final Cover Area</b>				
a. Erosion/liner exposed		X		
b. Rodent burrows		X		
c. Vegetation	X			Recently seeded and mulched, Some grass on east and north slopes as of October 2020
d. Cracks/settlement		X		
<b>3. Perimeter Berm Crest</b>				
a. Soil condition	X			Gravel and soil road on north and east sides
b. Compared to design width	X			
c. Vegetation		X		West and south sides recently seeded and mulched
d. Rodent burrows		X		
e. Exposed to heavy traffic	X			During closure
f. Damage from vehicles/equipment		X		
<b>4. Downstream Slope</b>				
a. Erosion	X			Minor erosion on west slope
b. Vegetation	X			Most of south side is well-vegetated; northwest, west, southwest sides have been recently seeded as a part of site restoration activities
c. Rodent burrows	X			Few 2" to 4" animal burrows along south slope
d. Cracks/settlement/scarps		X		
e. Seepage		X		
<b>5. Toe</b>				
a. Vegetation	X			
b. Rodent burrows	X			Few 2" to 4" animal burrows along south slope toe
c. Settlement		X		
d. Drainage conditions	X			Good condition drainage ditch on south side and restoration grading draining away from facility on other sides
e. Seepage		X		


**General Remarks:** Site was consolidated, re-graded, and closed as a part of site restoration activities; minor ongoing maintenance may include control/repair of burrows, establishing vegetation, removal of woody vegetation; no sign of instability.

**Name of Engineer (Engineer Firm):**

Craig Schuettpelez, PE (Golder Associates, Inc.)

**Date:** July 21, 2020

**Signature:**

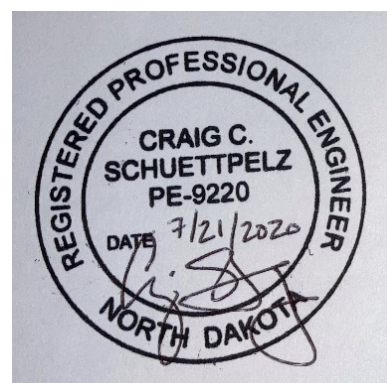**APPENDIX C**

**Photographs**



#### LEGEND

- ① PHOTOGRAPH NUMBER AND LOCATION

#### REFERENCE(S)

1. AERIAL IMAGE FROM UNITED STATES DEPARTMENT OF AGRICULTURE NATIONAL AGRICULTURE IMAGERY PROGRAM, 2020.

**CCR Bottom Ash Landfill**



Photograph 1 (East Final Cover Slope)  
Bottom ash landfill closed and covered. (IMG\_DSCF1005.JPG)



Photograph 2 (South Perimeter Berm Toe)  
Vegetation in surface water drainage ditch. (IMG\_DSCF1024.JPG)

CCR Bottom Ash Landfill



Photograph 3 (South Perimeter Berm Downstream Slope)  
Small rodent burrows on the slope and near the toe of the facility. (IMG\_DSCF1011.JPG)



Photograph 4 (South Perimeter Berm Downstream Slope)  
Minor erosion and bare vegetation on the southern downstream slope. (IMG\_DSCF1014.JPG)

CCR Bottom Ash Landfill



Photograph 5 (West Perimeter Berm Downstream Slope and Toe)  
Recently seeded and mulched downstream slope/toe and final cover (background). (IMG\_DSCF1039.JPG)




Photograph 6 (North Perimeter Berm Downstream Slope and Toe)  
Well vegetated perimeter berm downstream slope and recently seeded and mulched toe.  
(IMG\_DSCF1041.JPG)

CCR Bottom Ash Landfill



Photograph 7 (Final Cover)  
Recently seeded and mulched final cover. (IMG\_DSCF1048.JPG)

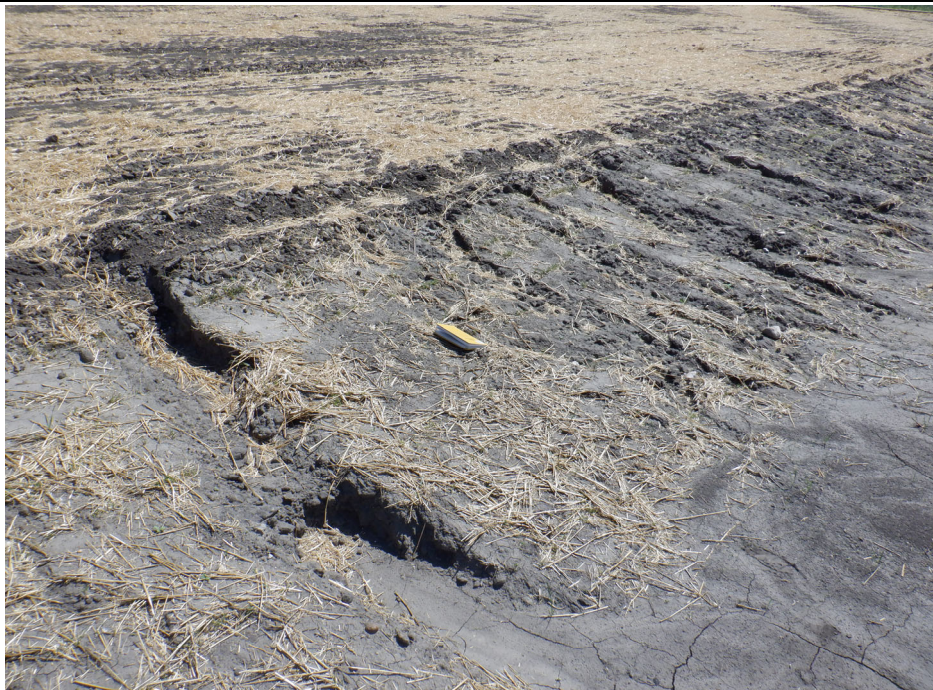

Photograph 8 (West Perimeter Berm Downstream Slope)  
Minor erosion of recently seeded and mulched perimeter berm downstream slope. (IMG\_DSCF1038.JPG)

**CCR Bottom Ash Landfill**



Photograph 9 (East Perimeter Berm Downstream Slope and Toe)  
Recently seeded and mulched area (vegetation beginning to grow, October 2020). (IMG\_7387.JPG)



Photograph 10 (South Final Cover Slope)  
Recently seeded and mulched area (vegetation beginning to grow, October 2020). (IMG\_7391.JPG)

CCR Bottom Ash Landfill	
	
Photograph 11 (South Final Cover Slope) Recently seeded and mulched area (vegetation beginning to grow, October 2020). (IMG_7399.JPG)	



**[golder.com](http://golder.com)**